


SYNTHI 100

EMS

Electronic Music Studios London Limited,
49 Deodar Road London SW15 2NU
Telephone 01-874 0042/874 2363 Telex 928327
New York: 408 East 78th Street NY 10021 Tel: 212 734 7344
Telex 42 40 33

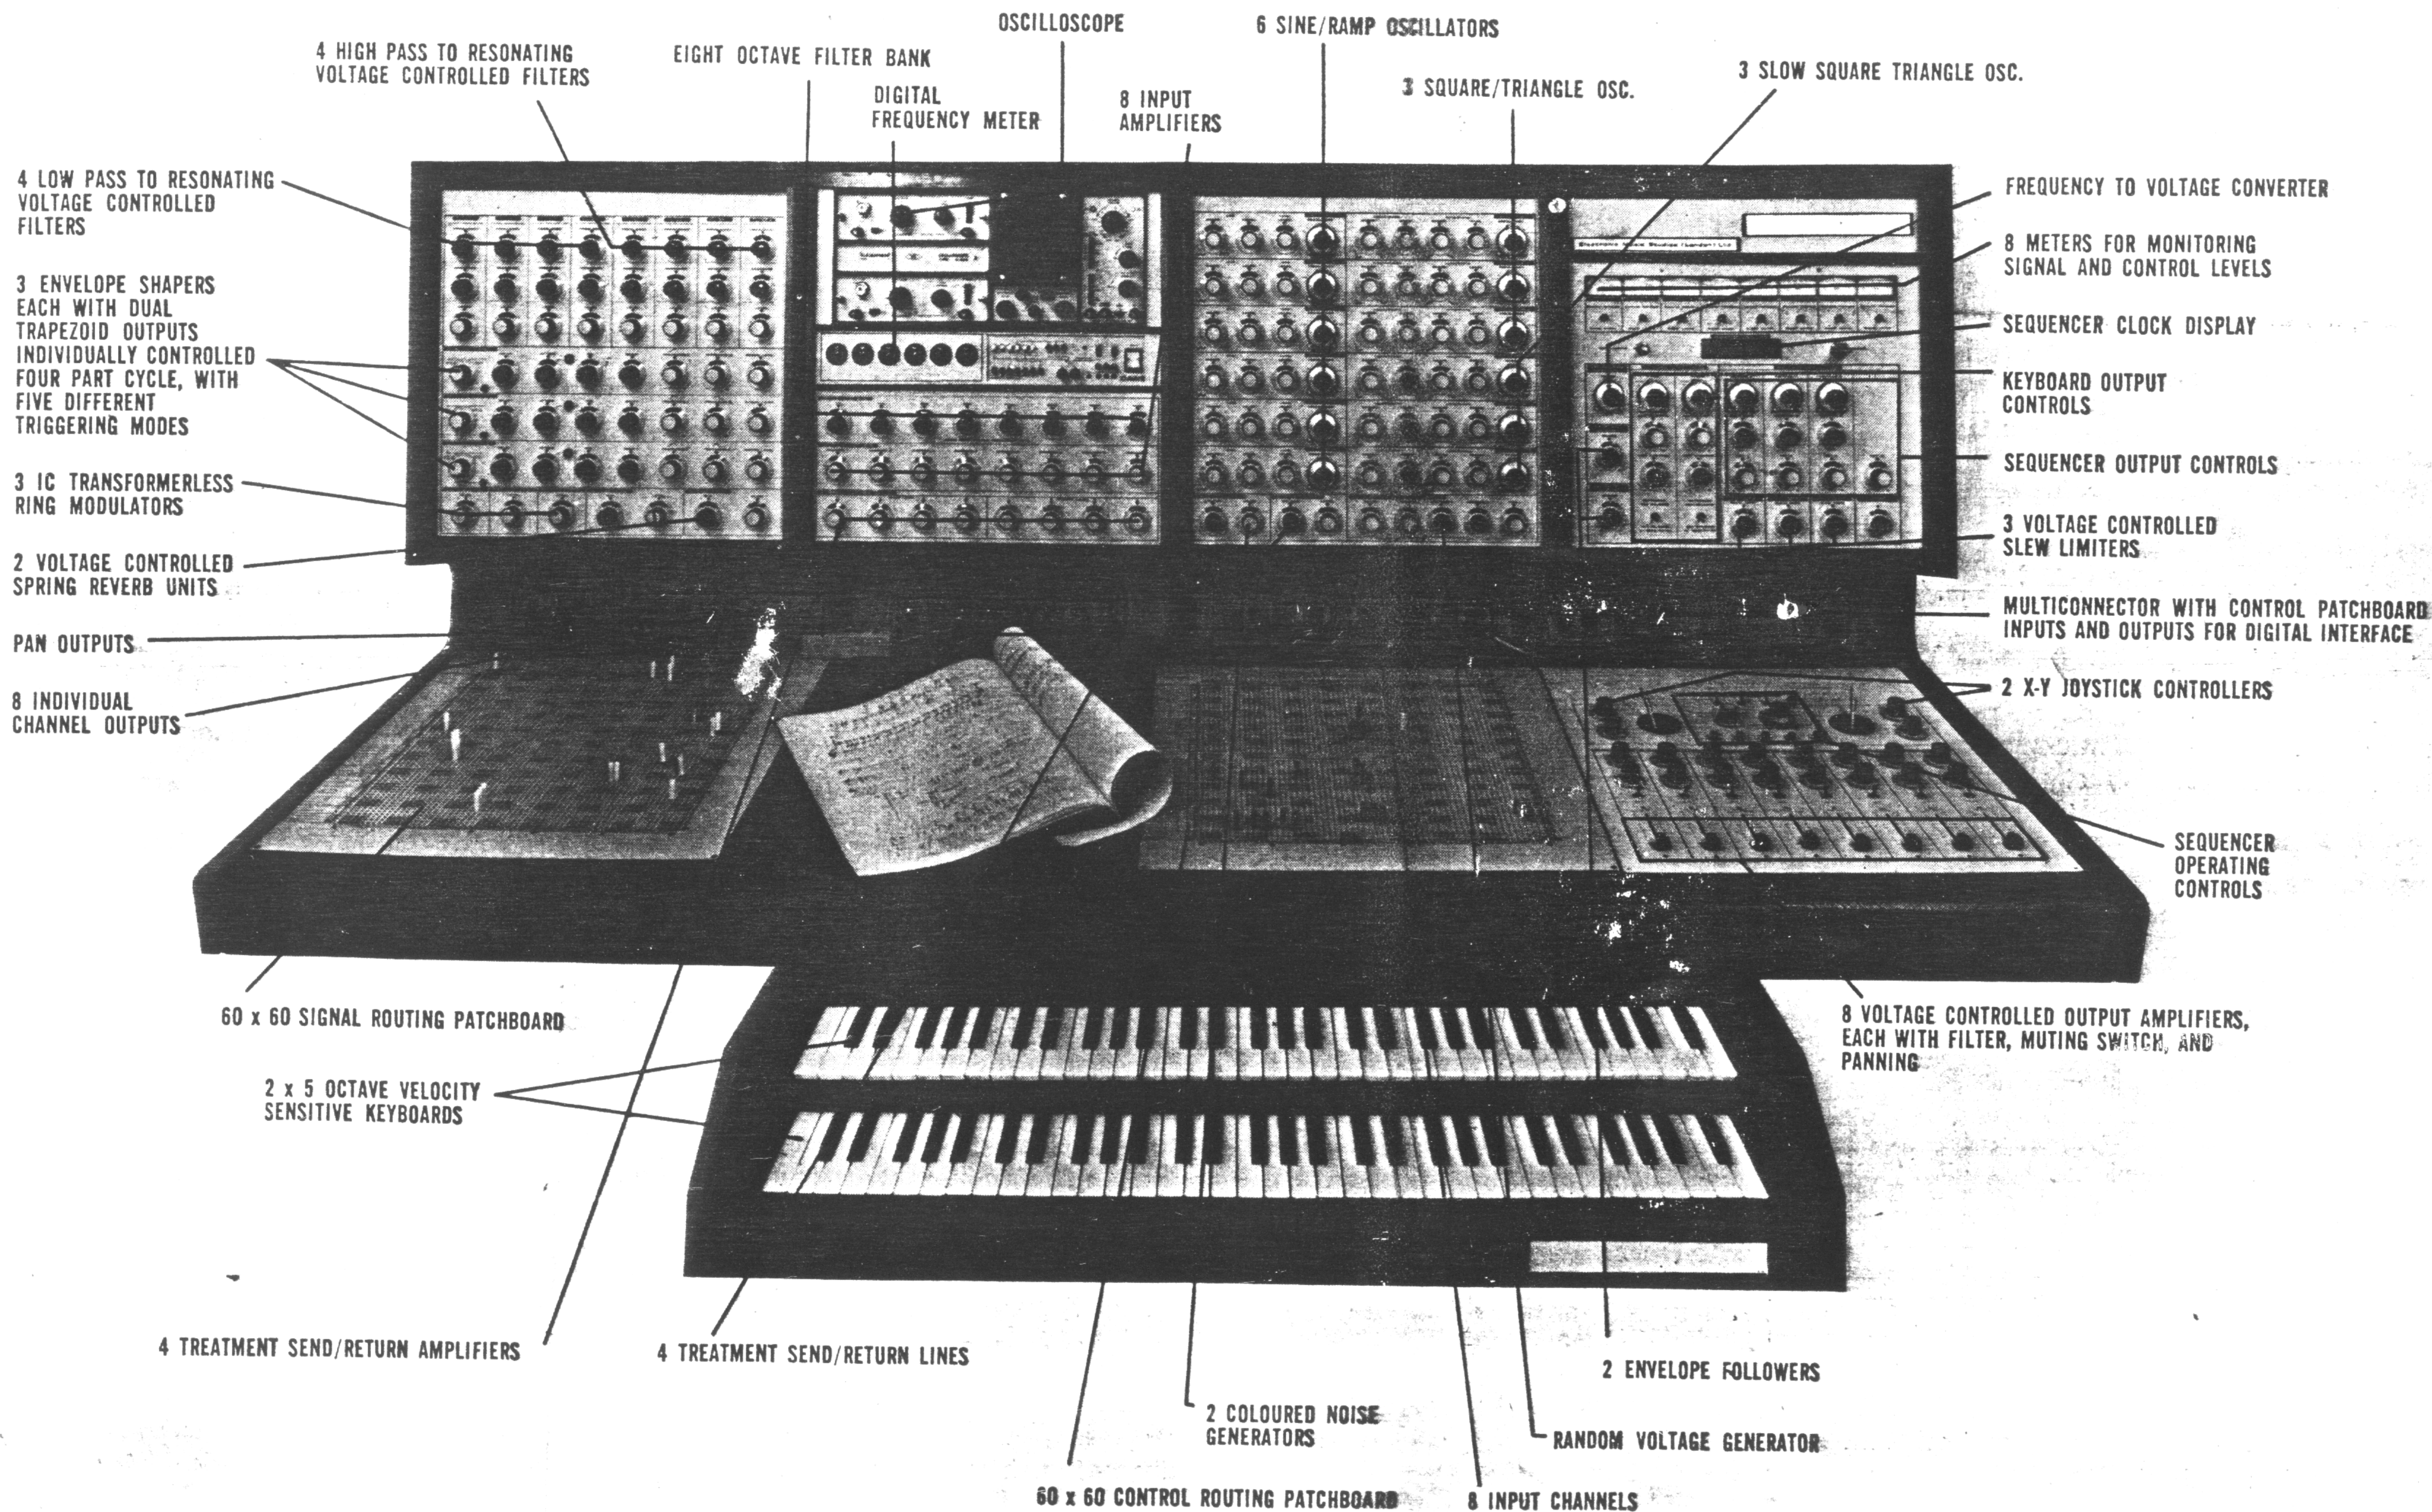

SYNTHI 100

The SYNTHI 100 is the most formidable electronic music system ever devised. It has as its heart a digital sequencer, which is in fact a small special purpose computer, complete with analog-to-digital and digital-to-analog converters. This device enables the operator to load, in his own time, up to six independent tracks of control voltage data, plus attack and switching pulses, then hear it played back, forwards or in reverse, at any speed. All events can be individually examined by stopping the clock, and edited or erased. This sequencer is years ahead of its time.

The SYNTHI 100 is easy to set up (two pin matrixes, each 60 x 60 way), and the large amount of varied hardware at the disposal of the user means that in the assembly of complex sounds compromises are unnecessary. There are features like output level controls on all signal producing devices to facilitate accurate balancing, and phase locking on all oscillators for additive as well as subtractive 'filter synthesis'. A frequency-to-voltage converter and envelope followers provide control voltages from signals, slew limiters will integrate stepped voltages, and nine filters, eight of them voltage controlled, make possible amazingly subtle timbre manipulation.

The SYNTHI 100 is designed to match your other studio equipment, using eight voltage controlled line output channels, eight line input channels, as well as four send and return lines for treatments outside the synthesiser. This astounding machine can also be operated entirely automatically by a computer, and EMS will be pleased to quote for a suitable processor and our own specially designed interface. This opens up

the whole field of sound synthesis to new levels of precision control.

The SYNTHI 100 is already in use by many studios, including the BBC, Radio Belgrade and the University of Wales. Recent great improvements in manufacturing techniques have enabled us to make a very large price reduction without in any way compromising the specification.

ABRIDGED SPECIFICATION

NB: All devices have output level controls, but to save space this is not mentioned in the following descriptions of each item.

TWELVE OSCILLATORS:

Six Sine and Ramp Audio Generators

Frequency Range: 1Hz-10KHz (manual — greater when v-controlled).
Voltage Control: 0.5V/Octave.
Sine shaper for even harmonic control.
Synchronising input.

Three Square and Triangular Audio Generators

As above but shaping on both outputs, giving square — rectangular — pulse, and rising ramp — triangle — falling ramp.
Synchronising input.

Three Low Frequency Square and Triangular Generators

Frequency Range: 0.025Hz (40"/cycle) — 500Hz (greater with vc).
Voltage Control: 0.5V/Octave.
Shape Variation: as above.
Synchronising input.

TWO NOISE GENERATORS:

Built in filter giving dark through white to light.

DUAL OUTPUT RANDOM VOLTAGE GENERATOR:

Distribution of Chances: Rectangular.
Amplitude Variance: $2x \pm 0-2.5V$ max (5V excursion).
Mean Time between Selections: 10mS to 10S.
Time Variance: Equal periods to 100:1 variance.

EMS

Electronic Music Studios London Limited,
49 Deodar Road London SW15 2NU
Telephone 01-874 0042/874 2363 Telex 928327
New York: 408 East 78th Street NY 10021 Tel: 212 734 7344
Telex 42 40 33

THREE ENVELOPE SHAPERS WITH DUAL TRAPEZOID OUTPUTS:

Four section trapezoid cycle: Delay, Attack, On, Decay
V-Controllable time (each section): 2mS-20S.
Five Triggering Modes: Signal Threshold, Hold On, Single Shot, Free Run, Gated Free Run.
Voltage Outputs: As well as modulating an audio signal, each shaper can produce two different control voltages.

FOUR LOW PASS TO RESONATING FILTERS:

Frequency Range: 5Hz-20KHz.
Voltage Control: 0.5V/Octave.
Maximum Q: 20.
Cut-off Rate: 12dB/Octave for first octave, then 18dB/8ve.

FOUR HIGH PASS TO RESONATING FILTERS:

As foregoing but complementary characteristic.

OCTAVE FILTER BANK:

Eight fixed narrow bandpass filters one octave apart between 62.5Hz and 8 KHz, with separate amplitude controls.

TWO SPRING REVERBERATION UNITS:

Reverberation-to-direct ratio is voltage controllable.

THREE SLEW LIMITERS:

Voltage Controllable Slew Rate: 1mS - 10S.

THREE IC TRANSFORMERLESS RING MODULATORS:

Input Rejection: 60dB.

ONE 256 EVENT, 6 SIMULTANEOUS PARAMETER DIGITAL SEQUENCER:

Storage Capacity: 10,750 bits.
For details see separate SEQUENCER 256 leaflet.

EIGHT VOLTAGE CONTROLLED OUTPUT AMPLIFIERS:

Each with slide fader, output panning, variable first order low to high pass filter, output disconnect switch, and meter switchable to read AC or DC level.
Voltage Control: 0.5V/Octave.

TWO X-Y JOYSTICK CONTROLLERS:

Two manually controlled outputs from each stick.
Range of each output: $\pm 2VDC$.

TWO FIVE-OCTAVE PITCH AND DYNAMICALLY-PROPORTIONAL KEYBOARDS:

Each keyboard delivers three outputs, pitch, dynamic and envelope trigger.
Pitch Voltage: 0.5V/Octave (need not, of course, control pitch).
Dynamic Voltage: $\pm 1.5V$ depending on key velocity.

TWO 60 x 60 PIN MATRIX PATCHBOARDS:

One for Signals, one for Controls, with interconnections for dual purpose functions. 7,200 pin locations in all.

EIGHT AC/DC INPUT AMPLIFIERS:

Maximum Line Input: 1.8VAC (rms) or $\pm 2.5VDC$.

FREQUENCY-TO-VOLTAGE CONVERTER

Pitch Voltage: 1V/Octave.

TWO ENVELOPE FOLLOWERS:

Amplitude Voltage: 1VAC (rms)/6dB.

DOUBLE BEAM OSCILLOSCOPE:

HIGH QUALITY DIGITAL METER/TIMER/COUNTER.

High quality specifications from other manufacturers. Latest models fitted.

FOUR EXTERNAL TREATMENT SEND AND RETURN LINES:

For interfacing with other studio equipment.

MULTIWAY PLUG FOR EXTERNAL CONNECTION OF CONTROLS


All control patch connections are available at these sockets, making possible e.g. connection to a computer. All line connections are to Cannon sockets.

DIMENSIONS:

Main Carcass: 79" (2m) wide by 37½" (950mm) deep by 33" (837mm) high.
Height from ground on special stand — 30" (760mm).

SYNTHI 50

The SYNTHI 50 has all the main devices offered in Synthi 100, but does not include the following items: Multiway control socket; Oscilloscope; Digital Frequency Meter; Specially made stand. In Synthi 50 Cannon sockets are replaced by standard Igranic type jack sockets. In other respects there is no compromise to the specification.

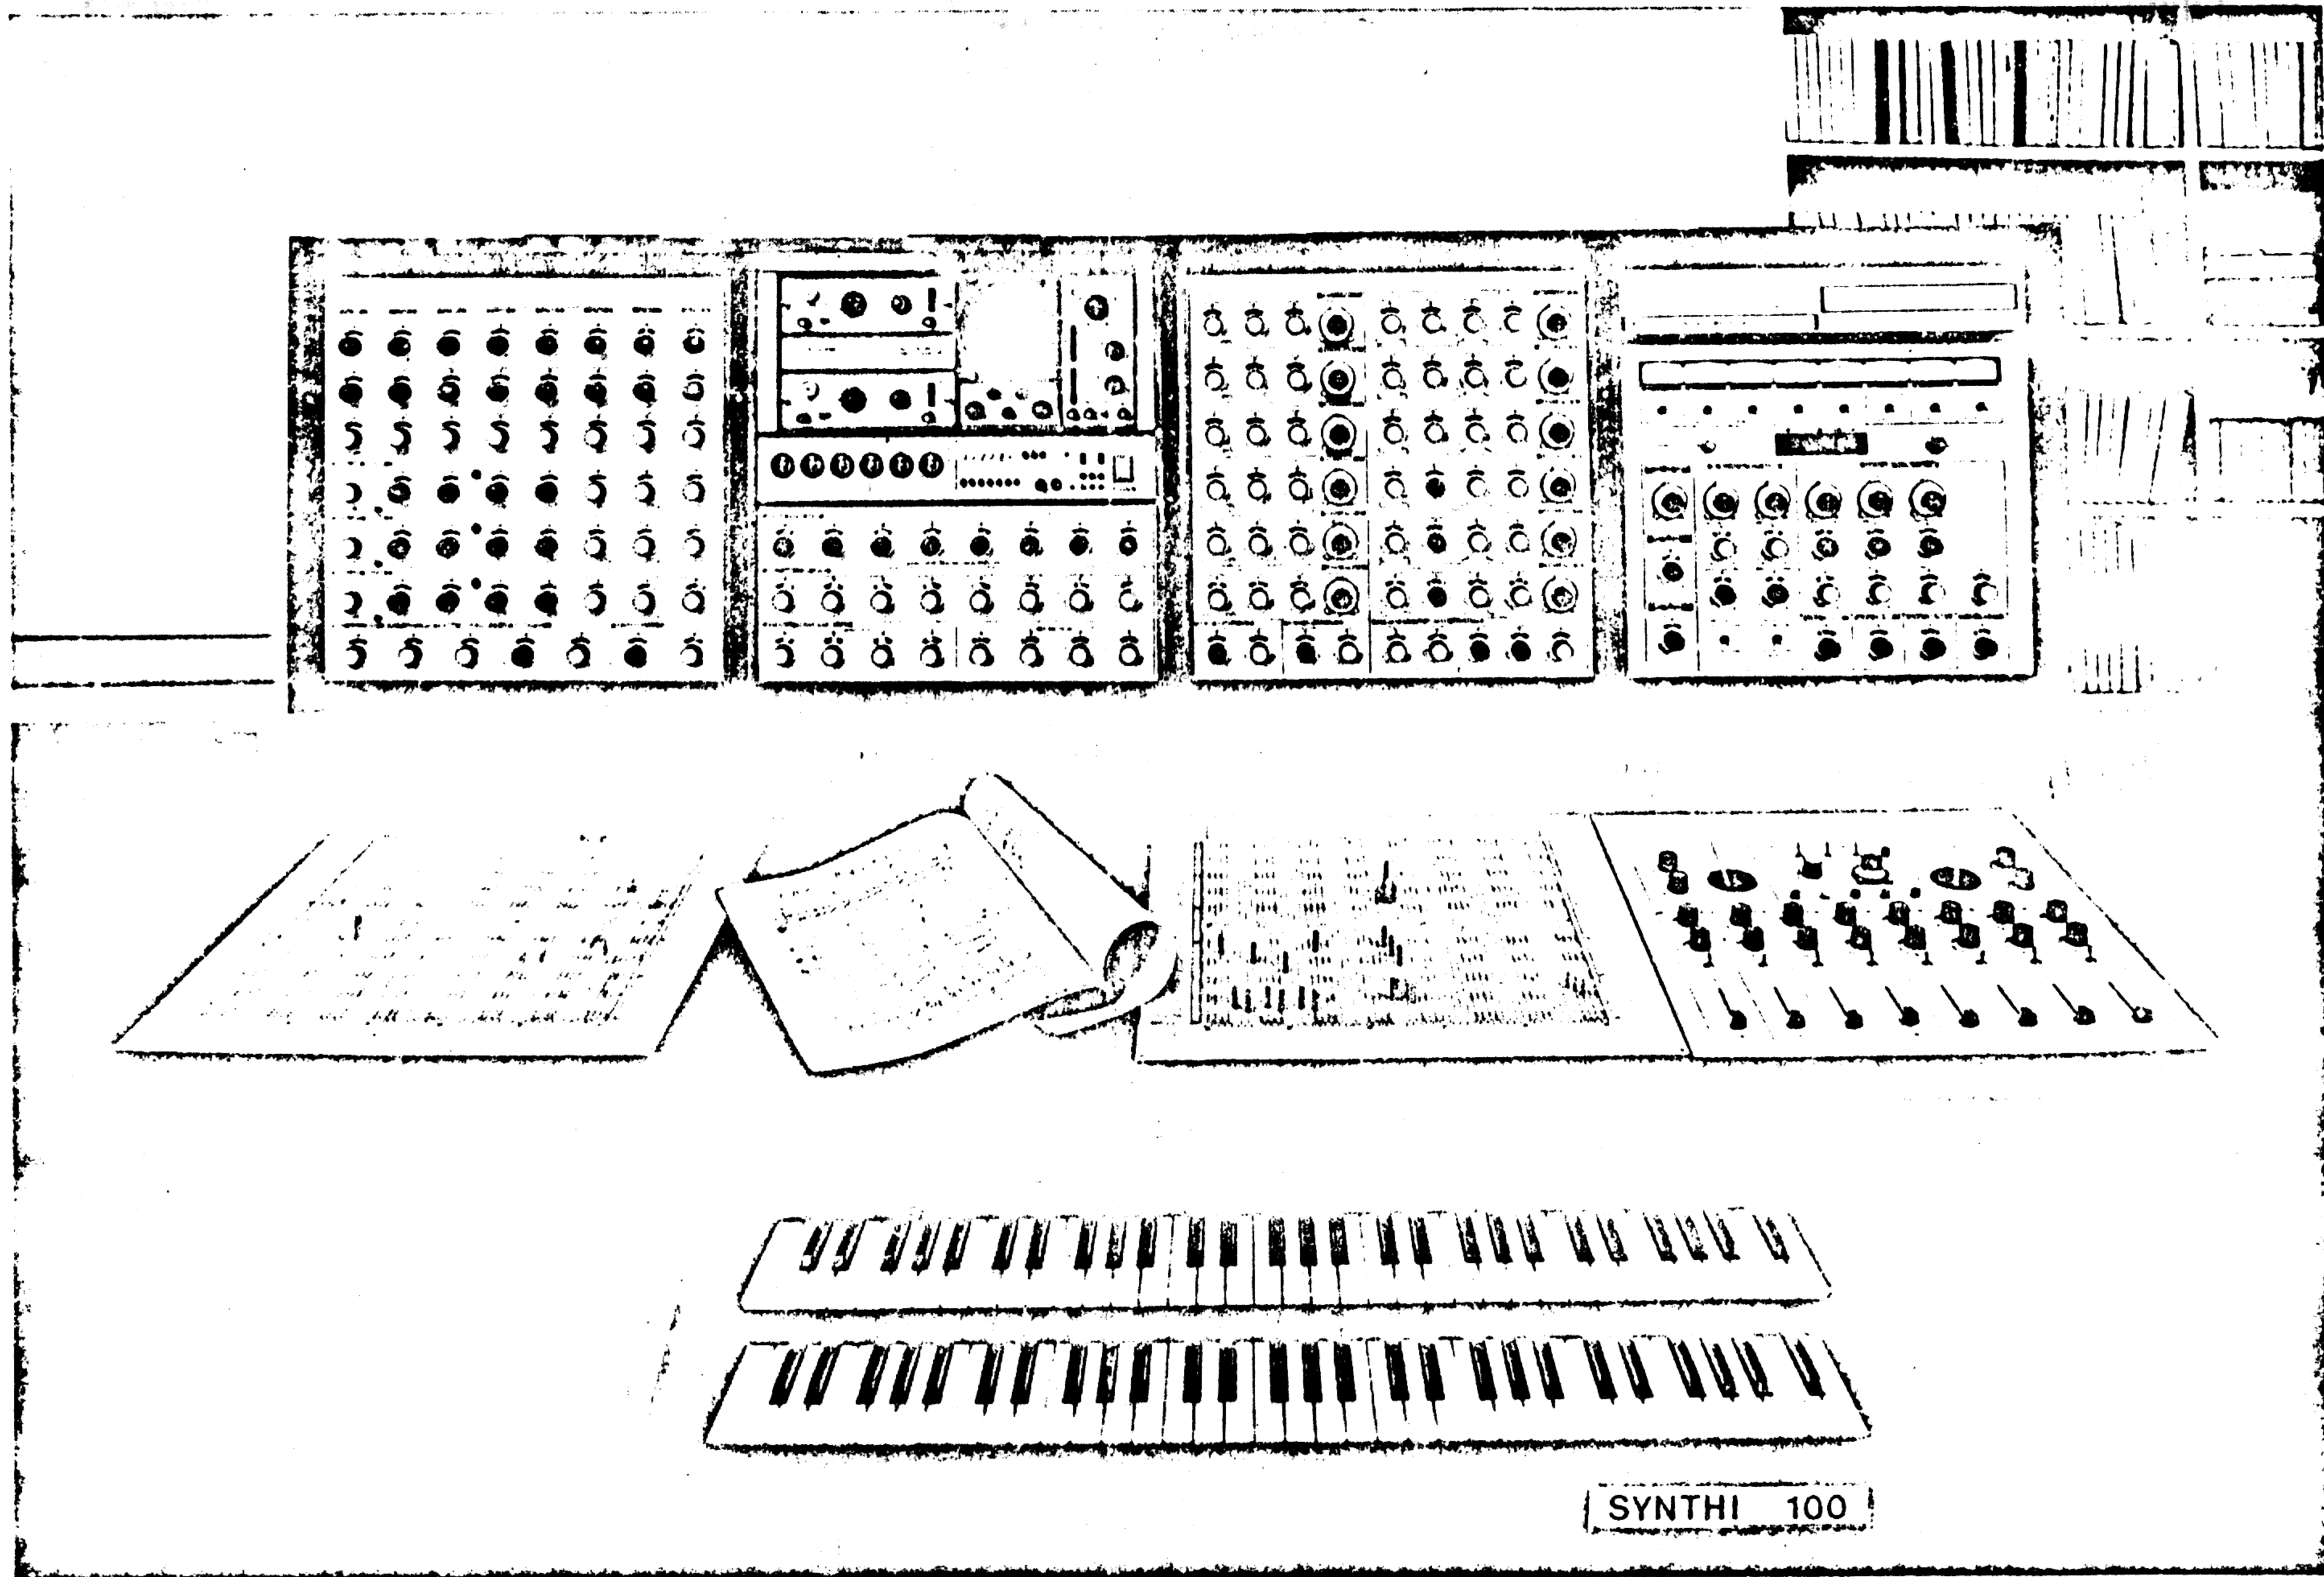

SYNTHI 100

The Synthi 100

Professional Electronic Music Studio

The SYNTHI 100 studio has at its heart a digital sequencer, which makes conventional analogue controllers, with their gigantic array of knobs, seem old-fashioned, inaccurate and cumbersome. With a solid state storage capacity of 10,240 bits, the new sequencer is capable of precisely controlling 6 different simultaneous parameters over a sequence of 256 successive events. There are several modes of operation and full, easy to operate editing facilities, so that any or all of the 256 stored items and their time relationships may be changed without difficulty.

For example, two five-octave dynamically proportional keyboards are included, to operate the studio in real time, on six tracks, with the sequencer remembering what is played. This performance can then be played back backwards or forwards, at any speed, and edited to any degree of precision, prior to recording on magnetic tape.

The SYNTHI 100 also contains new electronic devices exclusive to EMS, such as voltage controlled slew limiters, a frequency to voltage converter and a two-output random staircase generator with controllable time and amplitude variances. Also included are a very full complement of 12 drift-free oscillators, eight dynamic filters and three transformerless i.c. ring modulators (which can be cascaded for double and triple modulation), as well as eight voltage controlled output channels with full panning facilities, eight input amplifiers, two X-Y joystick controllers, a filter bank, three elaborate envelope shapers and followers, noise generators and reverberation units. A double-beam oscilloscope and six-digit crystal-controlled counter/timer/frequency meter ensure accurate setting up and logging of parameters, and patching is by cordless pin matrices (two boards each with 60 x 60 locations).

In the same price range as the larger voltage controlled synthesizers, the SYNTHI 100 offers far more, and is intended for really exacting composition and realisation work in professional recording and electronic music studios, broadcasting companies and universities. First customers include the BBC, Radio Belgrade and the University of Wales.

◀

This photograph shows the EMS Synthi 100. The patching matrixes are on the main desk; the right hand matrix is used for control voltages and is connected to the Digital Interface via two 60 way junctions. The knobs above the desk are used as presets when the SYNTHI is controlled by computer.

ELECTRONIC MUSIC STUDIO SUPPLIES
5832 WESTMINSTER
MONTREAL 268, — TEL: 488-4050

... SOLE DISTRIBUTOR FOR CANADA

General Points

Appearance

The SYNTHI 100 is presented in an afromosia case, with padded black leather. A cupboard stand and seat are available as extras. The working surfaces are illuminated by dimmer lights, and all outputs and inputs are available behind a sliding screen in the front of the unit, while the input/output cables are channelled on to the rear. The SYNTHI 100 is designed for computer interface, and therefore all control inputs are available for direct connection to digital/analog converters on multiway connectors. The overall size base of the SYNTHI 100 is 79 in. length by 37½ in. depth, the height is 33 in. and the height from the underside to the ground is 30 in.

Signal Levels

The levels of all signal outputs available at the patch-board are controlled by panel mounted potentiometers. In fact, these potentiometers provide control voltages which operate on voltage controlled amplifiers. The advantages of this system include:

- Constant low output impedance.
- No 'fader scratch' as levels are changed
- Less conveying of signals at high impedance (where they are susceptible to crosstalk)
- Much simplified wiring system
- Ideal logarithmic control of level

In general, signal levels are about $\pm 1V$ p-p, although most outputs can deliver much more than this. Most devices which have signal inputs are adjusted for optimum operation at this level, although it can be usually considerably exceeded without serious distortion.

Control Voltage Levels

All EMS control voltage outputs are bipolar, that is to say they go both positive and negative. This allows control signals and audio signals to be interchanged, and also allows the magnitude of a control output to be adjusted without altering the mean level of the parameter controlled.

Input Impedances

All input impedances are approximately 10 KOHM. This comparatively high figure was chosen as a compromise between the conflicting requirements of 'fan out' (i.e. the number of inputs an output may drive before it runs out of power) and susceptibility to crosstalk when an input is left open circuit. Screened cable is used for all signal paths in the studio, and impedance at certain central inputs is made infinitely low so that secondary control parameters can be added without reducing the magnitude of the primary ones.

Noise Levels

The signal to noise ratio of all voltage controlled amplifiers is better than 74 dB for an input signal level which produces a T.H.D. of 3%. This ratio is constant over the upper 30 dB of the control range. In other words, as the amplifier gain is reduced, the noise is proportionally reduced as well. When the amplifier is cut off, the noise at its output is immeasurable.

Specification

Source Modules

Three Voltage Controlled Audio Waveform Generators, Sine and Ramp

Manual Frequency Range: Greater than 1Hz - 10 KHz (extendible by voltage controls in both directions — to 0.25 Hz and 20 KHz).

Sine Purity: Better than 50% total distortion between 10 Hz and 10KHz.

Ramp Output Linearity: Departure from linearity $\pm 1\%$ of best straight line between 10Hz and 10KHz.

Voltage Control: 5v/octave. Accuracy 0.3% departure from best straight line between 100 and 2000 KHz.

Frequency Stability: Generally better than 2% from month to month, but the oscillators usually hold their setting to within 2 cycles in a thousand during a working session.

A sine shaper is included by which variable amounts of even harmonic distortion may be added.

Three Voltage Controlled Audio Waveform Generators, Triangle and Square.

These can be varied from triangle to sawtooth ramp, and from symmetrical square to short pulse, in either polarity.

Manual Frequency Range: Greater than 1 Hz to 10 KHz.

Triangle Symmetry: $\pm 5\%$ rise time to fall time equality.

Other specifications as for sine/ramp oscillator.

Three Voltage Controlled Low Frequency Waveform Generators

Same details as before, but oscillators are twenty times as slow.

Frequency range: Greater than 0.025 Hz (40 secs. per cycle) to 500 Hz.

Voltage Control: .5v/octave.

These three oscillators are intended mainly as control sources, but can be used for tone generation at the upper end of the range.

All nine of the above oscillators have synchronisation inputs so that they can operate at an integral multiple of another oscillator, providing a huge variety of waveforms which can be used in additive synthesis.

Three Noise Generators.

Variable from white (central position of colouration control) to dark or light positions (low or high pass filters).

Distortion: In white position, frequency content is flat ± 3 dB from 100 Hz - 10 KHz.

We recommend several noise sources, because with different filterings more than one can be used for different purposes.

Dual Output Random Control Voltage Source

This device produces two control voltages which move abruptly from one level to another. The distribution of levels is rectangular rather than Gaussian, and the two outputs are uncorrelated in level, but synchronous in time. The mean time between changes, and the variance about that mean are manually controllable. The distribution of times is rectangular, and in common with all other time controls devices in the studio, a control range of at least 1000:1 is available.

Controls:

Amplitude Variance: Up to 2.5v symmetrically positive and negative (x2, each output separately controllable).

Time Range: From approximately 10 secs to 10 ms if no time variance is applied.

Time Variance: From equal steps to 1000:1 variance. Effect of variance control is obviously limited when time range control is at either entrance.

Treatment Modules

Three Voltage Controlled Trapezoid Generators with Integral Envelope Shapers

These devices might be described as voltage programmable four segment curve synthesizers, the output being available as two control voltages and as the modulation of an audio signal.

The basic waveform produced (at each control output) has four stages:

- 1 **Delay.** The output remains constant and negative for a controllable time after the generator is triggered.
- 2 **Attack.** The output rises to a fixed positive value at a controlled rate.
- 3 **On.** The output remains constant and positive for a controllable time after the completion of 'attack'.
- 4 **Decay.** The output falls at a controlled rate to its initial value.

In addition, there is a second output which lags behind the first by one quarter of a complete trapezoid cycle. Thus the time set for, say, 'on' in respect of output 1, becomes the time for 'attack' from output 2, and so on.

The amplitude and polarity of both outputs may be adjusted independently so that if they are summed (on the patchboard) any continuous four line function which ends at the value at which it starts may be produced. This arrangement gives an extraordinary flexible range of envelopes.

The envelope shaper portion consists of a logarithmic voltage controlled amplifier permanently connected to one of the trapezoids.

The overall control of each cycle of operation may be in a number of ways selected by a switch, having the following positions:

- 1 **Signal threshold.** Any signal above a certain level initiates a single cycle.
- 2 **Hold** sequence starts when control is positive. Decay does not start until control goes negative.
- 3 **Single shot** positive zero crossing initiates a single cycle.
- 4 **Free run.**
- 5 **Gated free run** positive level allows the sequence to free run. Sequence stops at the end of a cycle when level goes negative.

Panel Controls

Initial delay time	2 ms to 20 sec.
Attack time	2 ms to 20 sec.
On time	2 ms to 20 sec.
Decay time	2 ms to 20 sec.

(these parameters may also be voltage controlled over their entire range.)

Trapezoid phase 1 output level (centre zero knob)	
Trapezoid phase 2 output level (centre zero knob)	
Signal level control	
Push button (to initiate cycle)	
Trigger mode selector switch	

Envelope shaper is logarithmic to within 3 dB over its 60 dB range.

Voltage control function of time parameters is ideally exponential to within 10% (of dependent parameter) over a range of 1000:1. Departure from ideal is gradual beyond these limits. This permits a single voltage applied to all inputs to compress the time scale.

Four Voltage Controlled Filter/Oscillators (Low Pass to Resonating)

Operation as a sine source.

Frequency Range:

Greater than 5 Hz-20 KHz.

Sine Purity:

Better than 3% total distortion between 10 Hz and 10 KHz.

General Noise Figure for Oscillators:

Spurious outputs not greater than 0.1%.

As filters, they are adjustable from Low Pass to Resonating Filters, covering the entire sonic range.

Frequency Range:

Greater than 5 Hz to 20 KHz.

Low Pass Position:

Cut off rate 12 dB for first octave and 18 dB per octave thereafter.

Resonator Position:

Maximum stable 'Q' factor-20.

Accuracy of Exponential Voltage Control Function:

$\pm 1\%$ between 100 Hz and 2000 Hz.

Note: Operation as a voltage controlled oscillator is limited by the time taken to respond to an abrupt change. Maximum slew rate is about 2 ms per octave.

Four Voltage Controlled Filter/Oscillators (High Pass to Resonating)

Similar, but complementary to Low Pass Filters.

One Octave Filter Bank

This consists of eight resonating filters, fixed-tune one octave apart, in the range 62.5 Hz-8 KHz, separately controllable.

Two Voltage Controlled Reverberation Units

Each spring unit has two elements with delays of 35 and 40 ms.

Maximum Reverberation Time:

2.4 seconds.

Useful Frequency Range:

30 Hz-12 KHz.

Voltage Control Range:

$\pm 2v$ from no reverberation to maximum reverberation.

Three Voltage Controlled Slew Limiters

This device is a unity gain amplifier in which the output exactly follows the input at a rate whose maximum (slew) is defined by a control voltage. One application might be to interpose the device between the pitch control voltage from a keyboard and the oscillator whose pitch is to be controlled. If the key velocity voltage were then applied to the slew control input, the player could produce a glissando between any two notes that he played, the rate of glissando being controlled by his touch.

Steady State Gain: $1 \pm 1\%$

Steady State Linearity: $\pm 0.05\%$ (BSL)

Range of Slew Control: 1 ms to 10 sec.

Voltage control of slew is exponential.

Note: Unlike all other devices, no output level control is provided as the device has unity gain.

Three Integral Circuit Transformerless Ring Modulators

These very efficient modulators also include amplifiers, and can therefore be used in series for double or triple modulation.

Maximum Input for

Undistorted Output: 1.5v p-p to each input.

Breakthrough with 1.5v

on one input only: 5mV p-p (—60 dB)

One 256 Event, 6 Simultaneous Parameter Digital Sequencer

This machine is, in fact, a small special purpose digital computer, complete with analog to digital and digital to analog converters. It provides a sequence of control voltages which may be used on any of the devices in the studio.

The operation of the sequencer may most easily be described in terms of conventional music, although it must be remembered that the design by no means limits it to this kind of operation.

The sequencer stores 256 'notes' and plays each note at the correct time and for the correct duration. It simultaneously provides two voltages, one of which might be used to define pitch and the other loudness. It is capable of controlling three voices, each with duration, pitch and loudness. The 256 note storage may be distributed to each voice in any proportion, for instance, 254 notes may go to one voice and one each to the others. In fact, the second and third voices need not be used as such, their voltages could be used to control parameters (filtering, decay time, etc.) of the first voice.

The information which is to be stored and subsequently reproduced is presented to the machine as control voltages, which are most easily supplied from the keyboards.

All timing data is entered by playing the keys. To record a sequence the composer sets the speed of a clock and starts it running. As he plays each note, the machine at that instant records how many clock pulses have elapsed since the start of the sequence, and how many during the time that the note was held down. It simultaneously remembers which note on the keyboard was pressed and with which velocity it was struck. (The second parameter, or, indeed, the first, could equally be derived from any voltage source.) The composer continues until he has recorded perhaps sixty notes. He then restarts the clock and turns a switch which tells the machine that the next notes he plays will be directed to the second envelope shaper. While recording each sequence, he can simultaneously hear the results of what he has previously recorded.

The machine may then be set to the edit mode. In this mode the sequence may be advanced at any speed, or step by step, so that each note may be modified or erased. A special feature allows time to be reversed. A control rather like the spooling knob on studio tape recorders allows one to go forwards or backwards at any speed. Unlike a tape recorder, however, there is no inertia in the system, so that one can quite easily 'zero in' on a particular note.

Sequencer Controls

Ten controls are provided to adjust the amplitude of the sequencer's output voltages, and a further ten supervise the actual operation.

1 Range of Layer 1 Output Voltage A

This control is a slow motion dial calibrated 0-100. If Voltage A were used to control the pitch of an oscillator, then this control could be used to define the musical interval for each step of the output. At 25, for instance, a range of sixty-four quarter tones (covering about 2½ octaves) will be available.

2 Range of Layer 1 Output Voltage B

The range of the second parameter for each event may similarly be adjusted with this control.

3 Range of Layer 1 Keying Voltage

This voltage, which is positive for the duration of each note in Layer 1, would normally be used to control the envelope shaper. It can also be used to assist in the synthesis of certain instrumental sounds. For this reason, a centre zero control is provided. This inverts the polarity of the voltage when it is counterclockwise.

4 5 and 6 are controls identical to 1 2 and 3, except that they apply to the second layer. Likewise 7, 8 and 9 which apply to the third layer.

10 Range of 'Key 4'

A fourth kind of event may be recorded which is similar to the three layers, except that there are no parameter control voltages available with it — just the keying voltage. It is primarily intended to stop or reset the sequencer's clock, allowing one to produce a single finite sequence or a repeating pattern. If not used for this purpose it might be used in conjunction with a slew limiter and a voltage controlled amplifier to initiate a crescendo or a number of other things.

Note that all controls, 1-10, can be adjusted after the sequence is entered, without changing the basic data.

11 Clock Rate

This slow motion dial is a centre zero control in a rather special sense. When it is less than halfway, the sequence runs backwards. It controls the clock rate over a range of ±1000:1. That is to say, with the control near its centre position, the clock pulses occur at about 2 per second, allowing a total sequence length of over six minutes. In this case, however, the resolution in time of each event is only half a second. The control has a distinct dead space around half-way, which prevents the clock from 'drifting' during editing. A voltage proportional to the absolute clock speed is available at the control patchboard, so that it can simultaneously control all time variant parameters — envelope shapers, slew limiters and even oscillator frequencies — as the clock rate is adjusted.

12 Note Distribution

This control is a four way switch; it tells the machine which of the three layers is being recorded, so that on replay the voltages will appear at the appropriate output. The fourth position denotes 'Key 4' as described above.

13 Stop at each note

When this toggle switch is down, the sequencer clock stops at the start of each note that it reproduces.

14 Stop at end of note

Similar to 13, except that the sequencer stops at a time corresponding to when the key was released as the note was recorded.

These switches operate in conjunction with the note distribution switch, in that they only stop at a note in the layer defined by the latter.

The purpose of 13 and 14 is to facilitate the editing of events after a tentative sequence has been entered.

15 Erase note button

While this button is pressed, any notes in the layer selected by the note distribution switch which start at the time shown by the clock display, will be erased.

16 Clear memory button.

This is the 'bulk erase' button.

17 Reset button

This button sets the clock to zero, and holds it there as long as it is pressed. It does not stop the clock, it simply restarts the sequence from the beginning.

18 Start button

This button allows the clock counter to start or continue counting. It would be used continually during editing, to advance the sequence note by note.

19 Stop button

This button stops the clock from counting.

Note that 17 18 and 19 are momentary action push-buttons, not switches. They roughly correspond to the controls on a stop-watch.

When the sequencer clock is driven from pulses previously recorded on tape, or, indeed, from any external source, it will ignore them until the start button is pressed. Remote operation of the sequencer is facilitated by electrical inputs at the signal patch-board.

20 Rewrite B, D, F

When this switch is down, the second parameter voltages in each layer may be rewritten without disturbing the first parameter, or the event timing.

Note: In this section, 'Note' is used for musical convenience, but, it must be remembered, can be used for any parameter which has been selected.

Summary of Specification

Total storage capacity: 10,240 bits (of which 9,216 bits are normally used).

Organisation of Data

36 bit words — each word representing one event.

Start-of-event time (referred to start of sequence) 10 bits.

End-of-event time (referred to start of sequence) 10 bits.

Selection of one of three envelope shapers and one pair (out of three pairs) of digital analog converters.

Also internal functions 4 bits.

Data, for digital analog converters 2 x 6 bits.

Details of Coding

The 10 bit event time allows the start of each event to be defined to an accuracy of 1 part in 2 to the power 10 (viz. 1024). Thus, if the clock is set to a rate of, say, one hundredth pulses a second, each event may be adjusted forwards or backwards in increments of one hundredth of a second. The total sequence length would be ten seconds.

The 'end of event' time, i.e. the time at which the key is released, is similarly recorded. Thus three control signals are reproduced, each being positive during the duration of a note intended for one of the three layers of the sequence. They are available at the patchboard as switching voltages which would normally go to the supervising inputs of the envelope shapers.

Digital Analog Converters

Of the six converters, three are of accuracy appropriate to exact control of pitch on the diatonic scale. Six bits give a range of 64 notes. If greater range and/or finer resolution is required, then the output of the second converter may be added to that of the first. In this case, the player might use one keyboard to define a note on the diatonic scale, and the second to raise or lower that note by increments of one thirty-second of a tone.

The precise converters are accurate to $\pm 0.15\%$ (BSL). The second parameter converters are accurate to $\pm 0.78\%$ (BSL).

Eight Multifunction Output Amplifiers

These amplifiers are primarily intended to be the last link in the signal chain before the tape recorder or monitor, but they provide certain subsidiary functions which will make them otherwise useful. All eight are voltage controlled (0.5V per 6 dB).

Controls

Level: Slider type fader.

Pan: A knob which distributes the output to between the left and right bus, these being common to four of the eight amplifiers.

Filter: A single knob providing continuous transition between first order low pass and first order high pass.

Off Switch: Totally disconnect output from the pan control, allowing the amplifier to be used earlier in the signal chain.

Meter Switch: The meter may be used as a centre zero DC voltmeter, or as an AC level meter.

Two X-Y Joystick Controllers

These give continuous control of two parameters together, which is very useful in live performance. The control sticks have a range of $2 \times \pm 2V$ DC.

Two Five Octave Dynamically Proportional Keyboards

Five octave keyboards giving precise divisions of pitch or any other controllable parameter. In the case of pitch, the range would give anything between 4 and 40 notes per octave. This is useful for microtonal work. By setting 12 notes per octave, the keyboard can be used as a normal melodic source.

A second voltage output is proportional to touch — actually the velocity with which a key is struck.

A third voltage switches positive when one or more keys are pressed. Note that the keyboard produces only one pitch voltage at any instant; when several notes are pressed, the voltage of the highest appears.

both the pitch voltage and dynamic voltage are 'remembered', even when a key is released.

Keyboard voltage: 0.5V per octave maximum, accurate to better than 0.15% at all points.

Dynamic voltage: $\pm 1.5V$ depending on key velocity.

Output function was synthesized to be a compromise between a strict proportionality to velocity over a range of about 100:1, and a function that would distribute even subjectively equal increments of playing force evenly over the output voltage range. The keyboard feels most natural when the dynamics voltage is used to control a modulator over a 40 dB range.

Eight-Way Fading/Panning Console (See Multifunction Output Amplifiers)

50 x 60 Pin Matrix Patchboards (7,200 Pin Locations)

These patchboards allow any input to be connected to any output by the insertion of a single cordless pin. Each output is connected to a row of sixty horizontal holes. The holes appear as a square array of 3,600 (x2) cross-points, in any of which a jack may be inserted. The jacks contain resistors so that several outputs may be mixed into a single input. All device outputs are fed to the board at a low impedance, blocking any reverse signal paths.

Two patchboards are provided, one intended for control signals and one for audio signals. A small number of interconnection patches between the patchboards are hard wired, as some signals can be used in both domains.

It is also possible to route external signals to the patchboards by using the jacks in the conventional way. All contacts, including the jacks have a surface coating of silver.

Eight AC/DC Input Amplifiers

Maximum distortion at rated inputs: 0.1%.

Input Sensitivities: Line Input: maximum 1.8V AC (rms) or $\pm 2.5V$ DC.

These amplifiers convert input signals to a suitable level and impedance to feed treatment devices. The line inputs are directly coupled and are therefore suitable for both signal and low frequency or DC control inputs. Two separate microphone amplifiers are supplied, which can feed any two of the above channels.

Four External Treatment Send and Returns

Provision for sending out to external echo plates and other equipment, and returning to the Studio.

One Frequency to Voltage Converter

This device accepts inputs from a variety of sources, including acoustical instruments (via a microphone or pickup and pre-amplifier) and produces a voltage proportional to the fundamental pitch of the note played. Sophisticated analog circuitry is incorporated to remove overtones, provided that their energy constitutes no more than 90% of the total signal.

Unlike conventional frequency measuring techniques, which count the number of zero crossings of a waveform in a fixed interval of time, the converter measures the period of the signal and transforms this data to a voltage which is compatible with the other devices in the studio. The advantage of this method is that an accurate measure of the pitch can be made in a much shorter time. The output is gated into a track and hold

buffer by a discriminator, which suppresses spurious outputs when the signal is dying away.

A single output control adjusts the range and polarity of the output voltage.

Two Envelope Followers

These devices produce a voltage proportional to the mean level of an audio signal. The output is passed through a second order low pass filter to remove ripple while keeping a fast response. Cut off is about 50Hz. Output amplitude is adjustable by a centre zero knob to give positive or negative excursions of up to 1 volt per 6 dB.

Items from other Manufacturers

Dawe 3000 AR/6 Digital Frequency Meter

Brief details as follows:

Crystal frequency: 100 KHz $\pm 0.002\%$

Frequency Measurement: Range — 0-1 MHz
Accuracy — ± 1 digit \pm crystal accuracy
Gating Time — 1 ms to 10 seconds

Period Measurement: Range — 0-300 KHz
Time Units 1 10 s to 10 ms
Gating Period — 1/7 to 1,000 cycles of input frequency

Time Measurement: Range — 10 s — 10 secs
(nearly four months)

Telequipment Double Beam Oscilloscope, D43R

Rack mounted double gun laboratory oscilloscope, with 6 x 8 cm display area.

Electronic Music Studios (London) Ltd. reserve the right to vary the specification and/or price of the SYNTHI 100 studio without notice, should it be necessary or desirable.

Calibration Details for Synthi 100, Serial Number .3019...1. Sequencer Clock.

The sequencer clock speed knob is calibrated thus:-

Setting	Clock Frequency
0	Ω 0.6 Hz
5	32 Hz
10	Ω 1000 Hz

2. Pitch To Voltage Converter.

Approximate setting for pitch to voltage converter to track octaves ...8.45...

Voltage output is 0 volts for an input frequency of around 320 Hz.

3. Oscillator Bank Calibration.

Dial control characteristic 1 octave per major division.

Oscillators 1 - 9 range: 10 Hz to approximately 10 KHz.

Frequency on dial setting of 5 is 320 Hz.

Oscillators 10 - 12 approximate range: 0.1 Hz to 50 Hz.

Frequency on dial setting of 5 is 1.6 Hz.

Control voltage at patchboard $\frac{1}{2}V$ / octave 10K blue pin.

4. Sequencer Pitch Calibration.

Keyboard pitch voltage settings to correctly address analogue to digital converter in sequencer. Upper .8.1.....

Lower .8.15.....

Approximate BDF settings to produce octaves ..5.2.....

"	A	"	"	"	"	..5.25....
"	C	"	"	"	"	..5.2.....
"	E	"	"	"	"	..5.25....

5. Keyboard.


The keyboard is aligned to give a pitch voltage of zero between centre F and F# on both manuals. This adjustment is made by means of a multiturn preset accessible on the rear connection panel of the keyboard and is very critical for the correct addressing of the analogue to digital converter in the sequencer section of the Synthi 100. It should not normally be necessary to adjust this control.

New Additions


1) Digital Volt Meter. This is situated on the small panel at the top right hand end of the vertical panels on the console. It is permanently connected to the scope "Y1" row on both patchboards. A manual for the instrument is included with the literature provided with the unit.

NOTE. When trimming the zero setting, the "Y1" row on the patchboard must be grounded.

2) Sequencer "Available Memory" Meter. This indicates the amount of available memory store for use. The drive circuitry for this meter is located on printed circuit board "M" (red handle). If it is necessary to trim the "100 %" indication, there is a preset for this purpose.

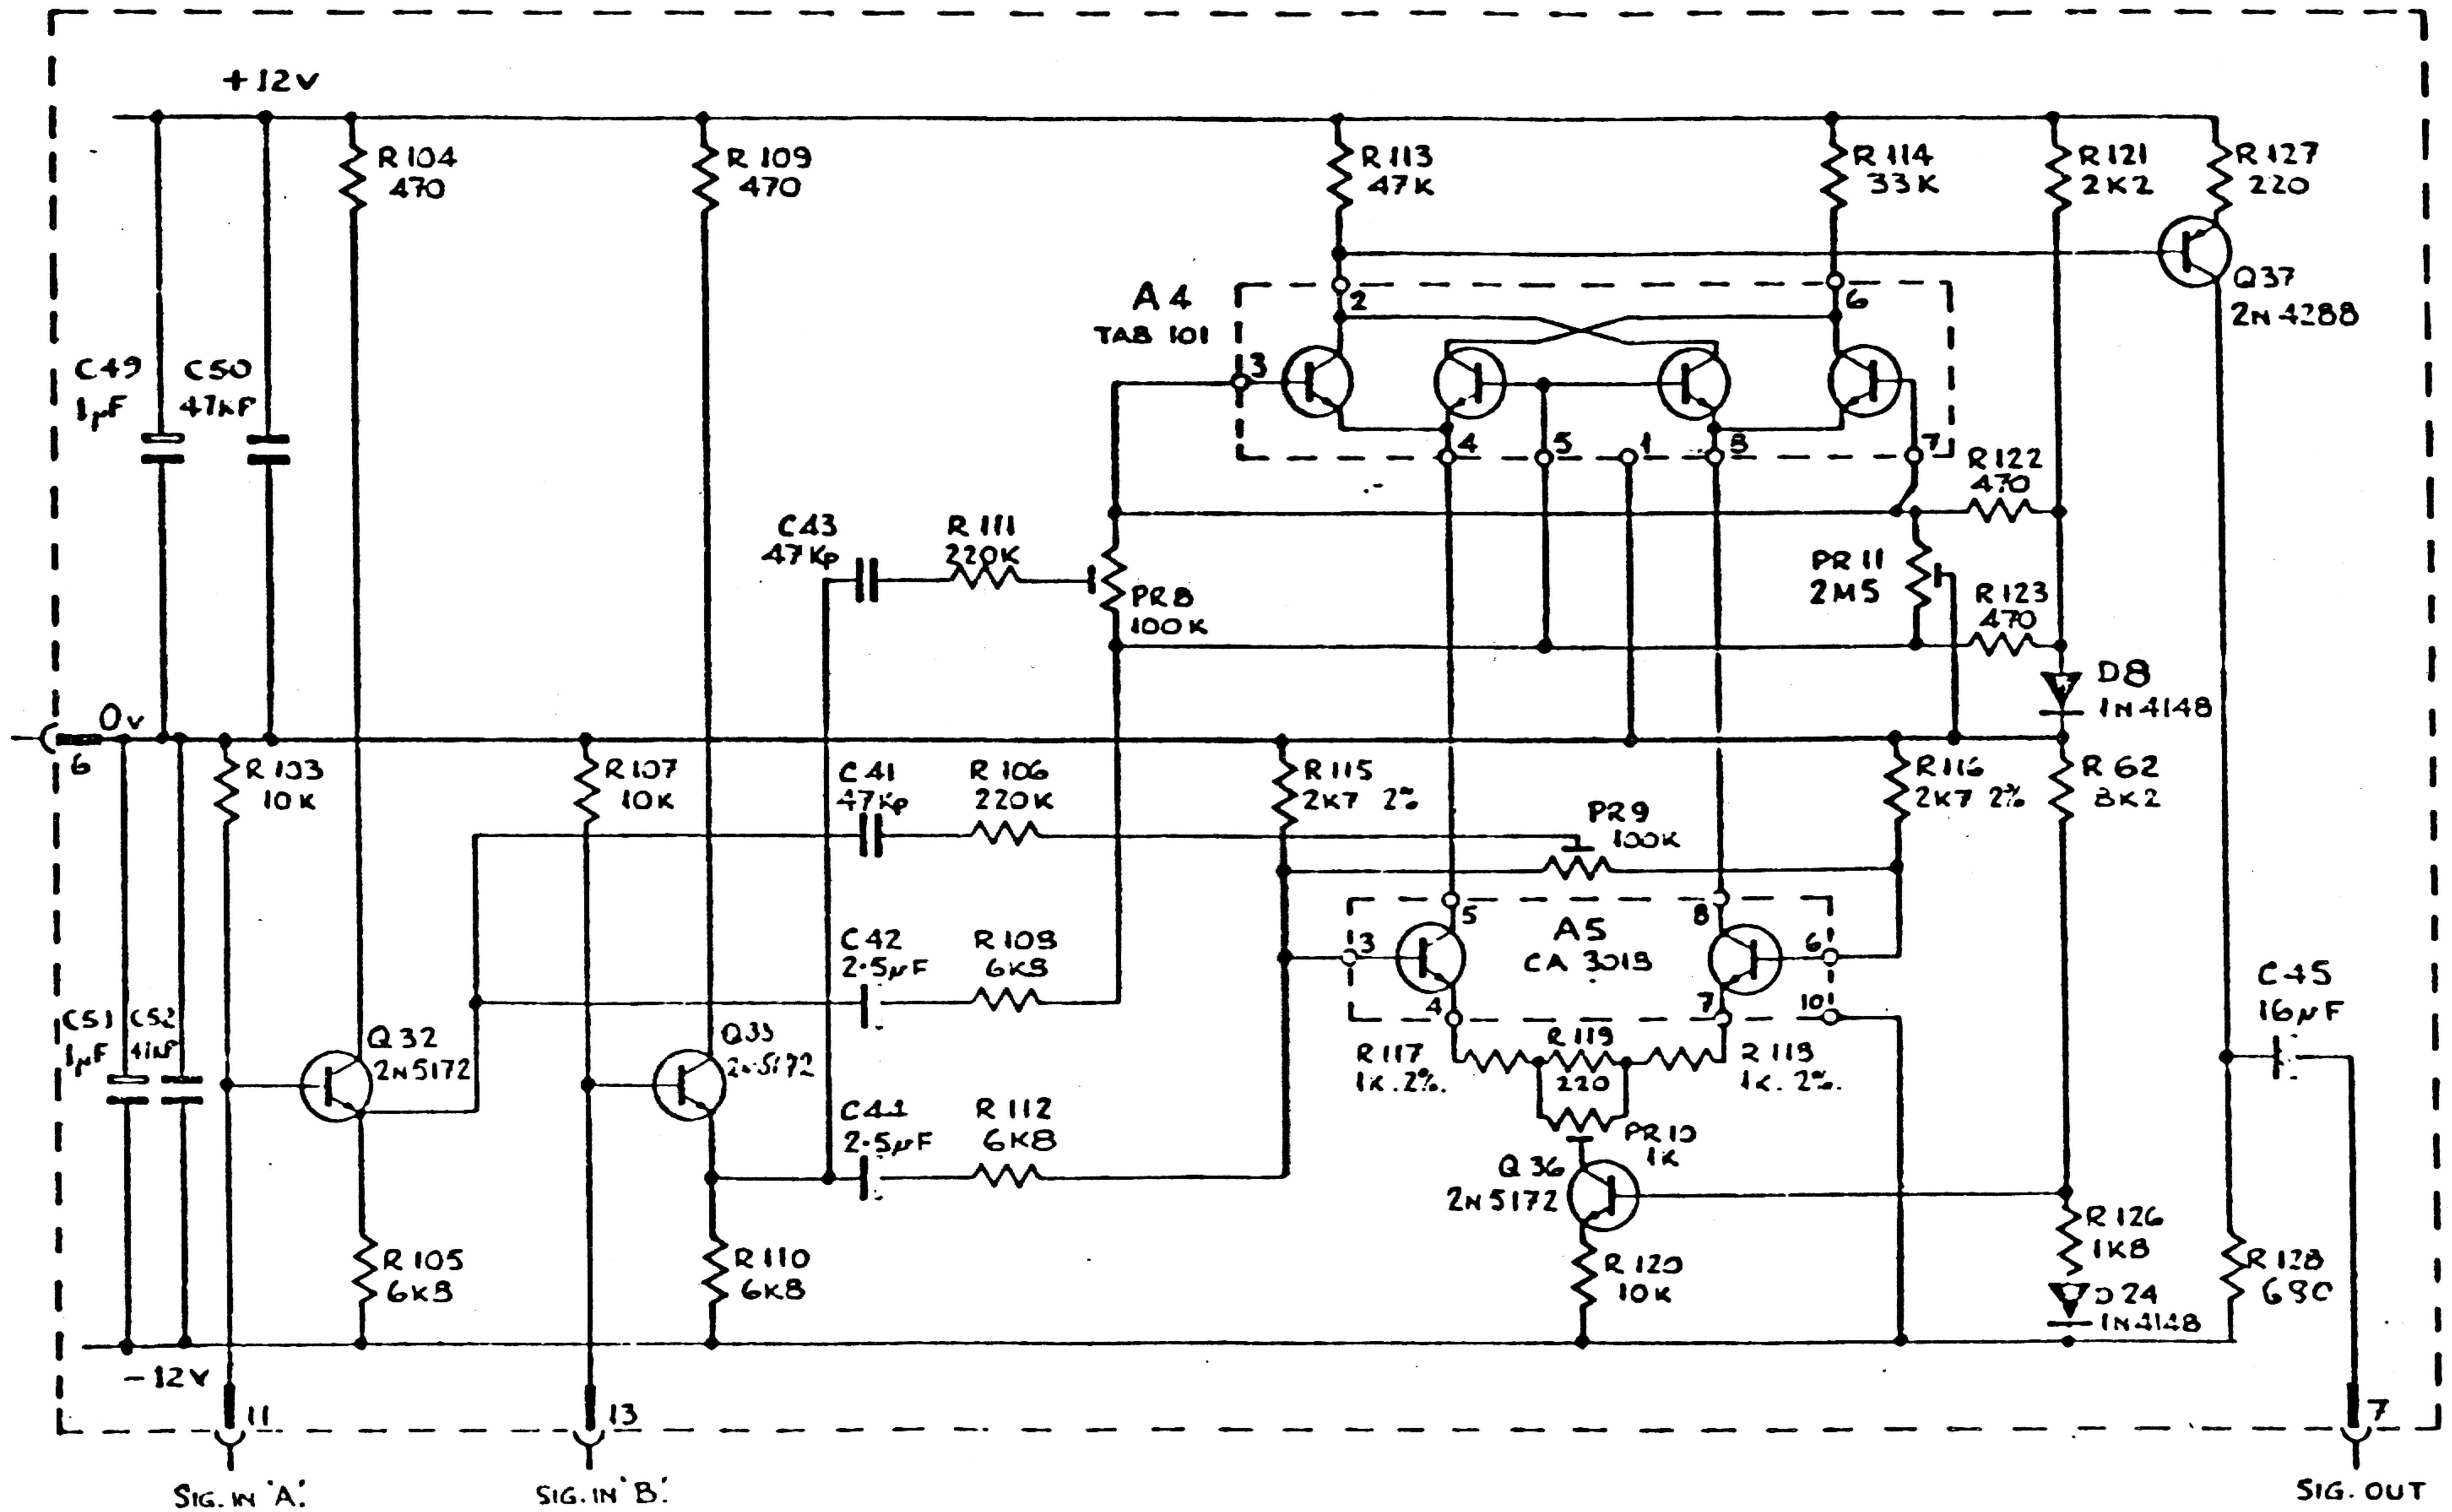

CIRCUIT DIAGRAM RING MODULATOR DRG. NO. EMS 32/00/2.
 ISSUE C
 ELECTRONIC MUSIC STUDIOS (BOURNEMOUTH) LTD.

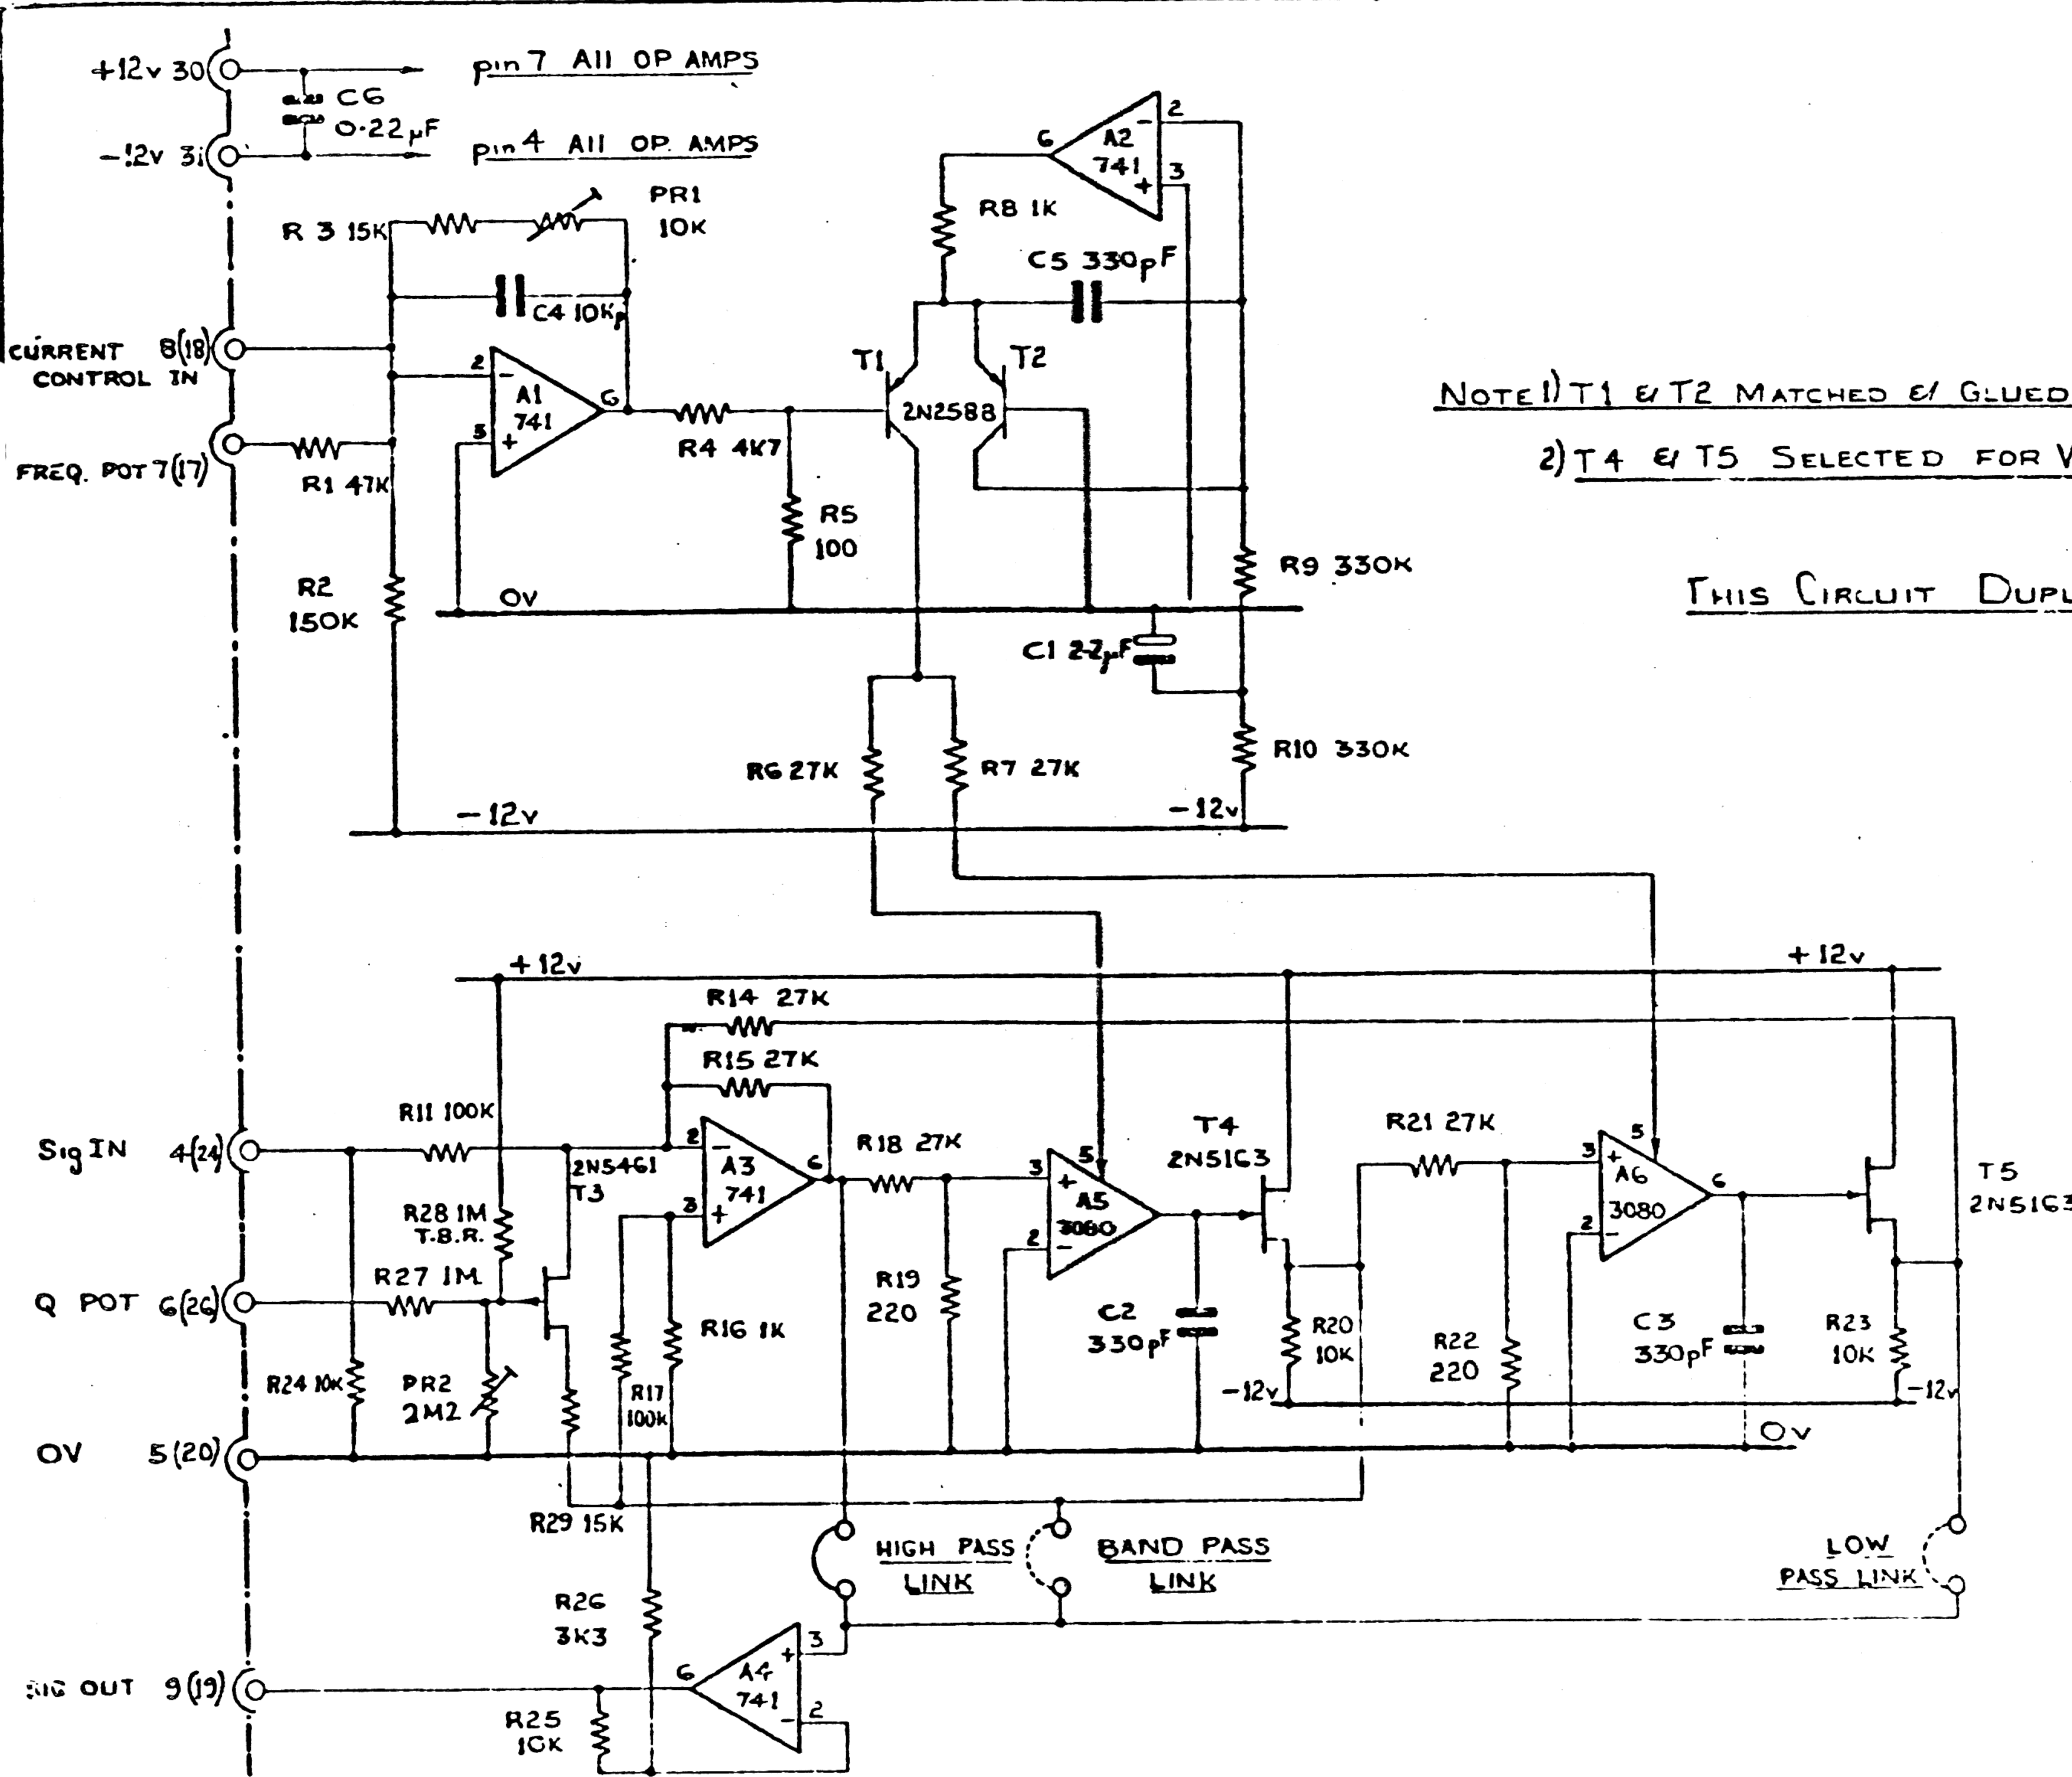


NOTE 1) T1 & T2 MATCHED & GLUED TOGETHER

2) T4 & T5 SELECTED FOR V_p 2.5V-3.0V

THIS CIRCUIT DUPLICATED ON 34/01 P.C.B


HILTON ELECTRONIC IWAREHAM LTD			
TITLE HIGH PASS FILTE SYNTHI 100			
SSR	DRN	DATE	MAT L
✓	MB	17/10/73	✓
			FINISH
			✓
DRG N		32/01	

pin 15 did read pin 13
 22.7.71.
 C Q6, Q8 WEREN'T SHOW
 CONNECTED TO OV.

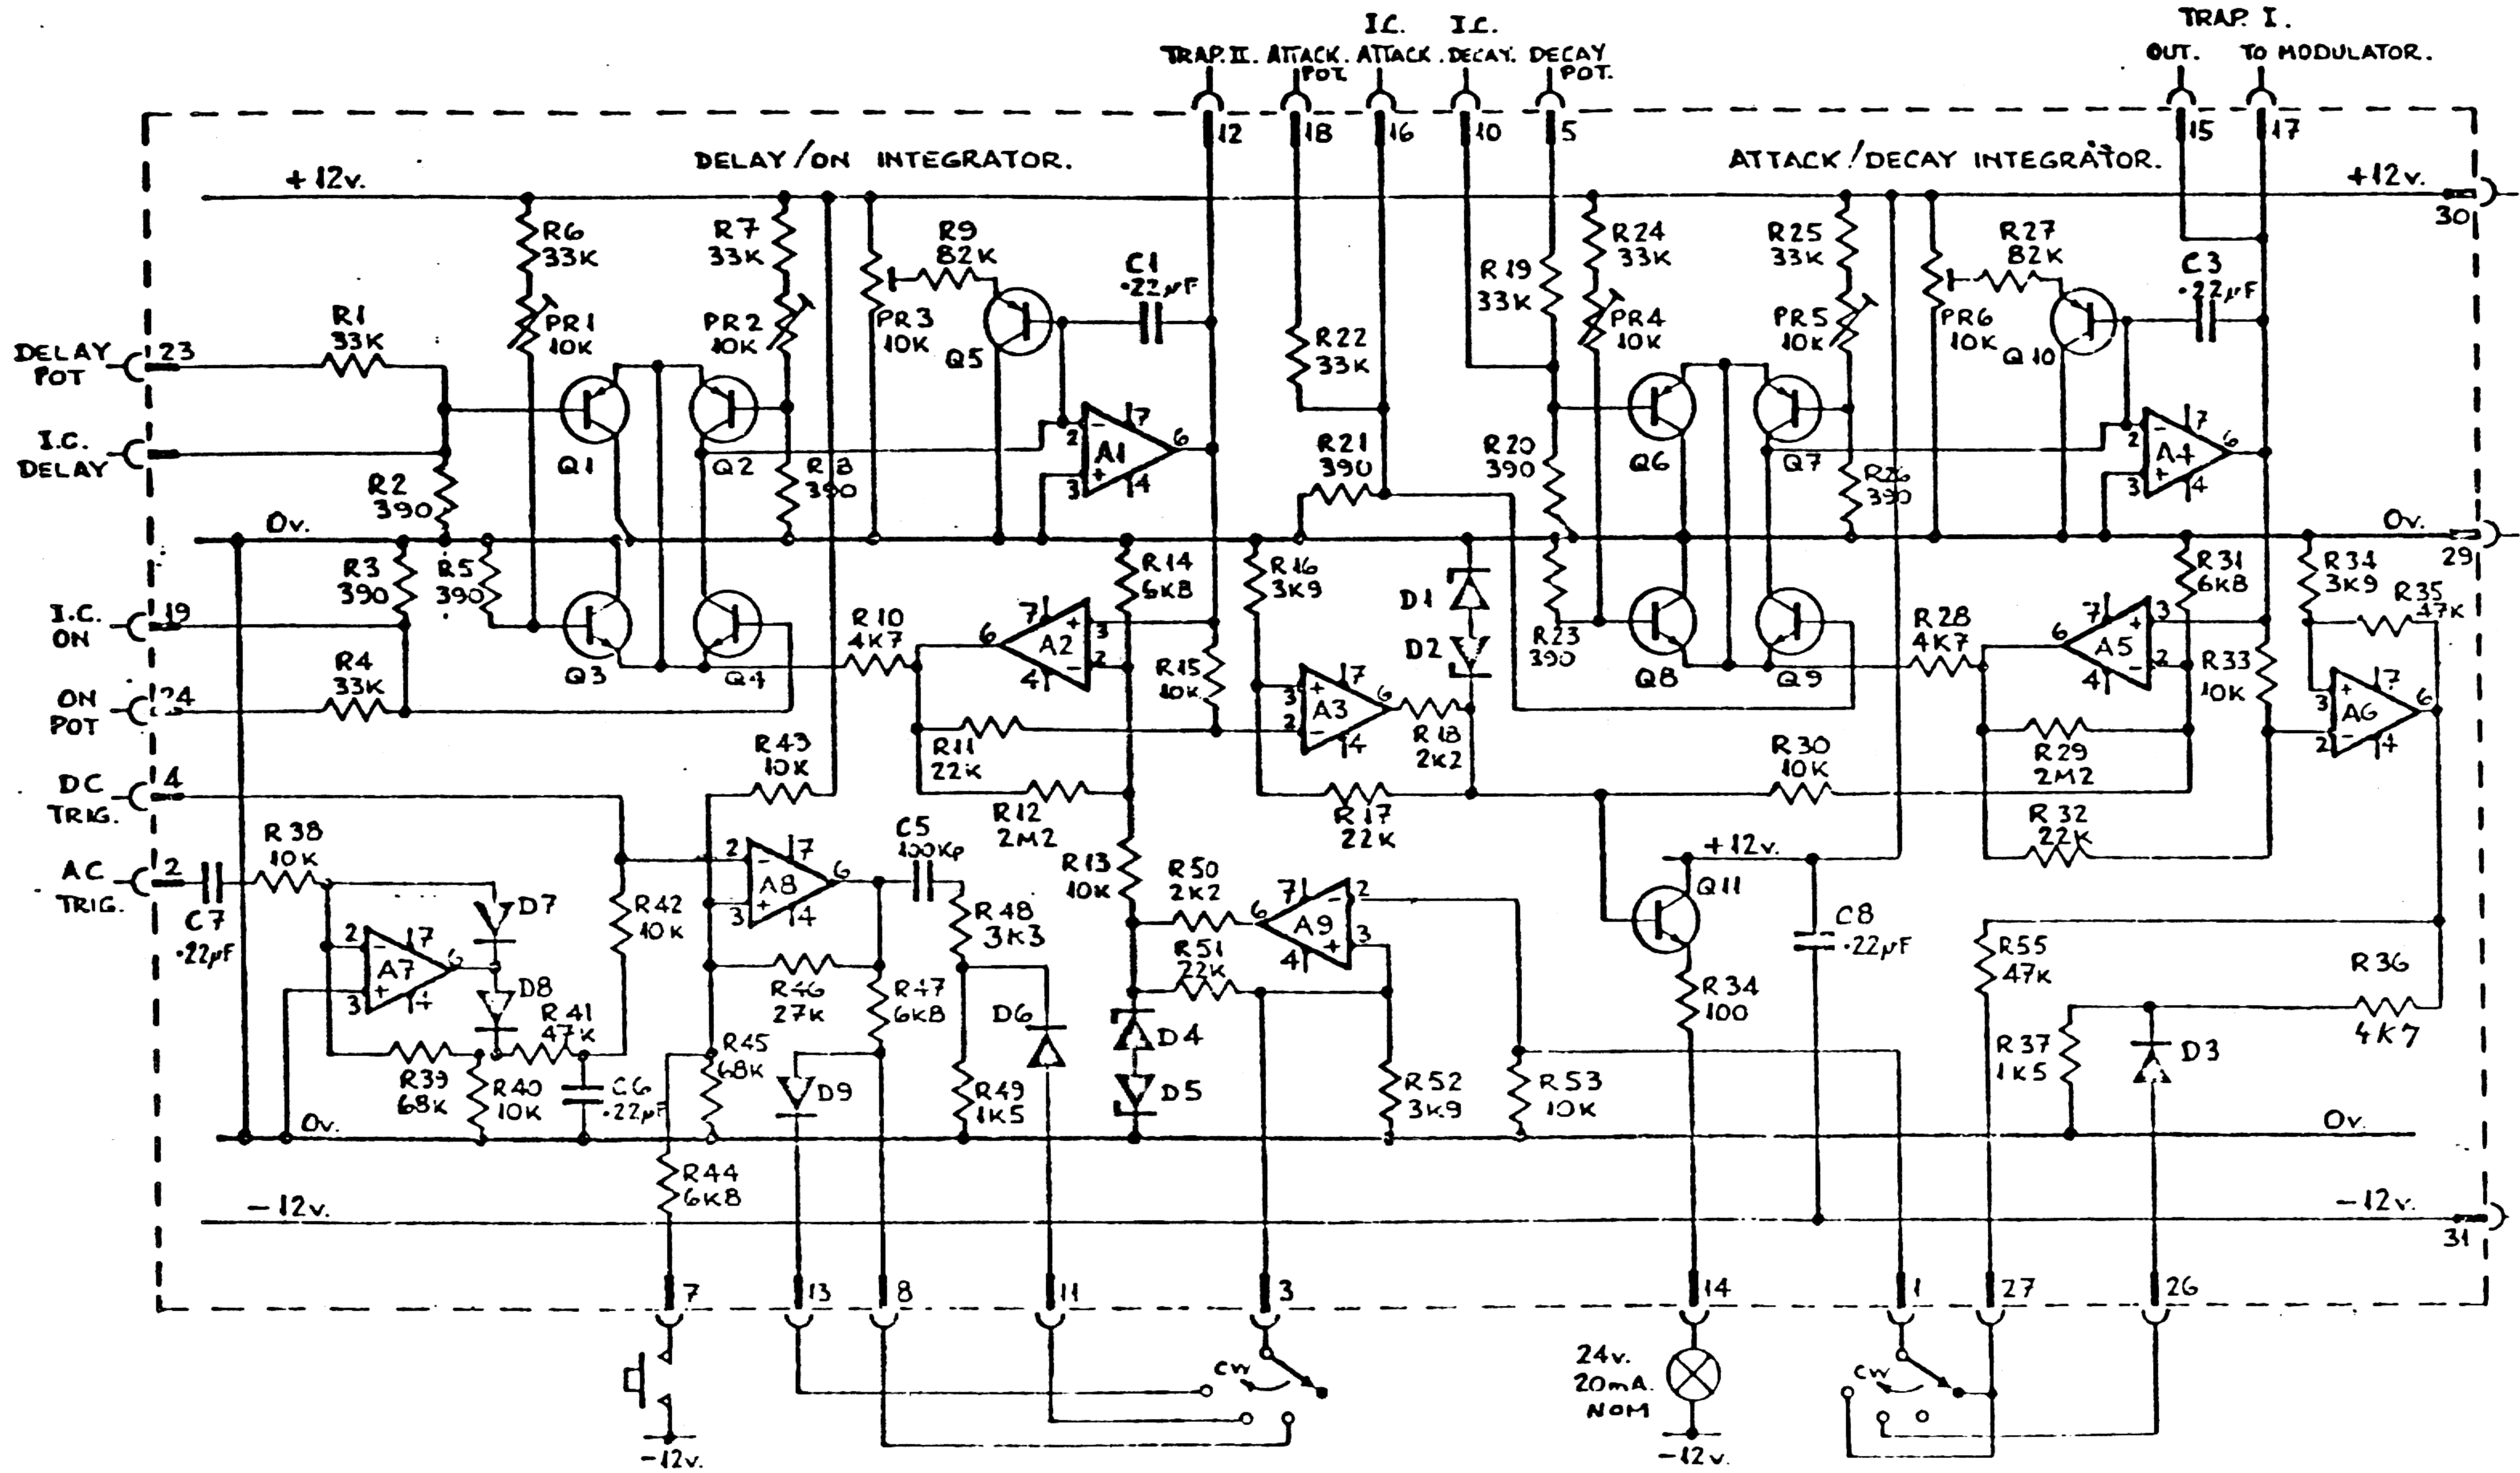

A1 & A9 INCL. ML 741C (PIN 7 to +12v, PIN 4 to -12v).
 D1,2,4,5. 62v ZENER HS 2062.
 D3,6,7,8. SILICON HS 1395.
 Q3,4,8,9,11. 2N 5172.
 Q1,2,5,6,7,10. 2N 4288.

CIRCUIT DIAGRAM TRAPEZOID ENVELOPE SHAPER. DRG. N° EMS 32/02
 ELECTRONIC MUSIC STUDIOS () LTD. ISSUE # C
 B

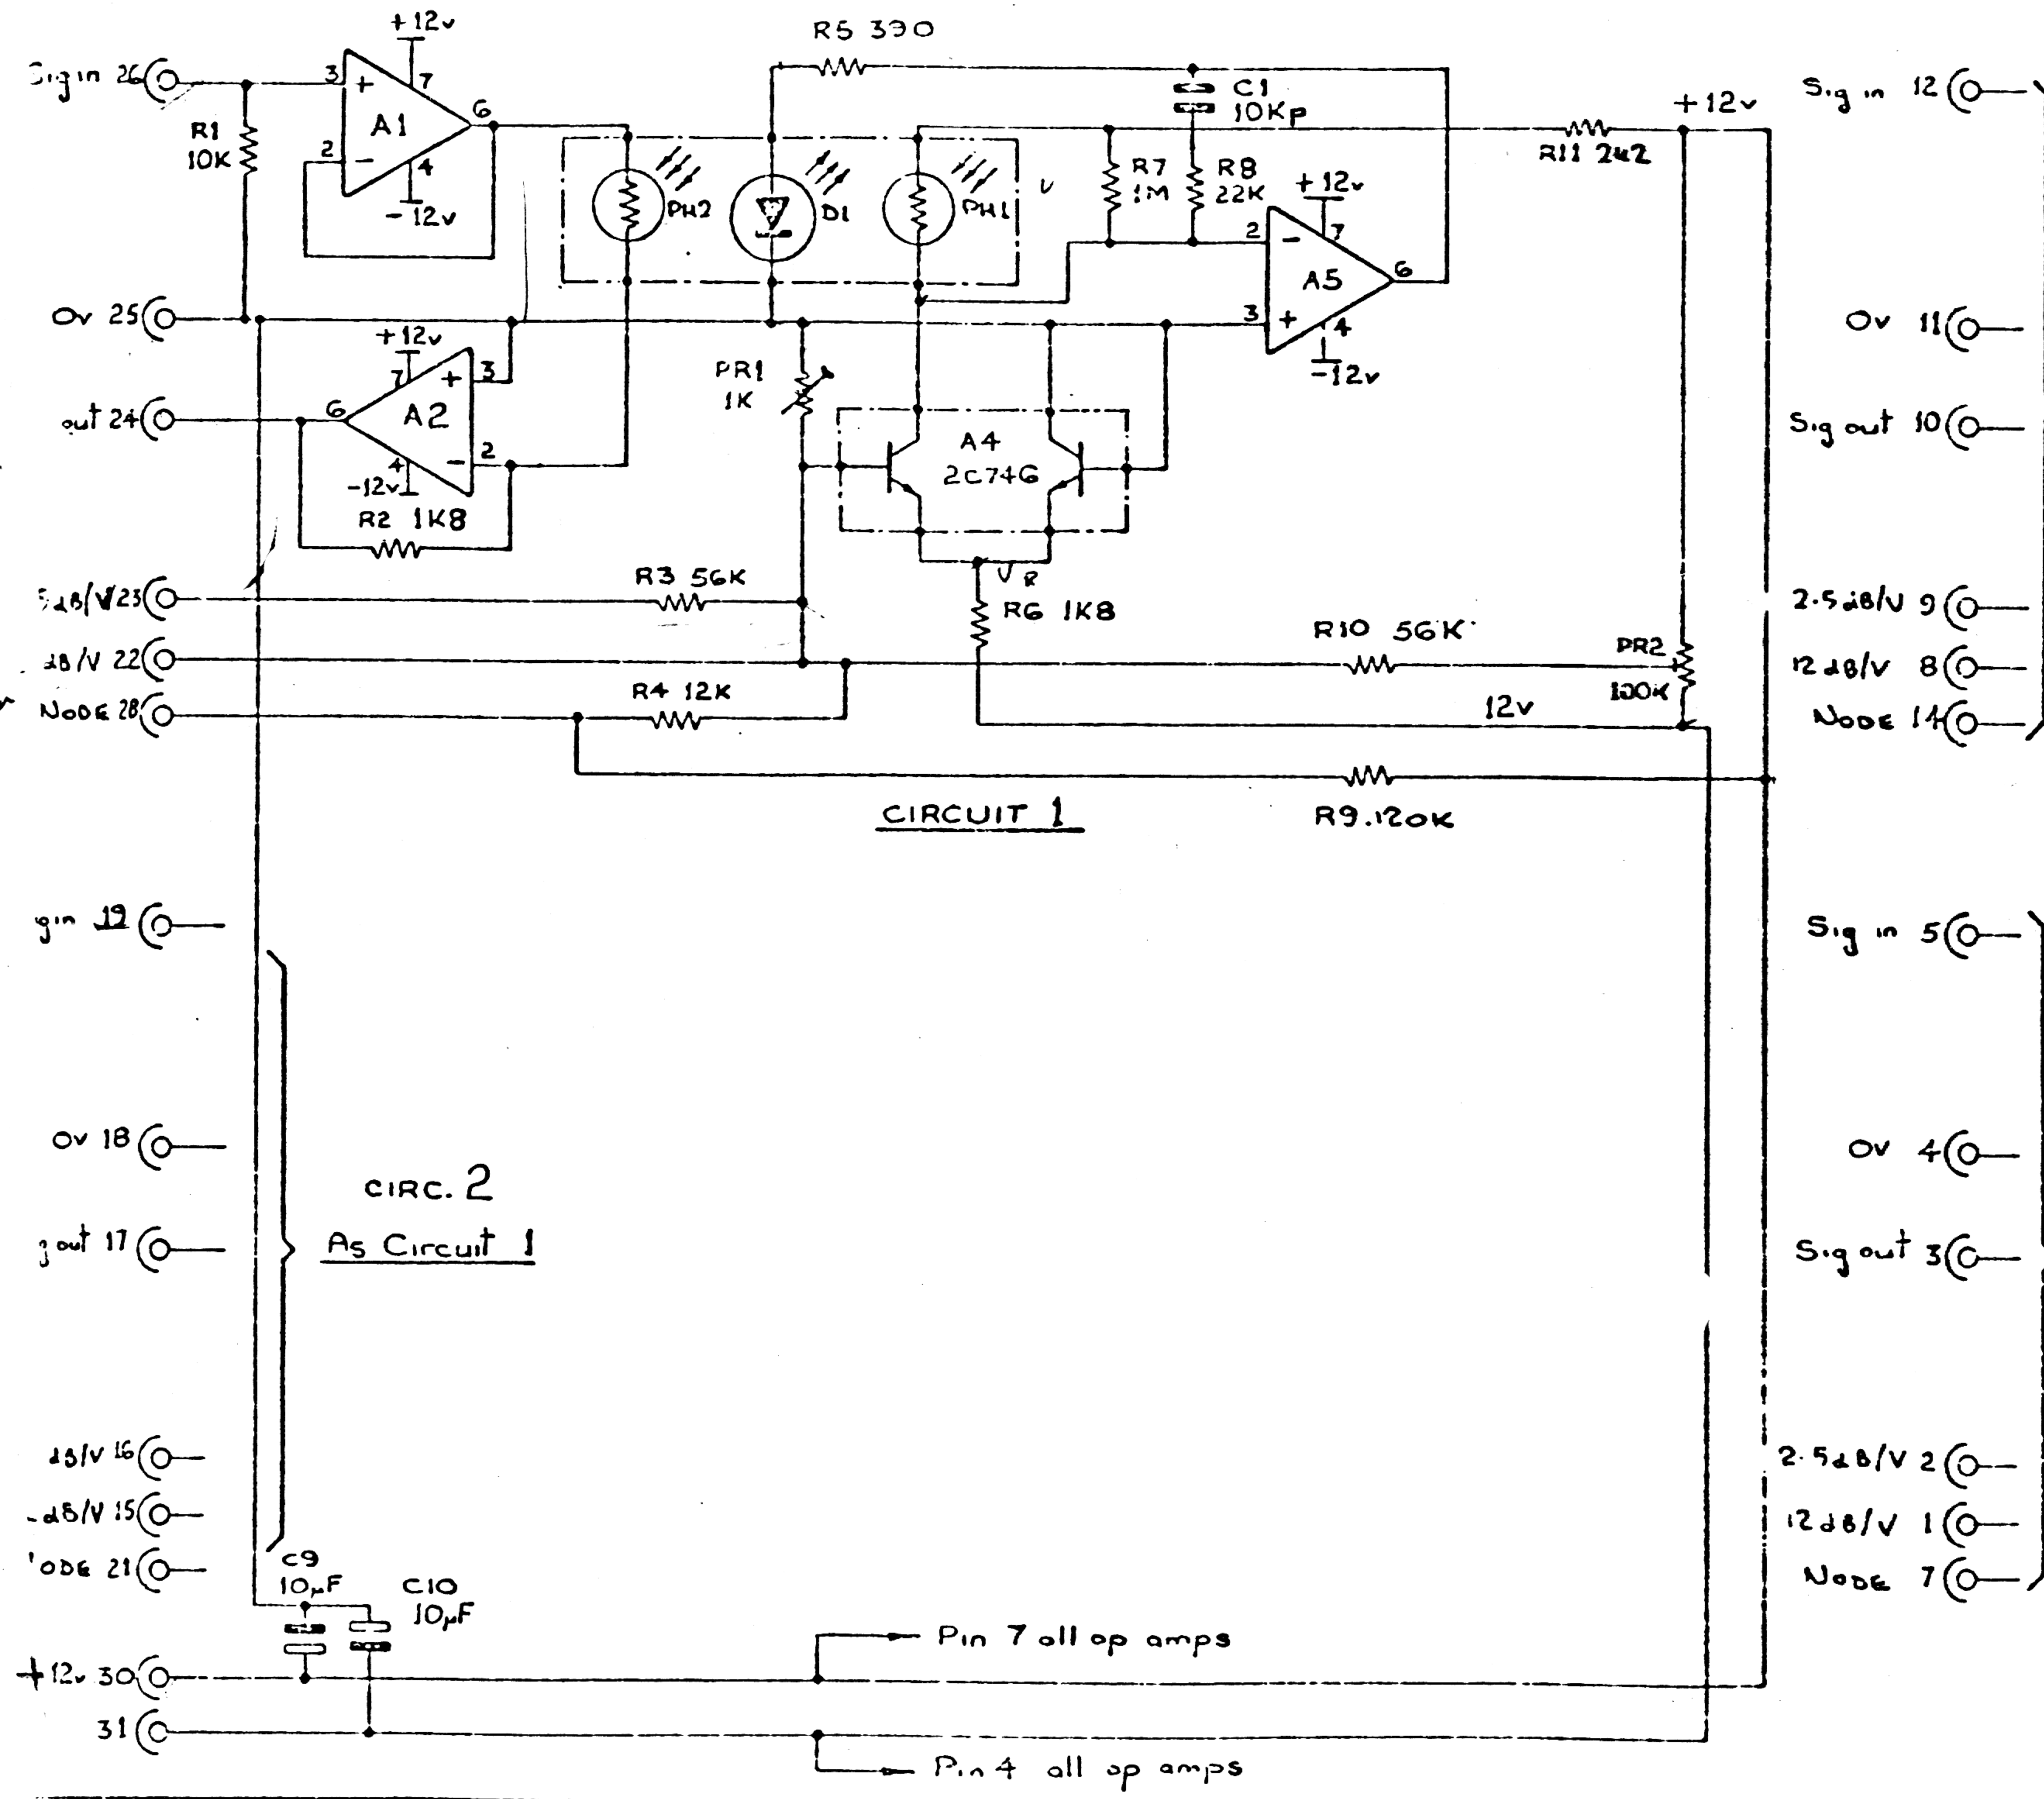


CIRC. 3
As Circuit 1

CIRC. 4.
As Circuit 1


HILTON ELECTRONICS (WAREHAM) LTD			
TITLE <u>Quad Log Photo Modulator</u>			
ISSUE	REV	DATE	MAT L
A	M	2/75	/
B	E	2/75	/
			FINISH
			/
DRG NO			32/03

B R33 WAS R31X
 Q12 WAS Q11X
 POSITION R32 C15 REV
 ALEC M 15.4.71

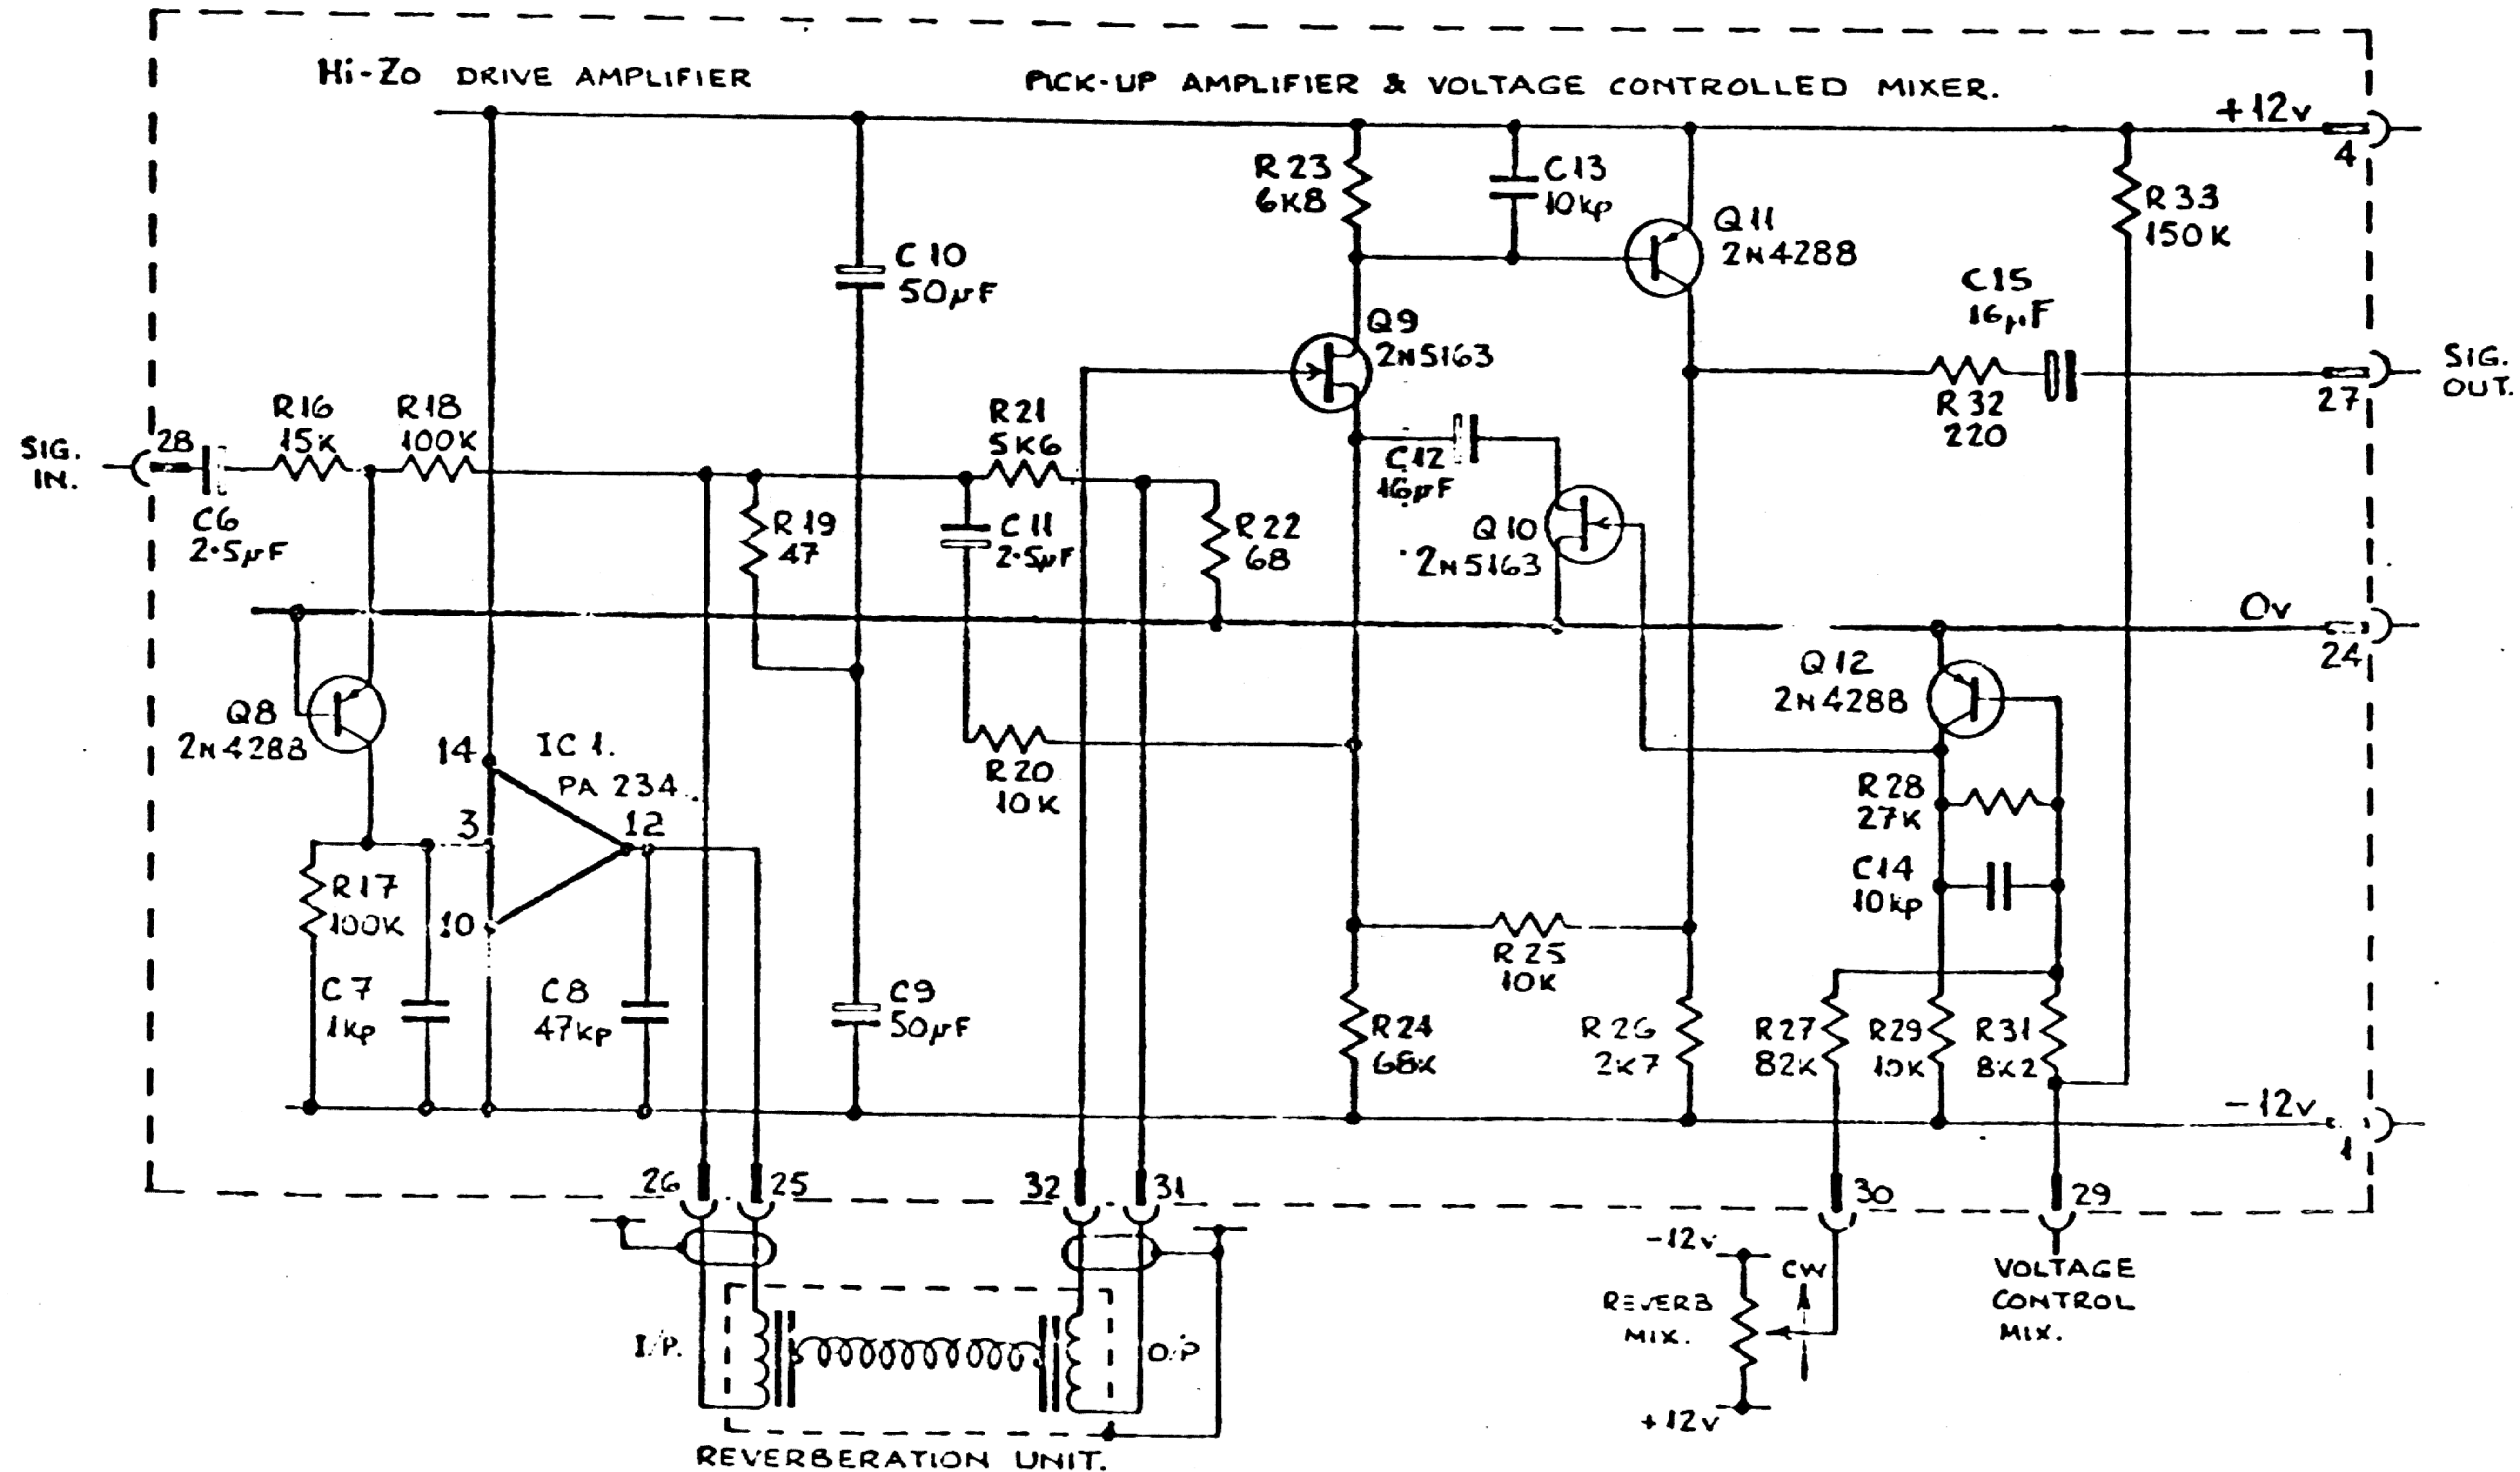

CIRCUIT DIAGRAM REVERB DRIVE

DRG. NO. EMS 32/04
 ISSUE F

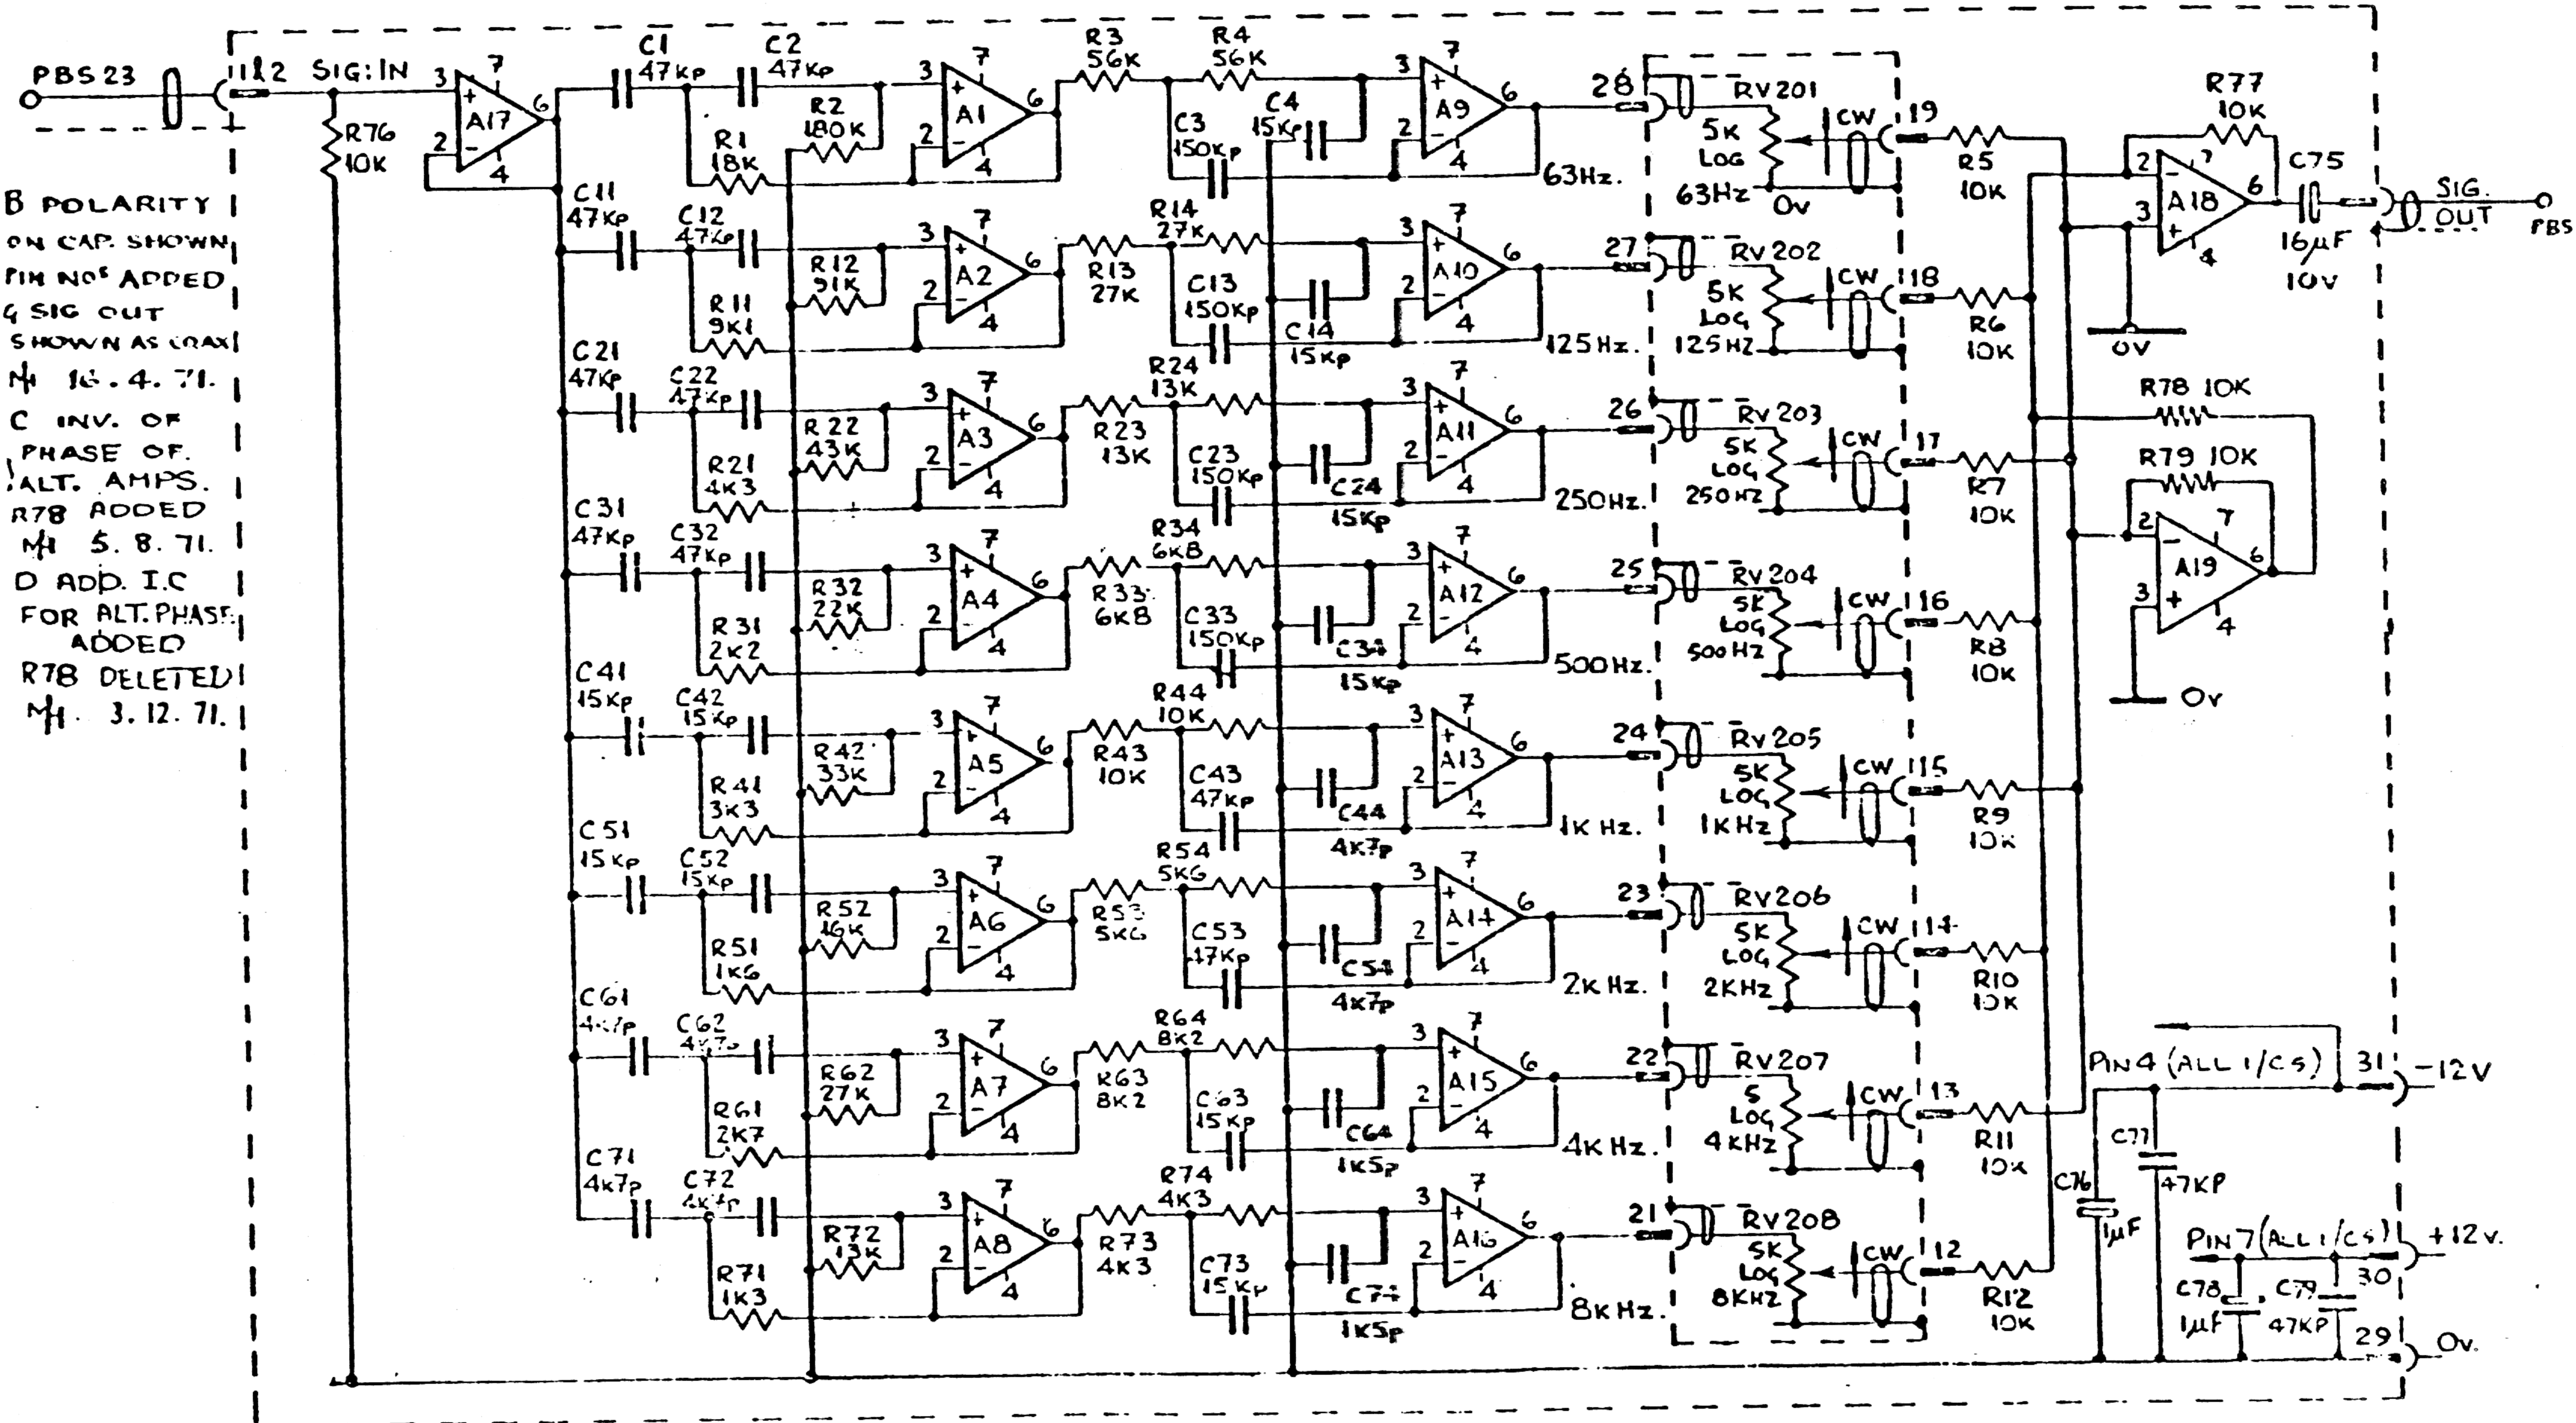


B POLARITY ON CAP. SHOWN, PIN NO'S ADDED, SIG OUT SHOWN AS MAXI
M 16.4.71.
C INV. OF PHASE OF ALT. AMPS. R78 ADDED M 5.8.71.
D ADD. I.C FOR ALT. PHASE ADDED R78 DELETED M 3.12.71.

- NOTE.**
1. POSITION 2D ON SYNTHI 100
 2. MODULE WIRING SEE DRG EMS 31/13
 3. C1 - C74 PLASTIC FILM 10%

EMS.
CIRCUIT DIAGRAM OCTAVE FILTER BANK. DRG N° 32/05 ISSU
ELECTRONIC MUSIC STUDIOS (BOURNEMOUTH) LTD.

B R.278 ADDED.
 M 16.4.71.
 C P.211 WAS
 220K
 'X' NOS REPLACED
 R154 ADDED J.R.
 C65 WAS 47KP
 Q74 & Q75 WERE
 BC169C.
 M 27.4.71.
 D R281 ADDED
 R211 WAS 5%
 M 18.6.71
 E Table Added
 Mod. Filed.
 M 28.6.71.
 F R154 WAS 47K.
 R166 WAS 47K
 M 11.8.71.
 G C.N. 51
 M 31.7.73.

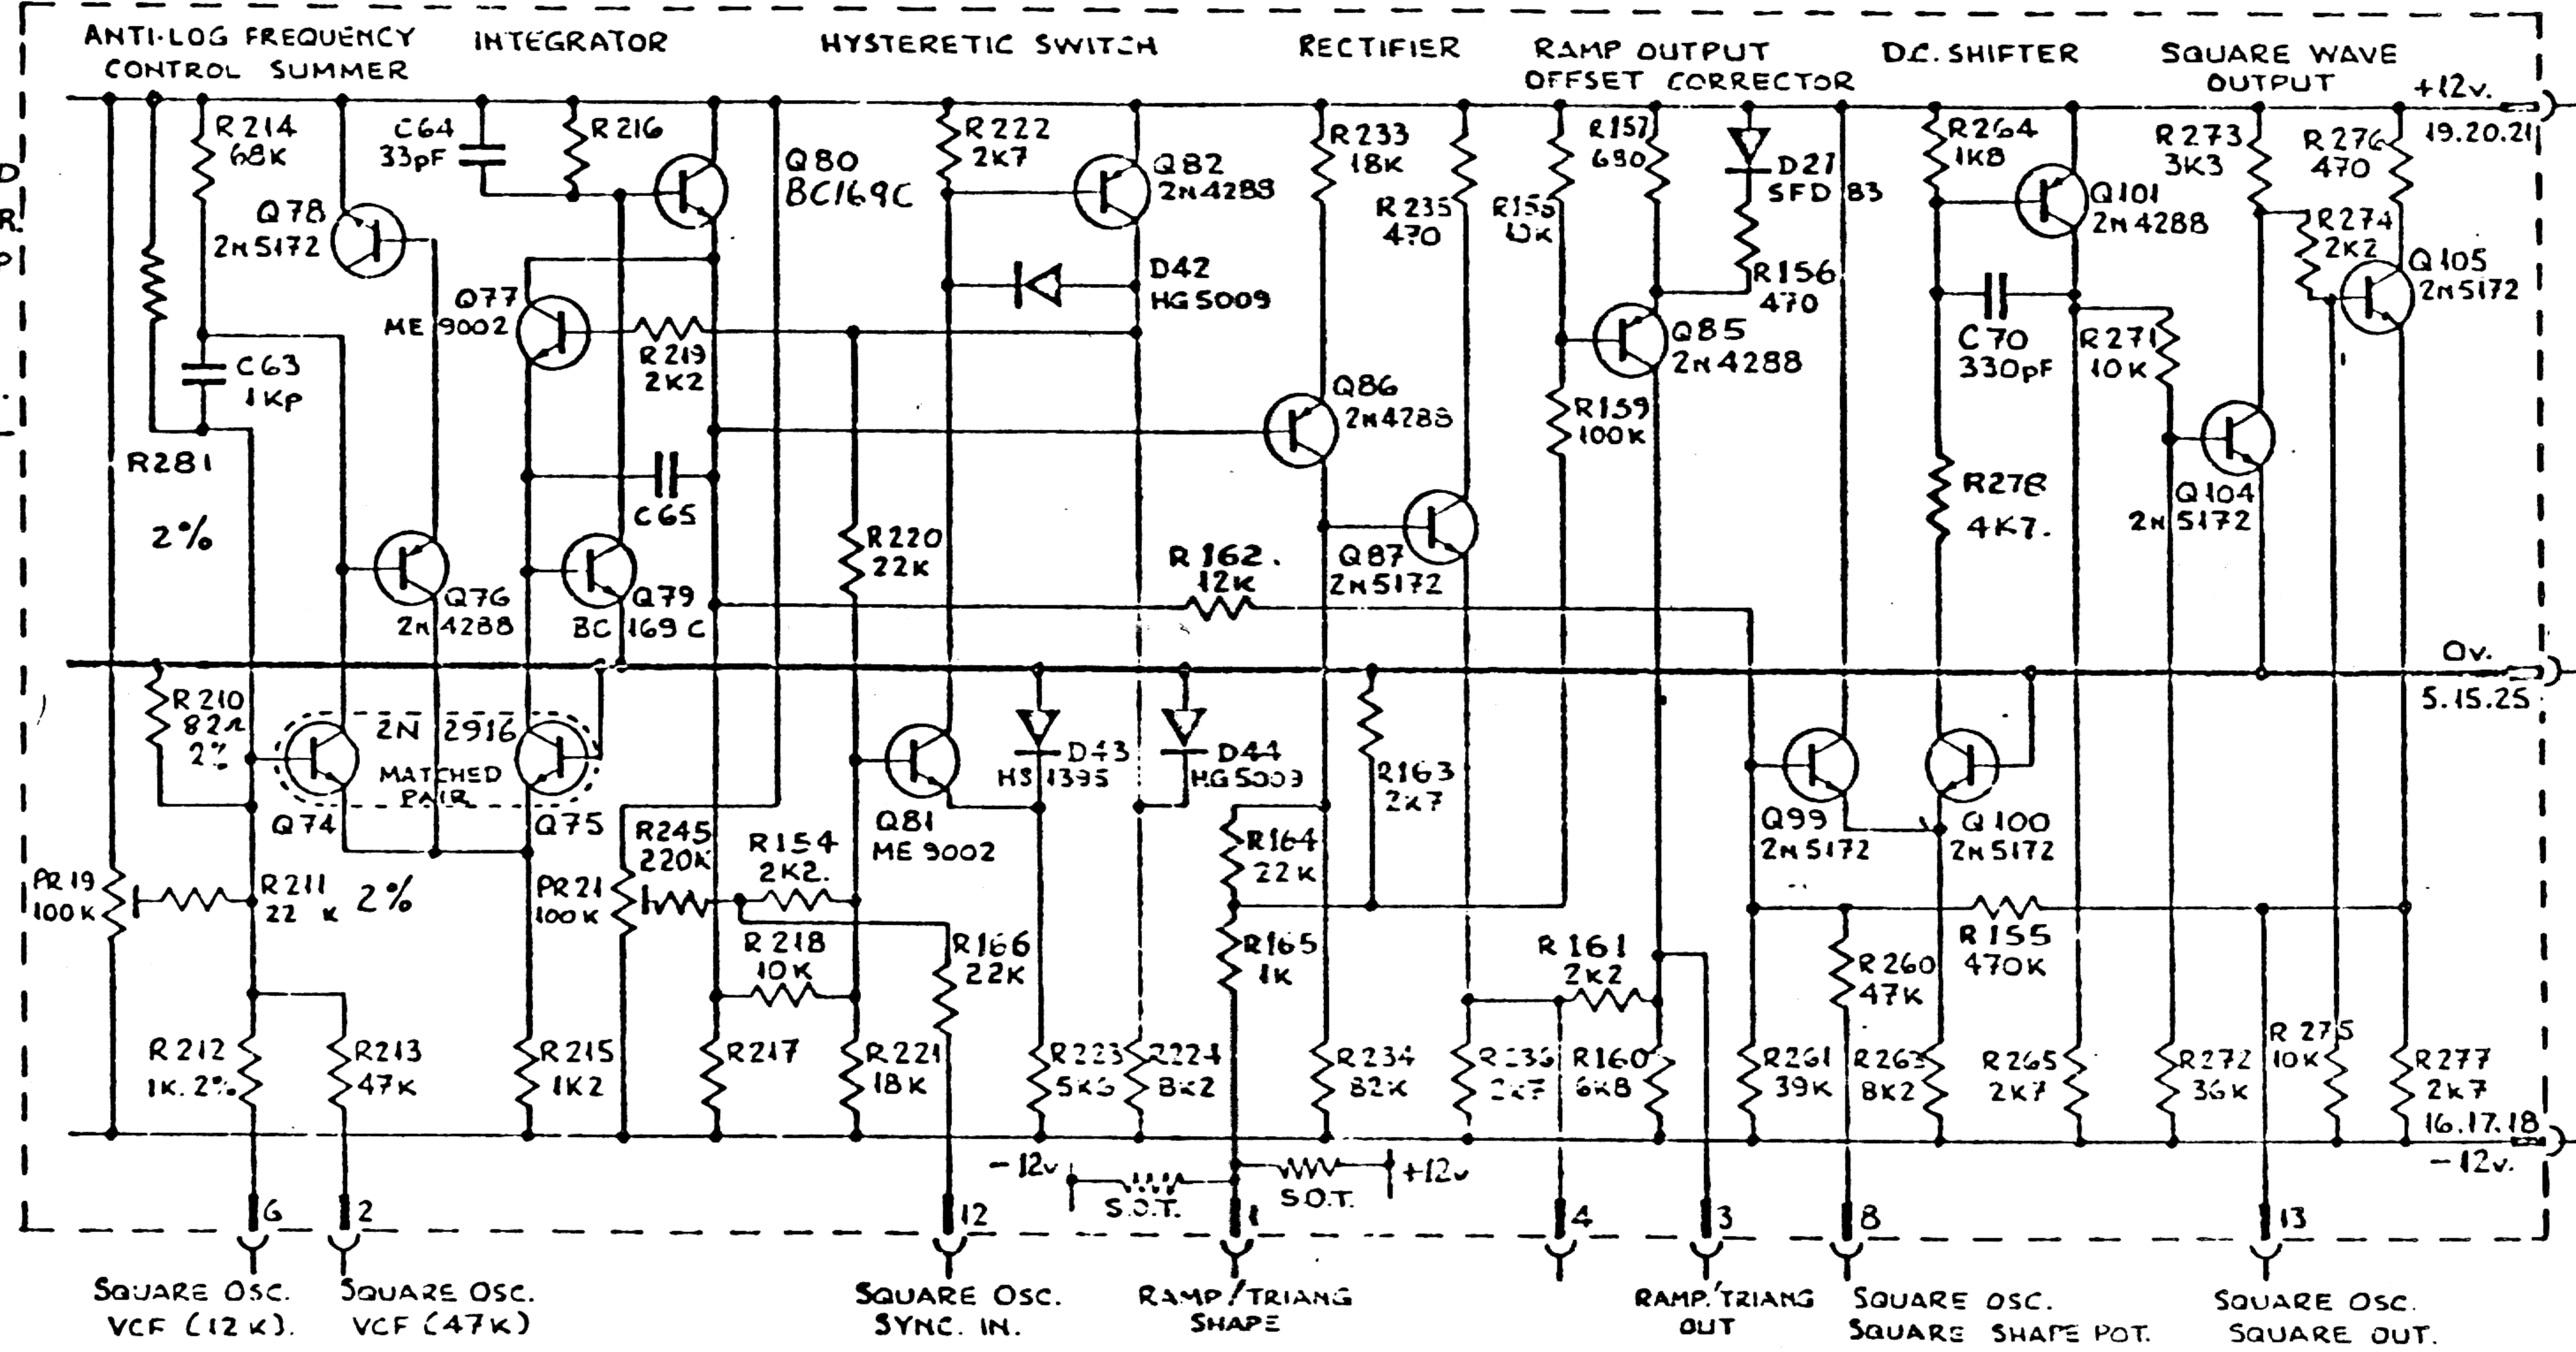

Boards	C65	R217	R216	R281
A	10KP	4K7	120K	27K
B	10KP	4K7	120K	27K
C	10KP	4K7	120K	27K
D	1M F	22K	470K	15K
E	1M F	22K	470K	15K
F	1M F	22K	470K	15K

B Connection from pin 23 To junction of R205 & C62X ADDED.

M 16.4.71.


C R176 WAS 220K 'X' NOS REPLACED.

C59 WAS 47KP Q59 & Q60 WERE BC169C ~~77~~ → 27.4.71.

D R280 ADDED. R178 WAS 5% ~~18.6.71~~

F R169 WAS 47K ~~11.8.71~~

G C.N.51 ~~31.7.73.~~

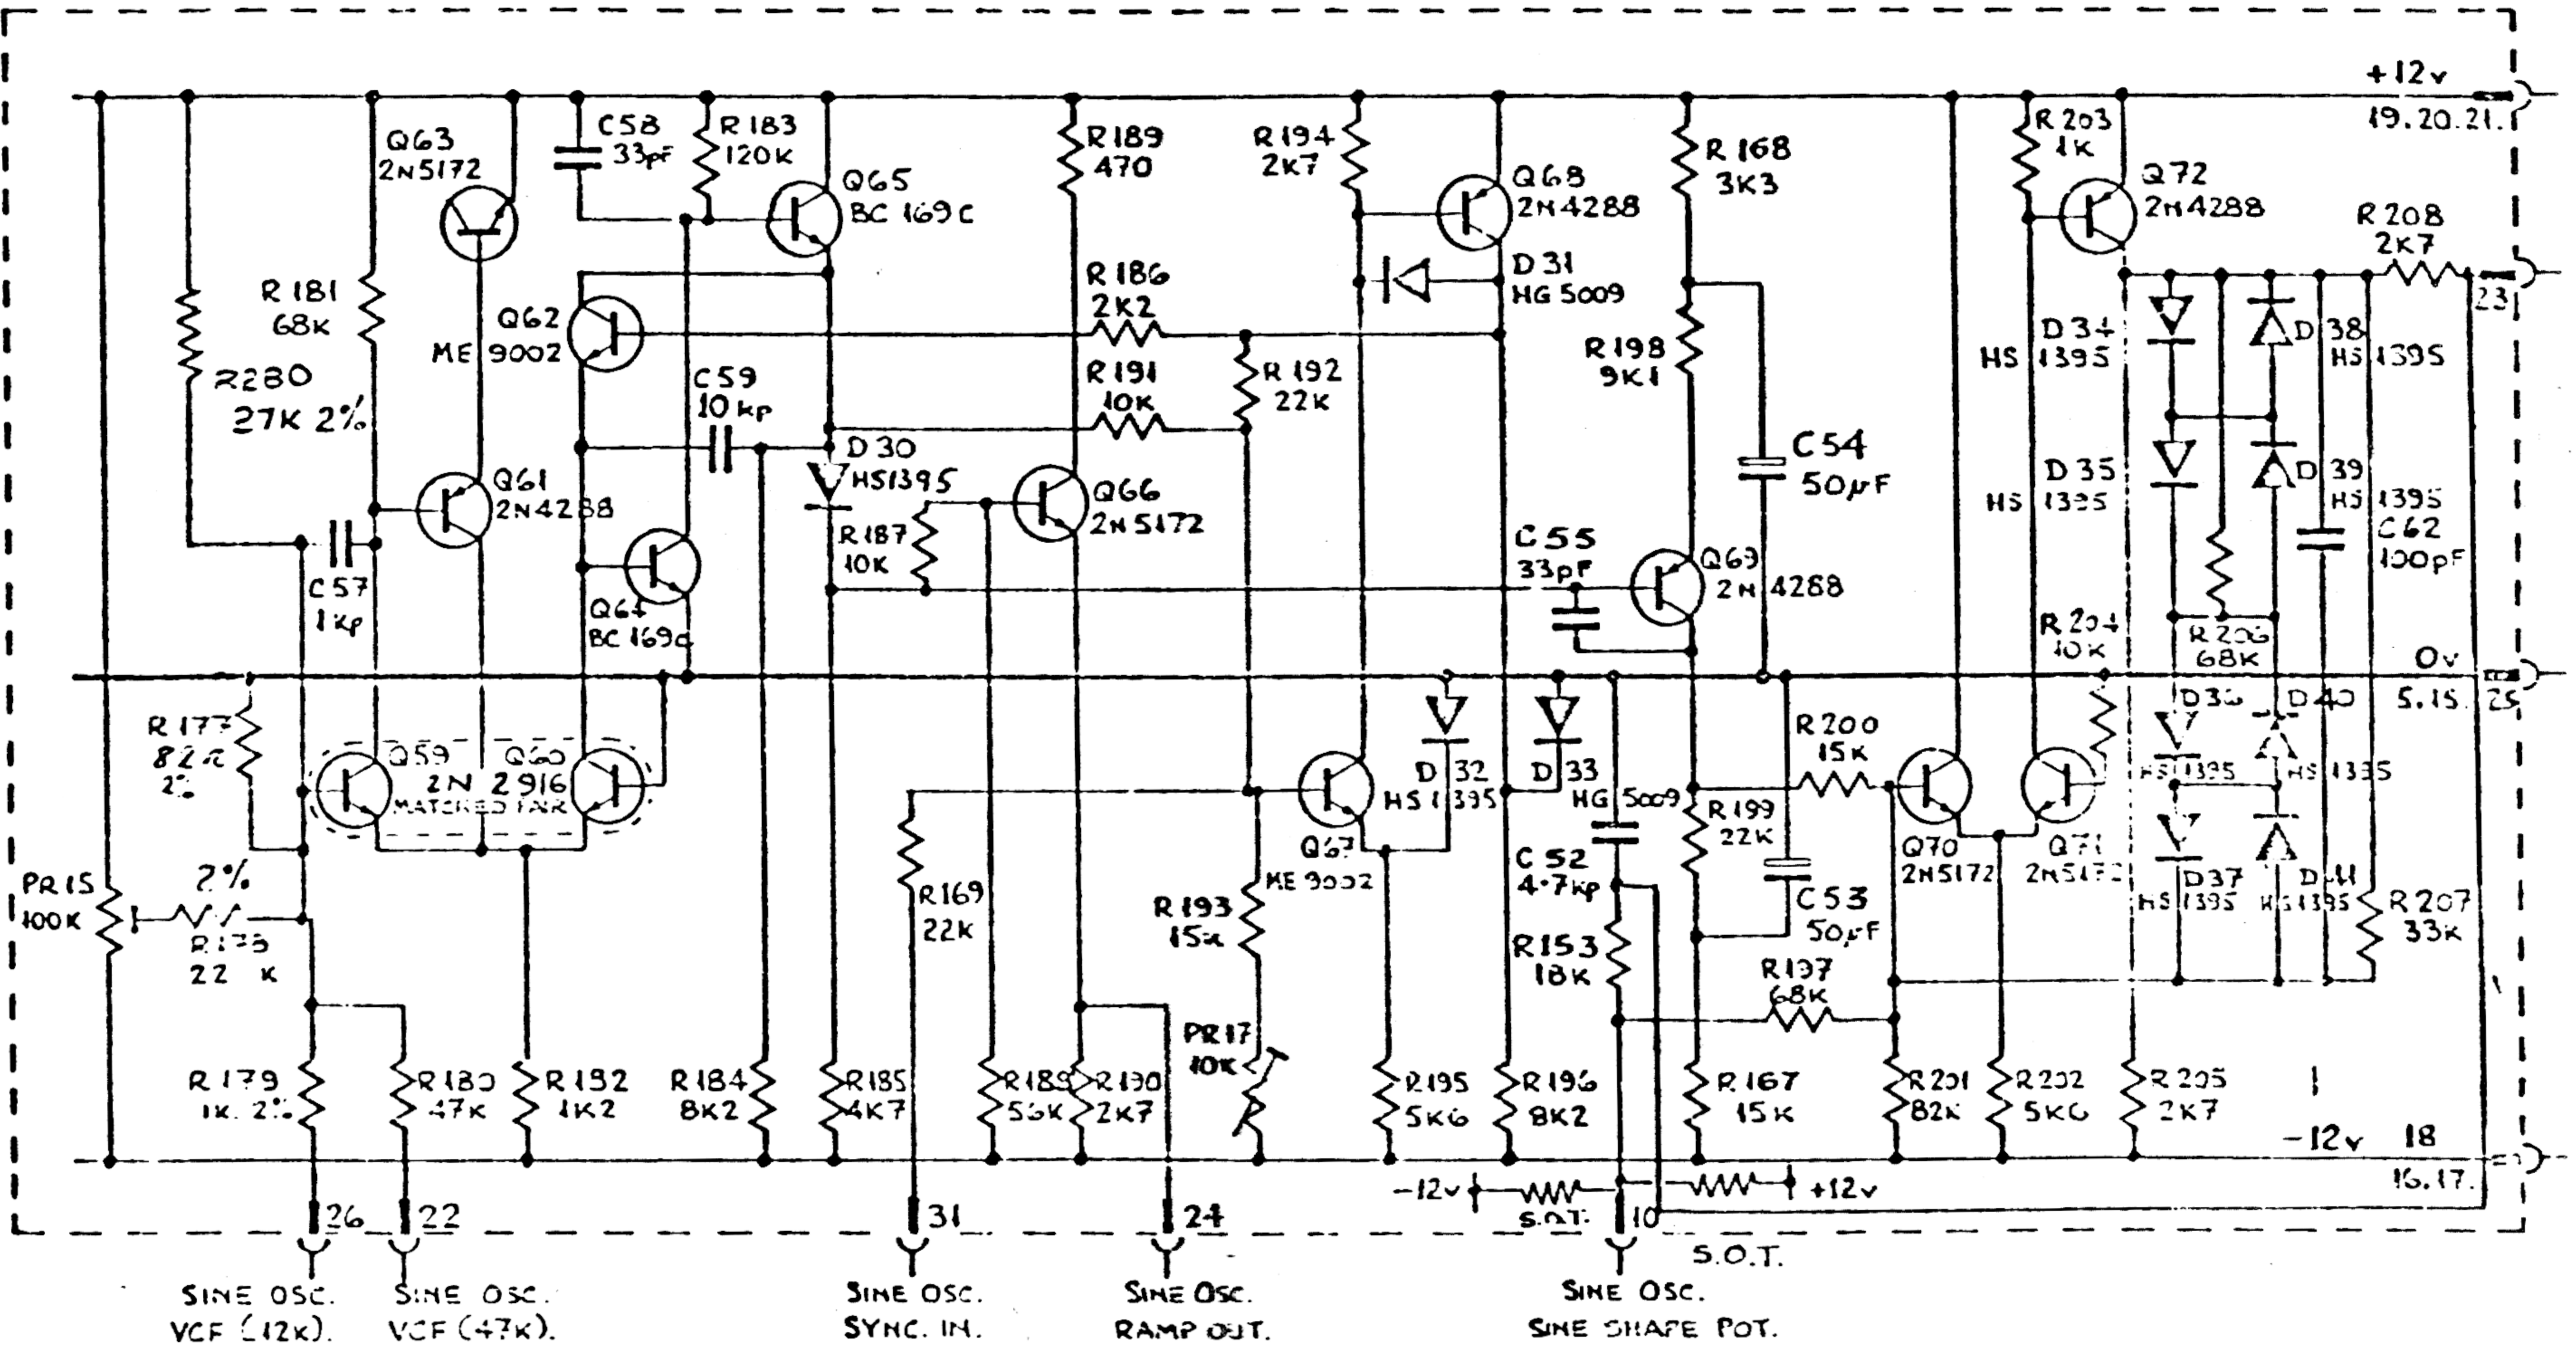

CIRCUIT DIAGRAM SINE/RAMP OSCILLATOR

ELECTRONIC MUSIC STUDIOS (DOURNEMOUTH) LTD.

DRG. N° EMS 32/06


SHT 2 of 3

ISSUE G

C. COX REF. ASSER
7th. 7-5-73.

SEE DRG.
EMS. 32/06/3

SEE DRG.
EMS. 32/06/3

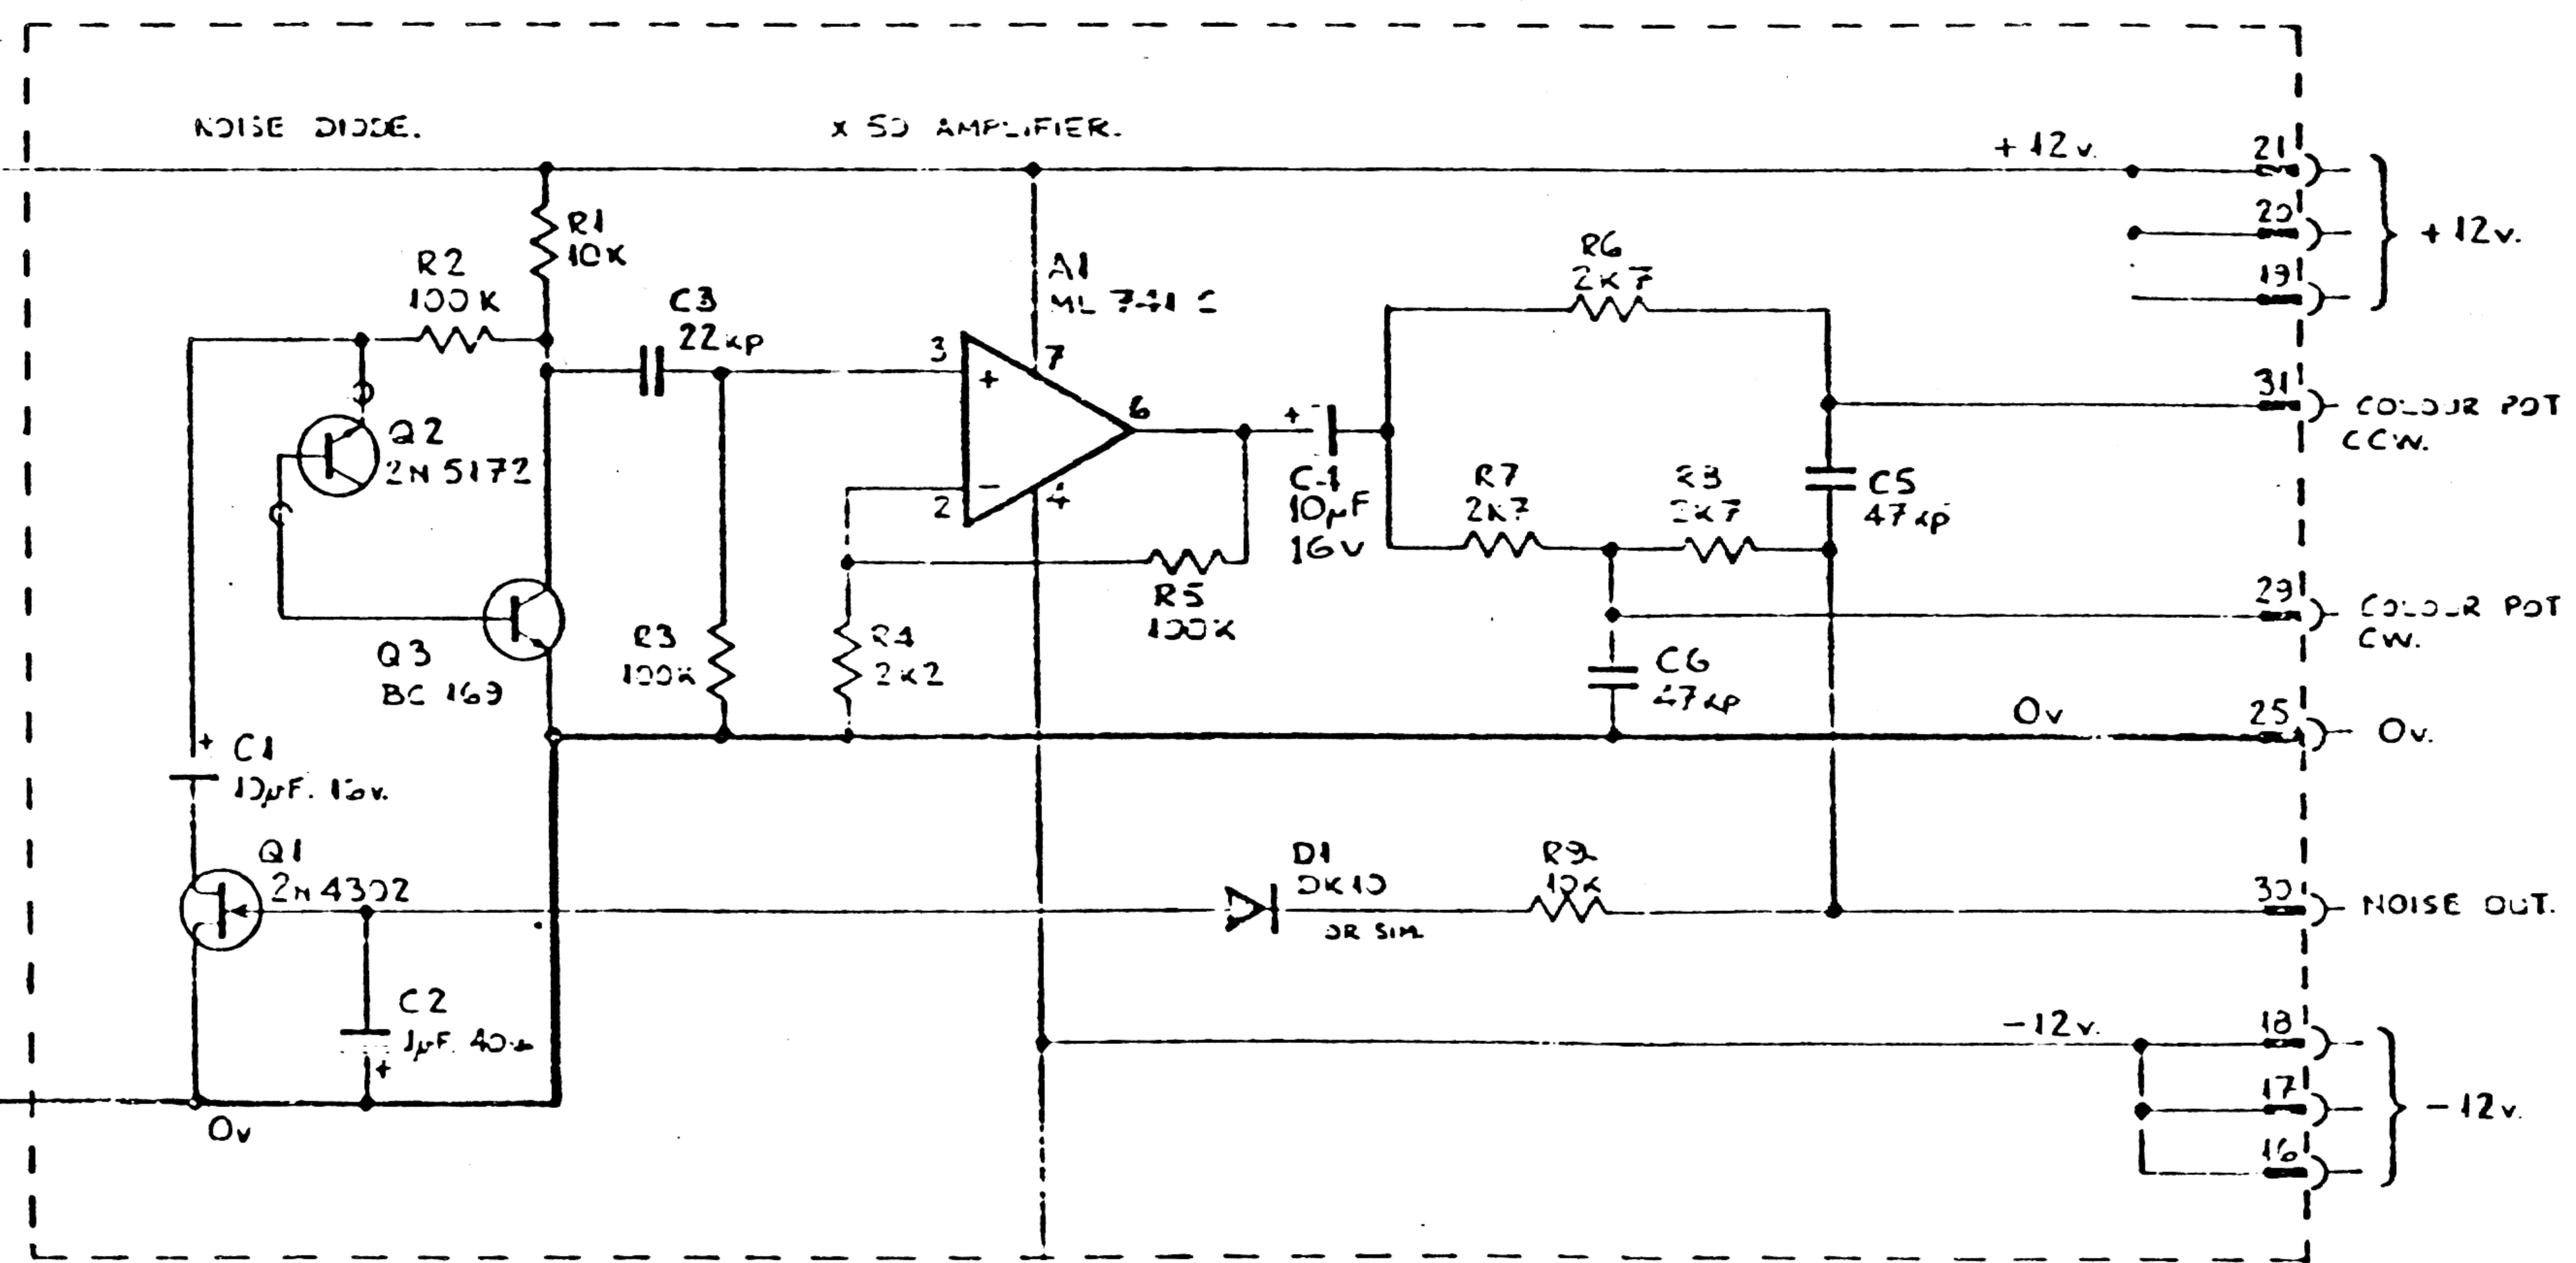


SEE DRG.
EMS. 32/06/3


CIRCUIT DIAGRAM NOISE GENERATOR. DES. BY EMS 32/07
1951E.C.

ELECTRONIC MUSIC STUDIOS (BOURNEMOUTH) LTD.

B C2 WAS 10KPF
 C1 WAS 220KPF
 C4 WAS 1μF
 Q13 WAS 2N4852
 Q21 WAS 2N5163
 CB WAS 10KPF
 R43 WAS 6K8
 Q28 WAS 2N5163
 C12 WAS 10KPF
 R56 WAS 6K8
 D/S OF Q21
 DID GO TO +12V
 D/S OF Q28
 DID GO TO +12V
 M 16.4.71
 C/R68 & R69
 ADDED
 Q13 WAS UT46
 3.12.71
 & C4 WAS 2.5μF

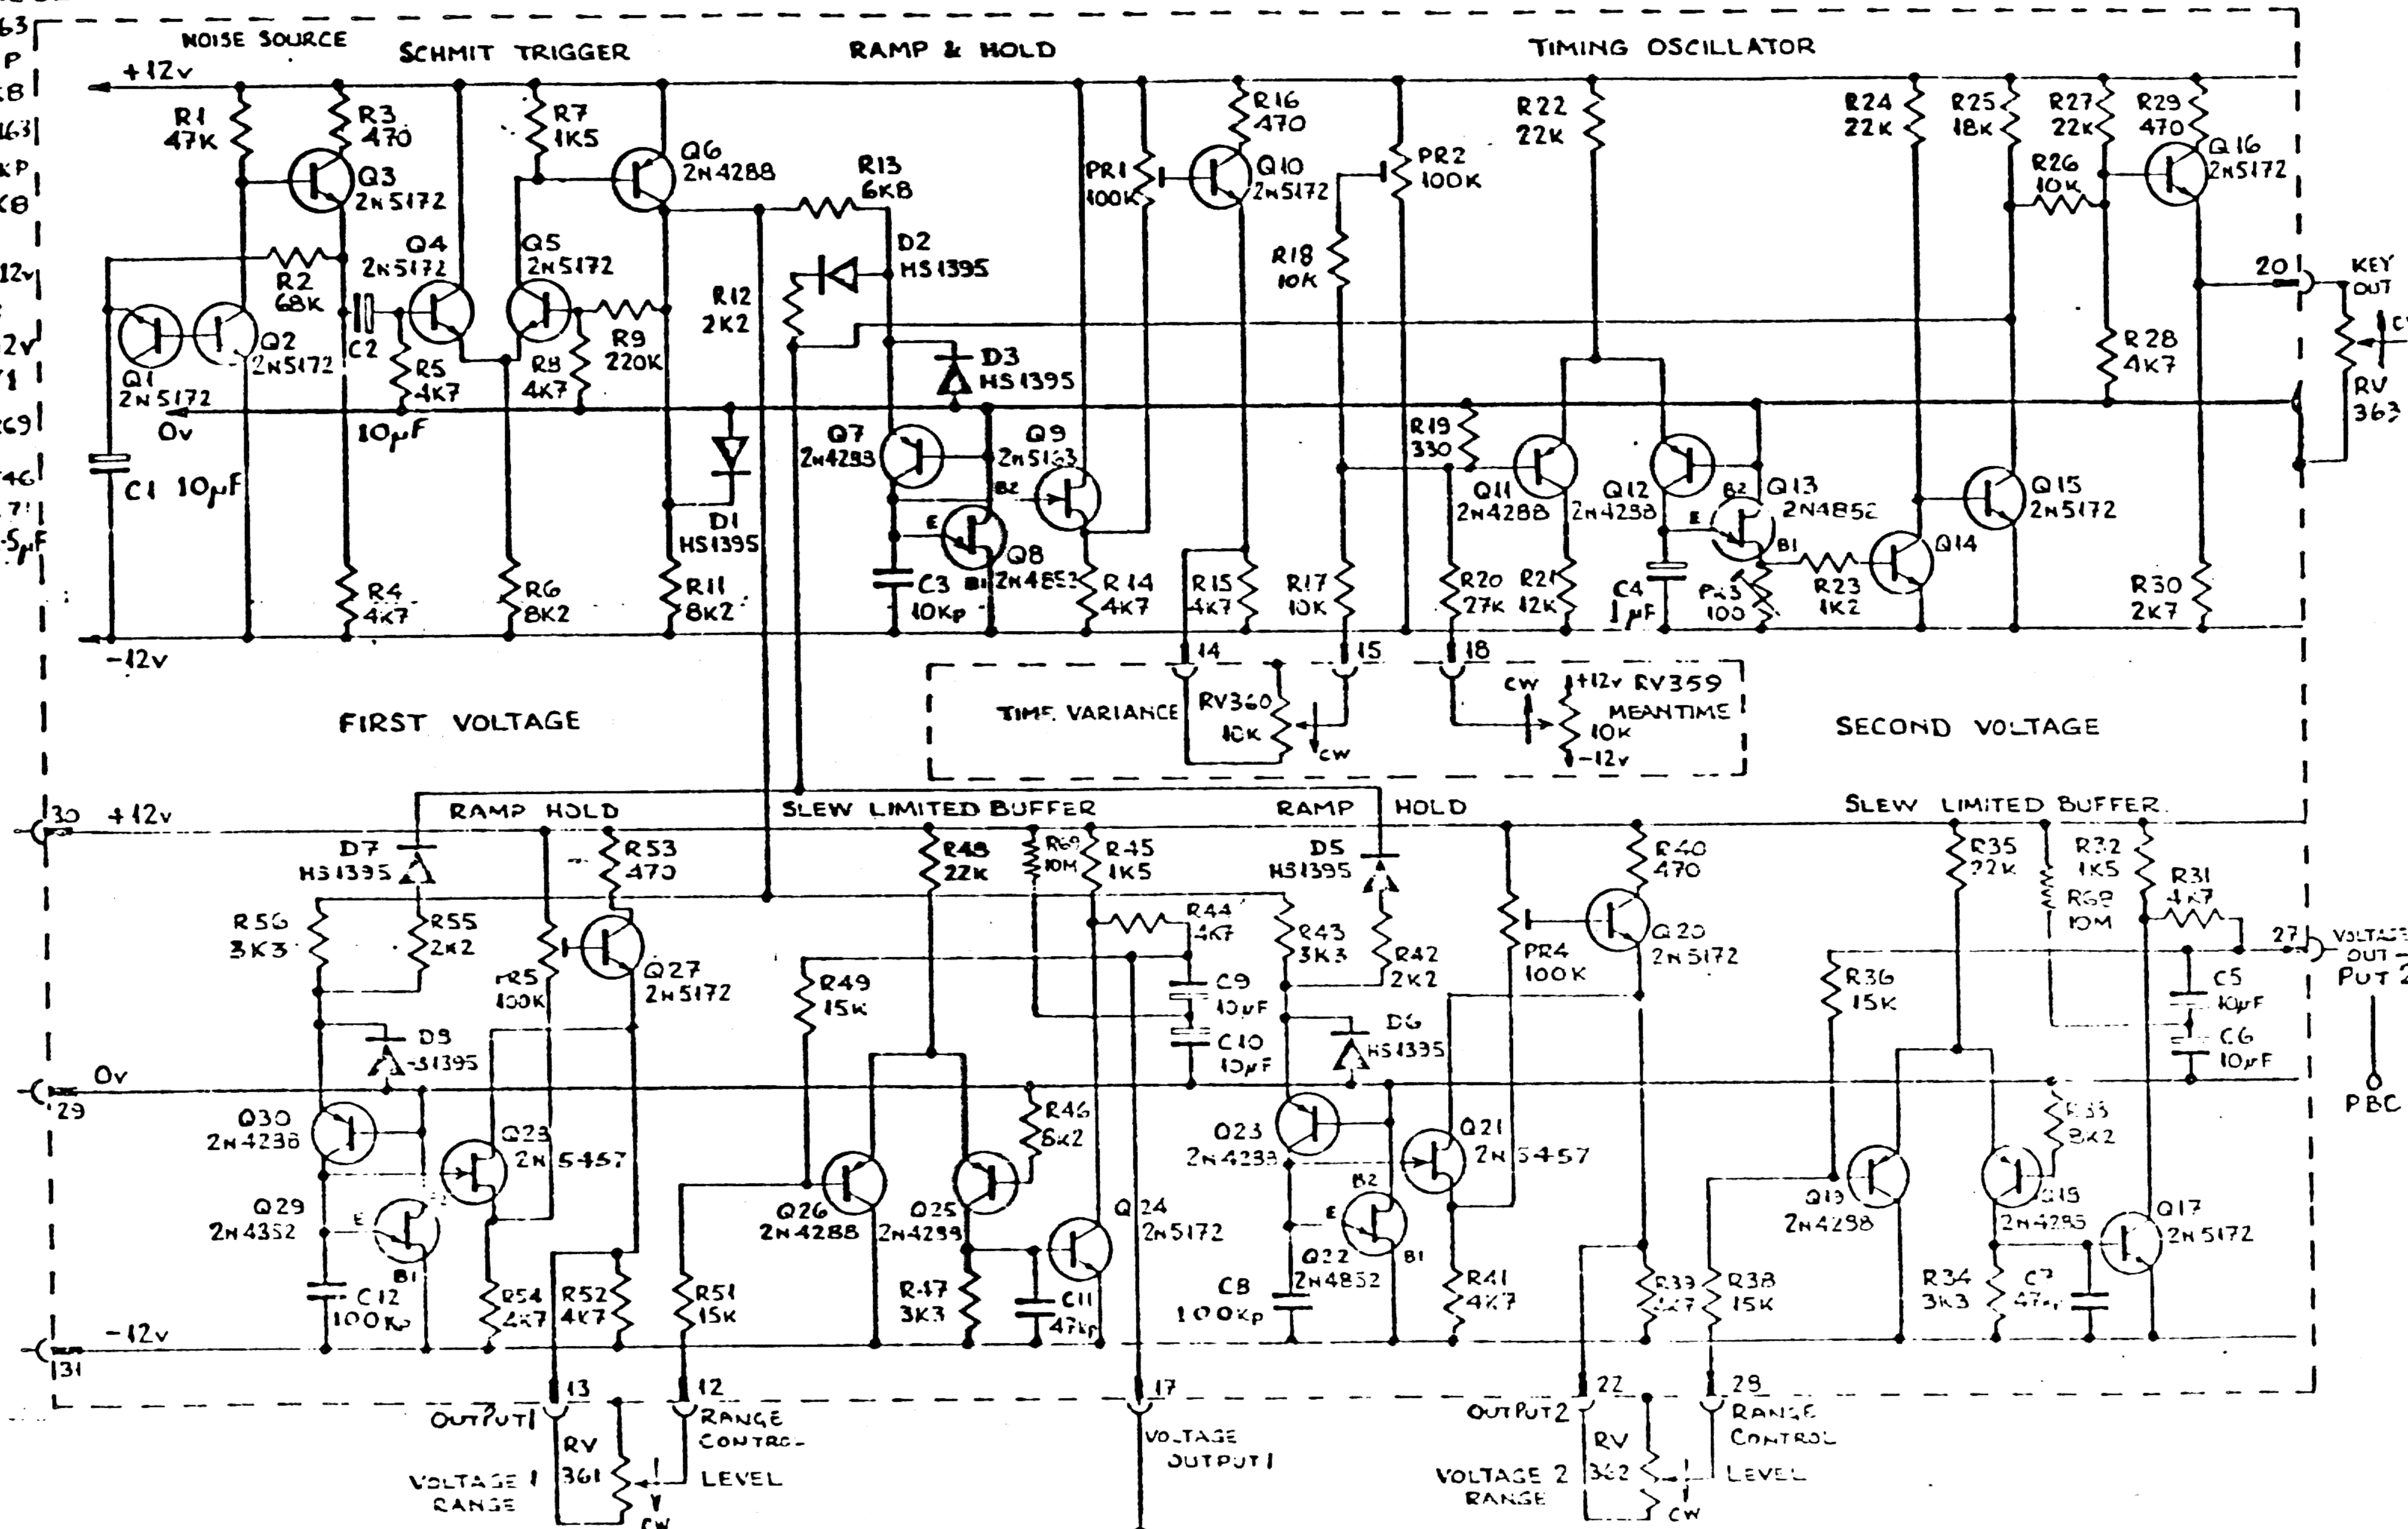

NOTE.
 POSITION 2P ON SYNTHI 100
 2 MODULE WIRING, SEE DRG E.M.S. 31/20

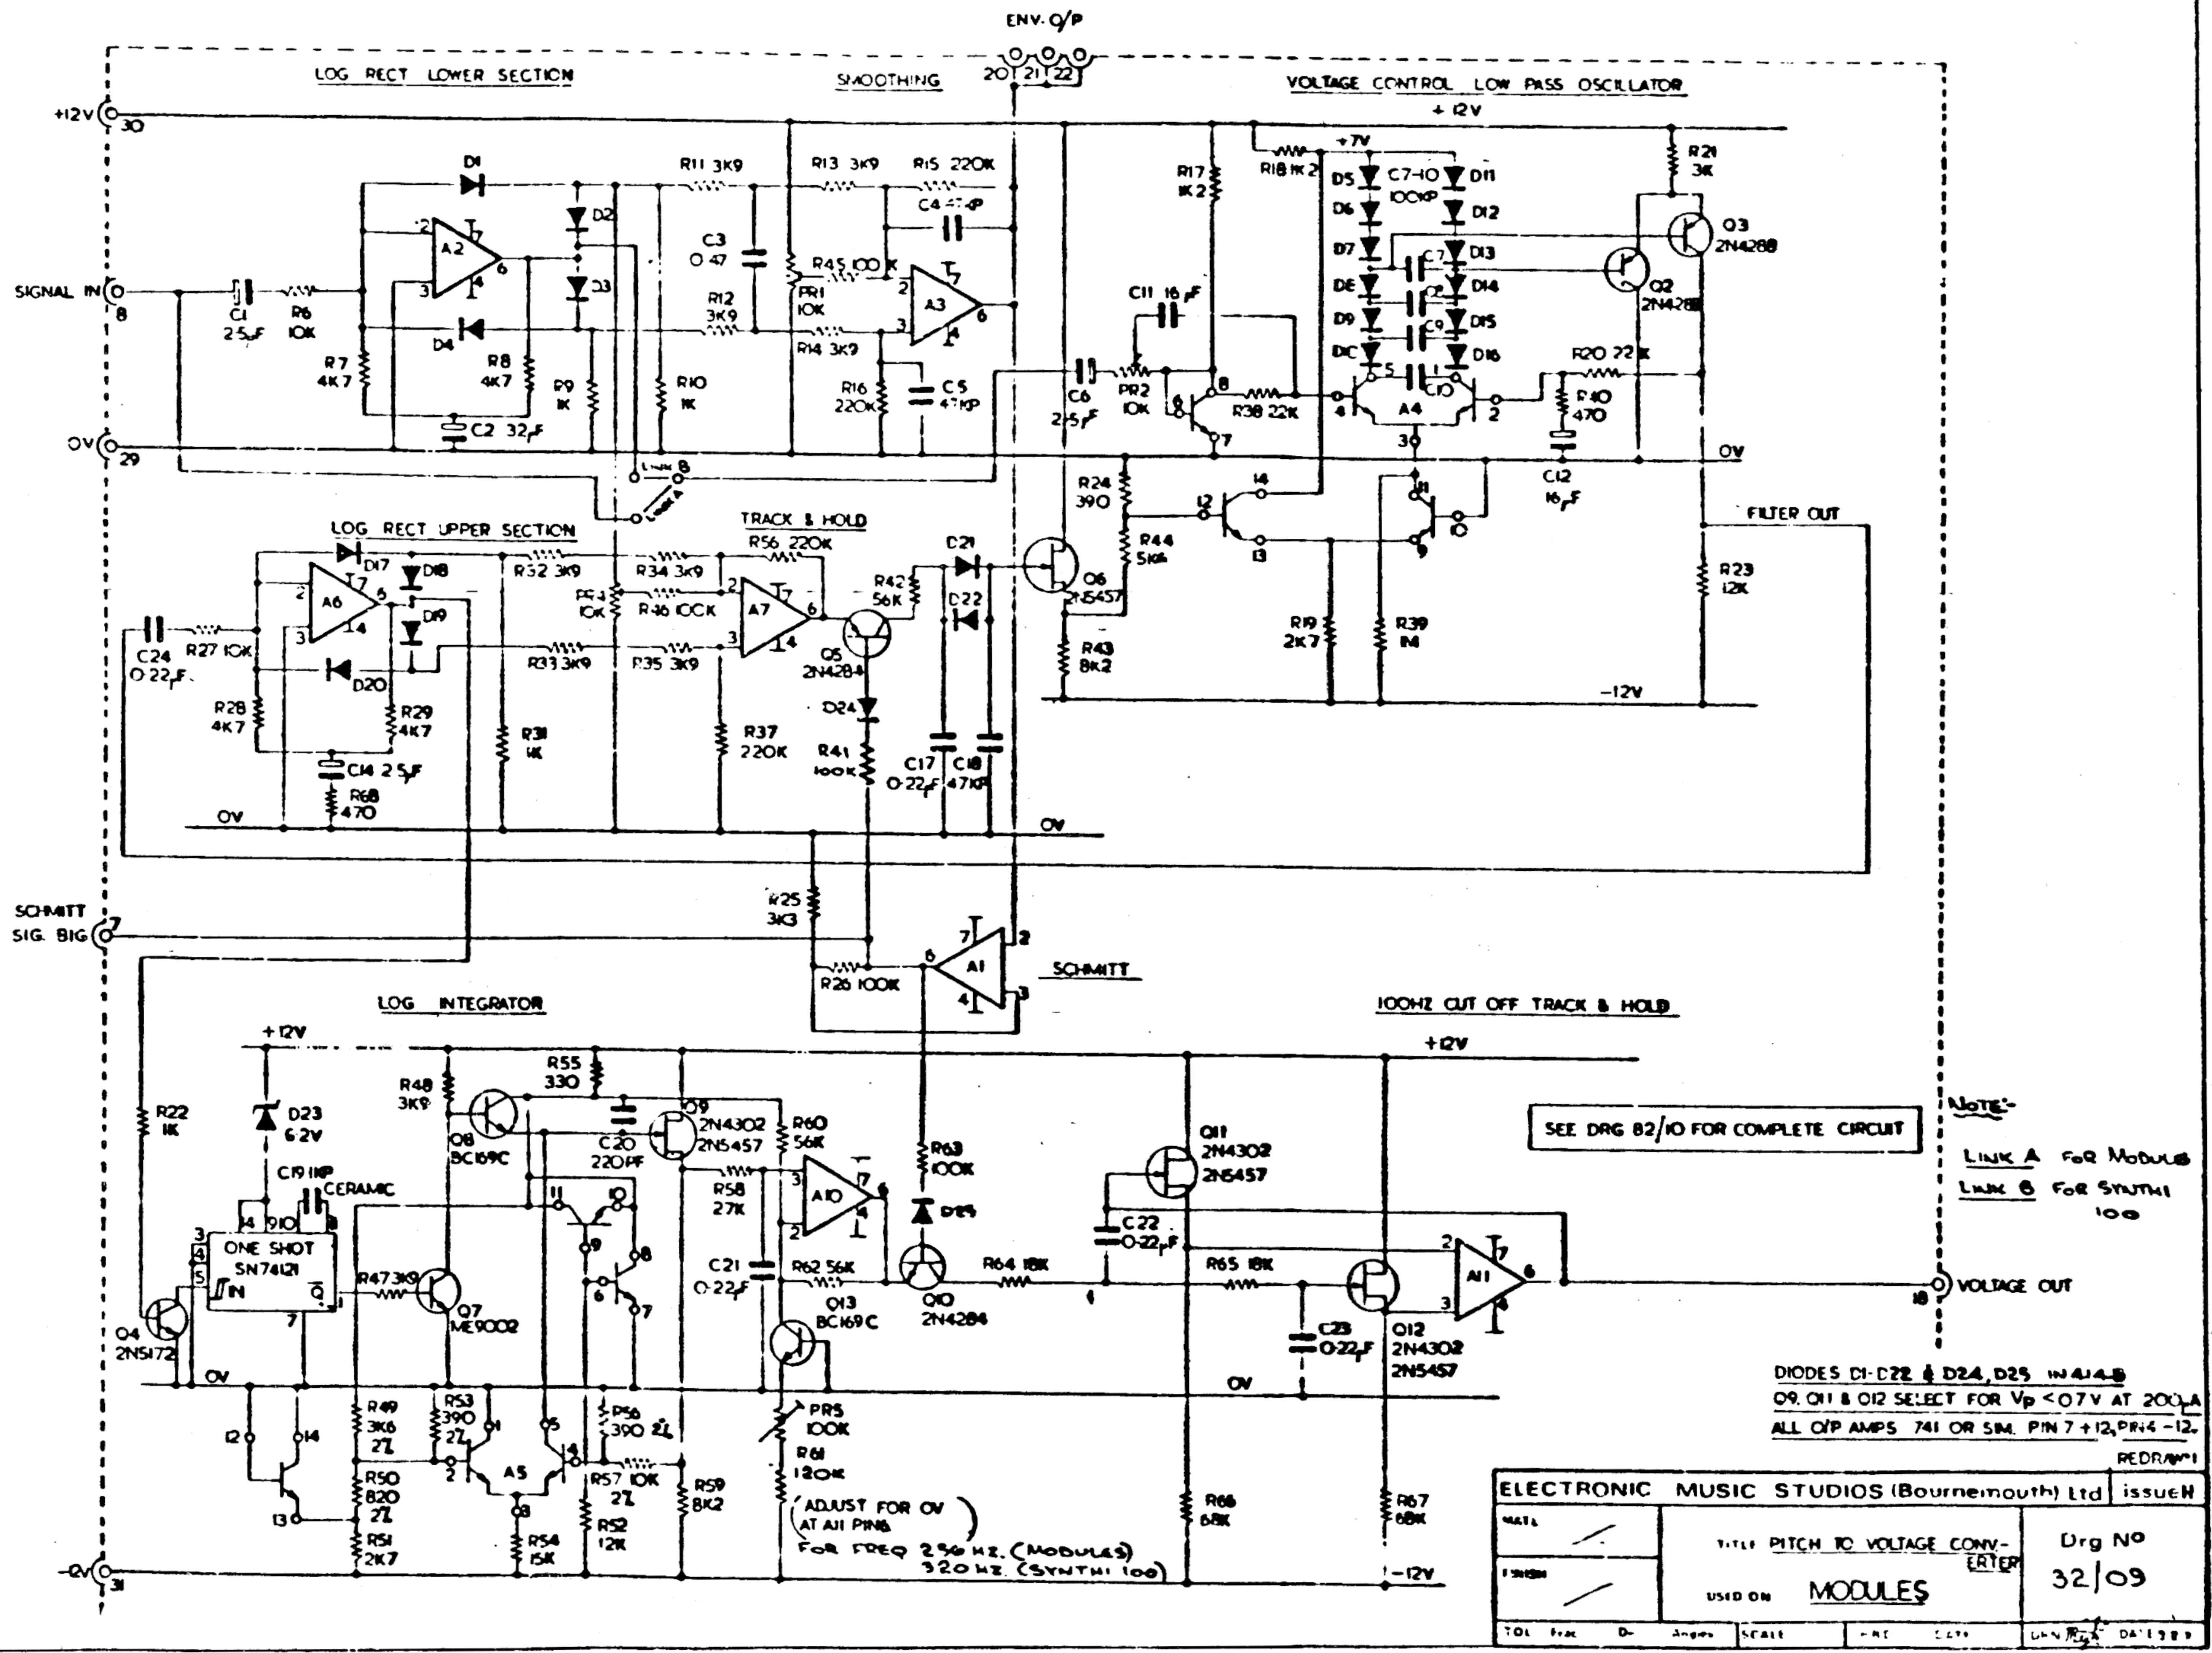


NOTE:-
 LINK A For Modules
 LINK B For Synth 100

DIODES D1-D22 & D24, D25 1N4148
 Q9, Q11 & Q12 SELECT FOR $V_p < 0.7V$ AT 200uA
 ALL O/P AMPS 741 OR 584 PIN 7 +12, PIN 4 -12.

ELECTRONIC MUSIC STUDIOS (Bournemouth) Ltd		issue#
TITLE	PITCH TO VOLTAGE CONV- ERTER	Drg No
USED ON	MODULES	32/09
TOL	SCALE	DATE

A1-A2 WERE 72741P.
B OV DID READ PIN 5


#/f 22.4.71

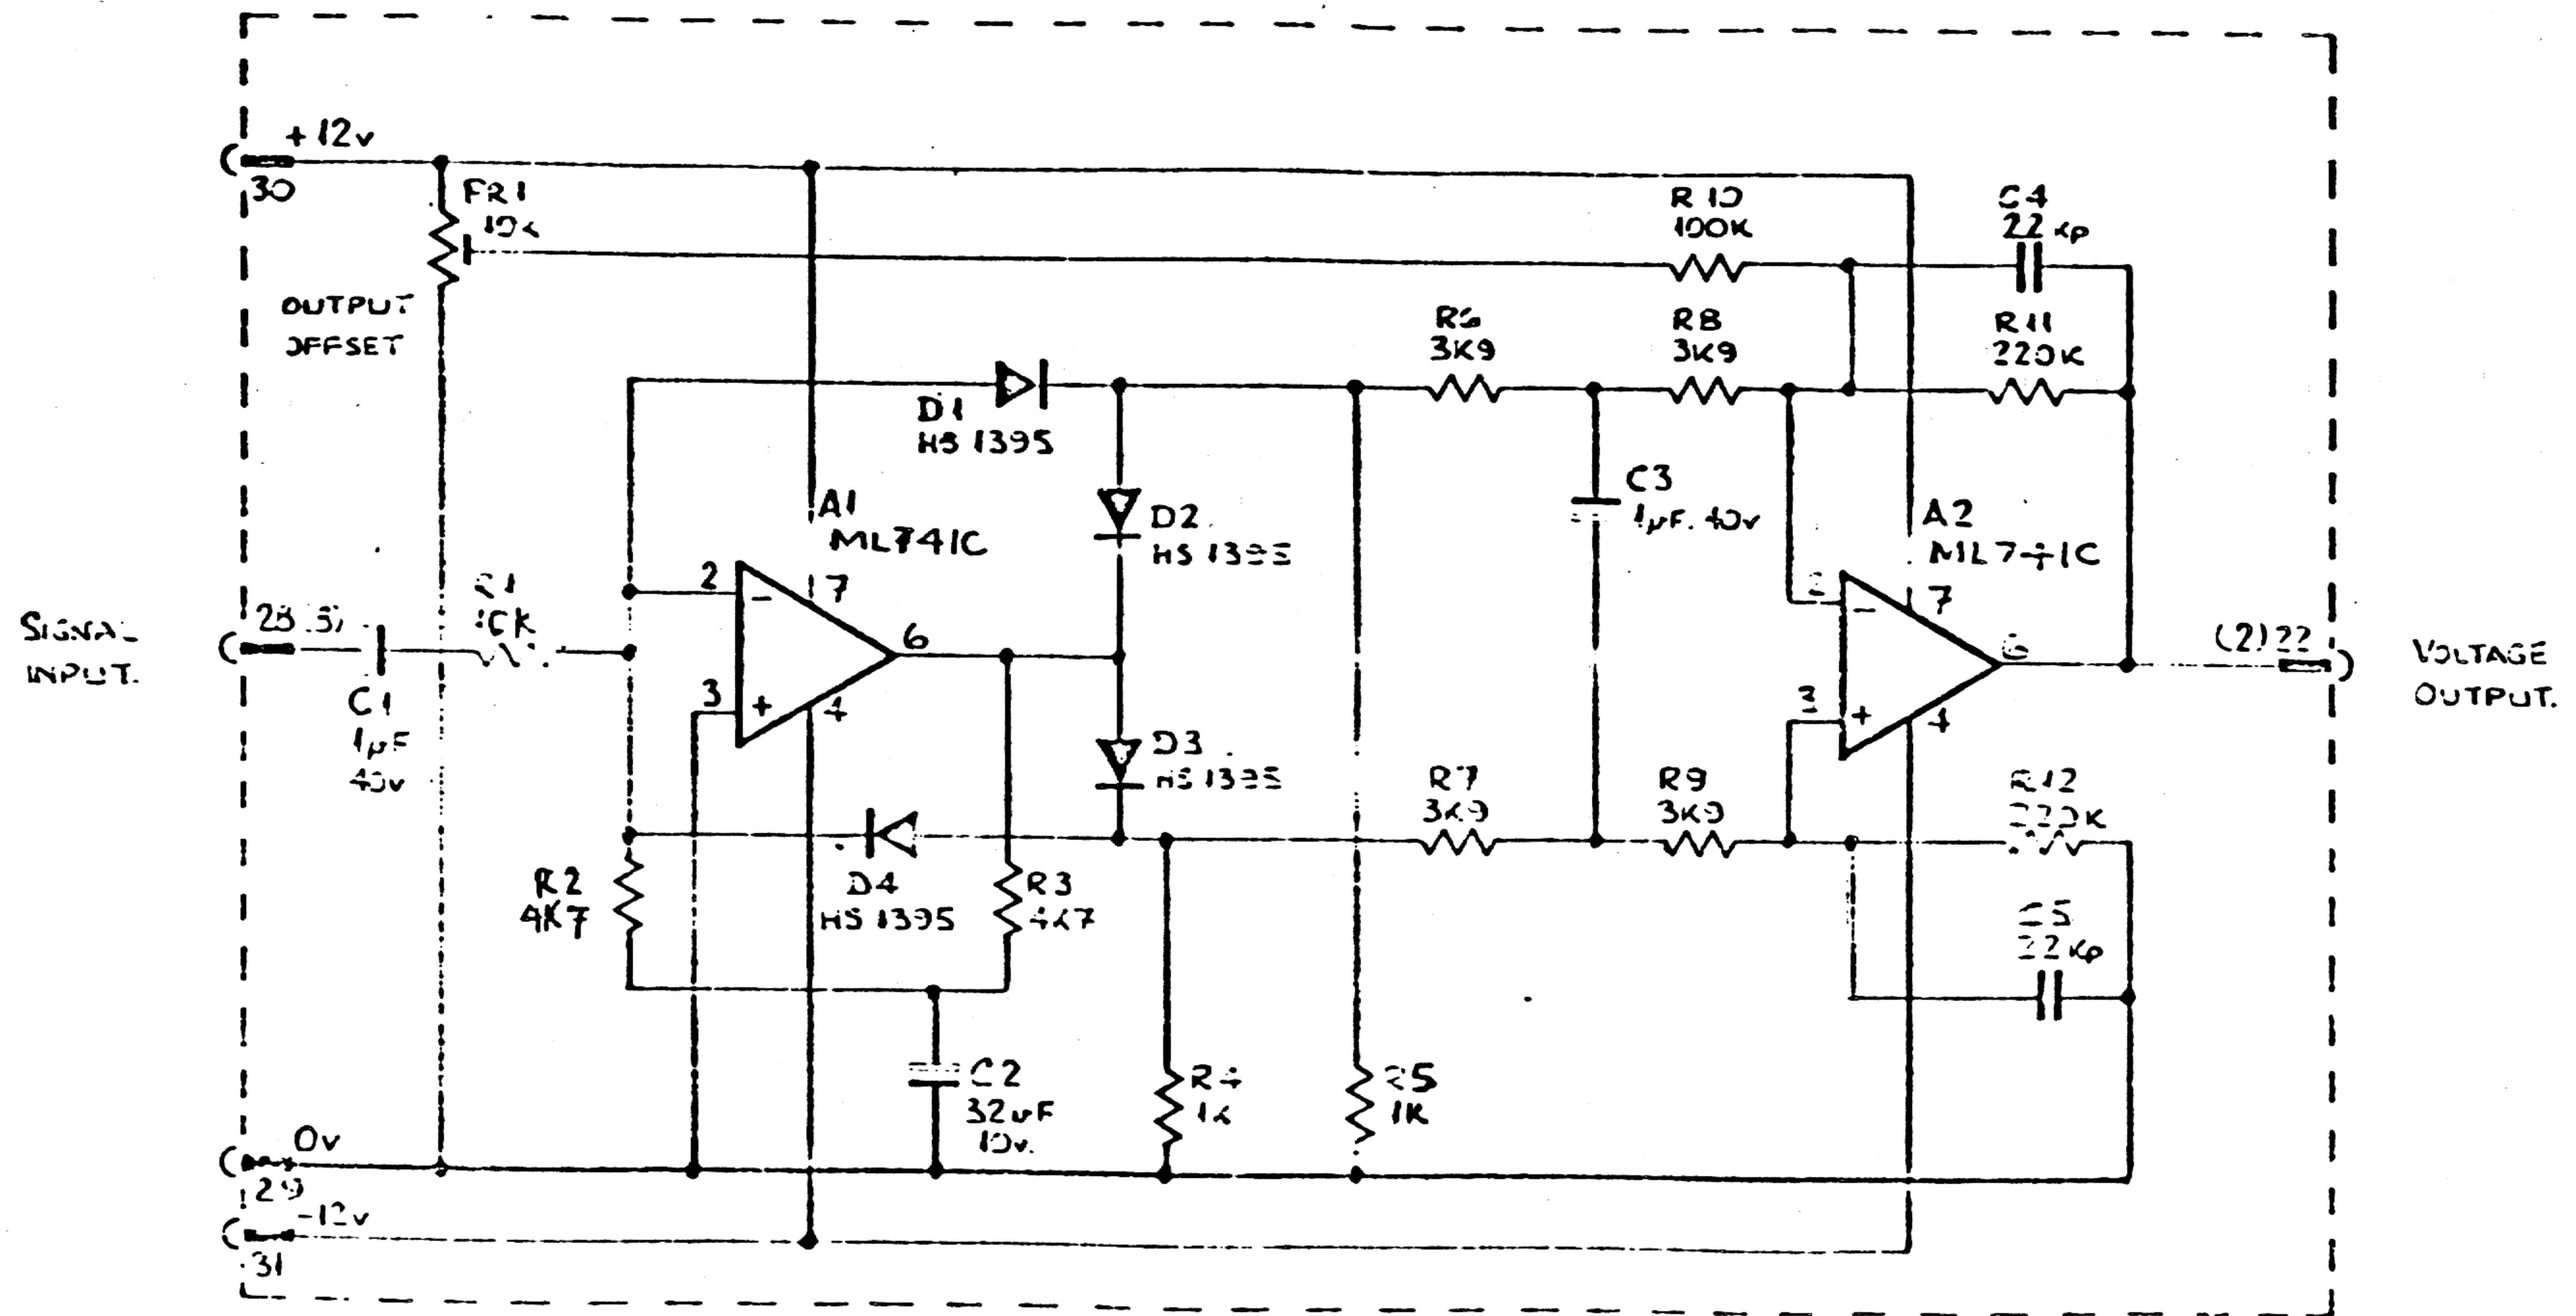

CIRCUIT DIAGRAM DUAL ENVELOPE FOLLOWER FROM EMS 32/10
ISSUE 2

E R37 & R17 ADDED C C7 & C8 added D CN 50
 R11 & R12 WERE 560 11.8.71 D 11.8.71
 C5 & C6 ADDED
 FURTHER EDGE CONN. 25/1/73.
 INFM. ADDED

No 16.4.71.

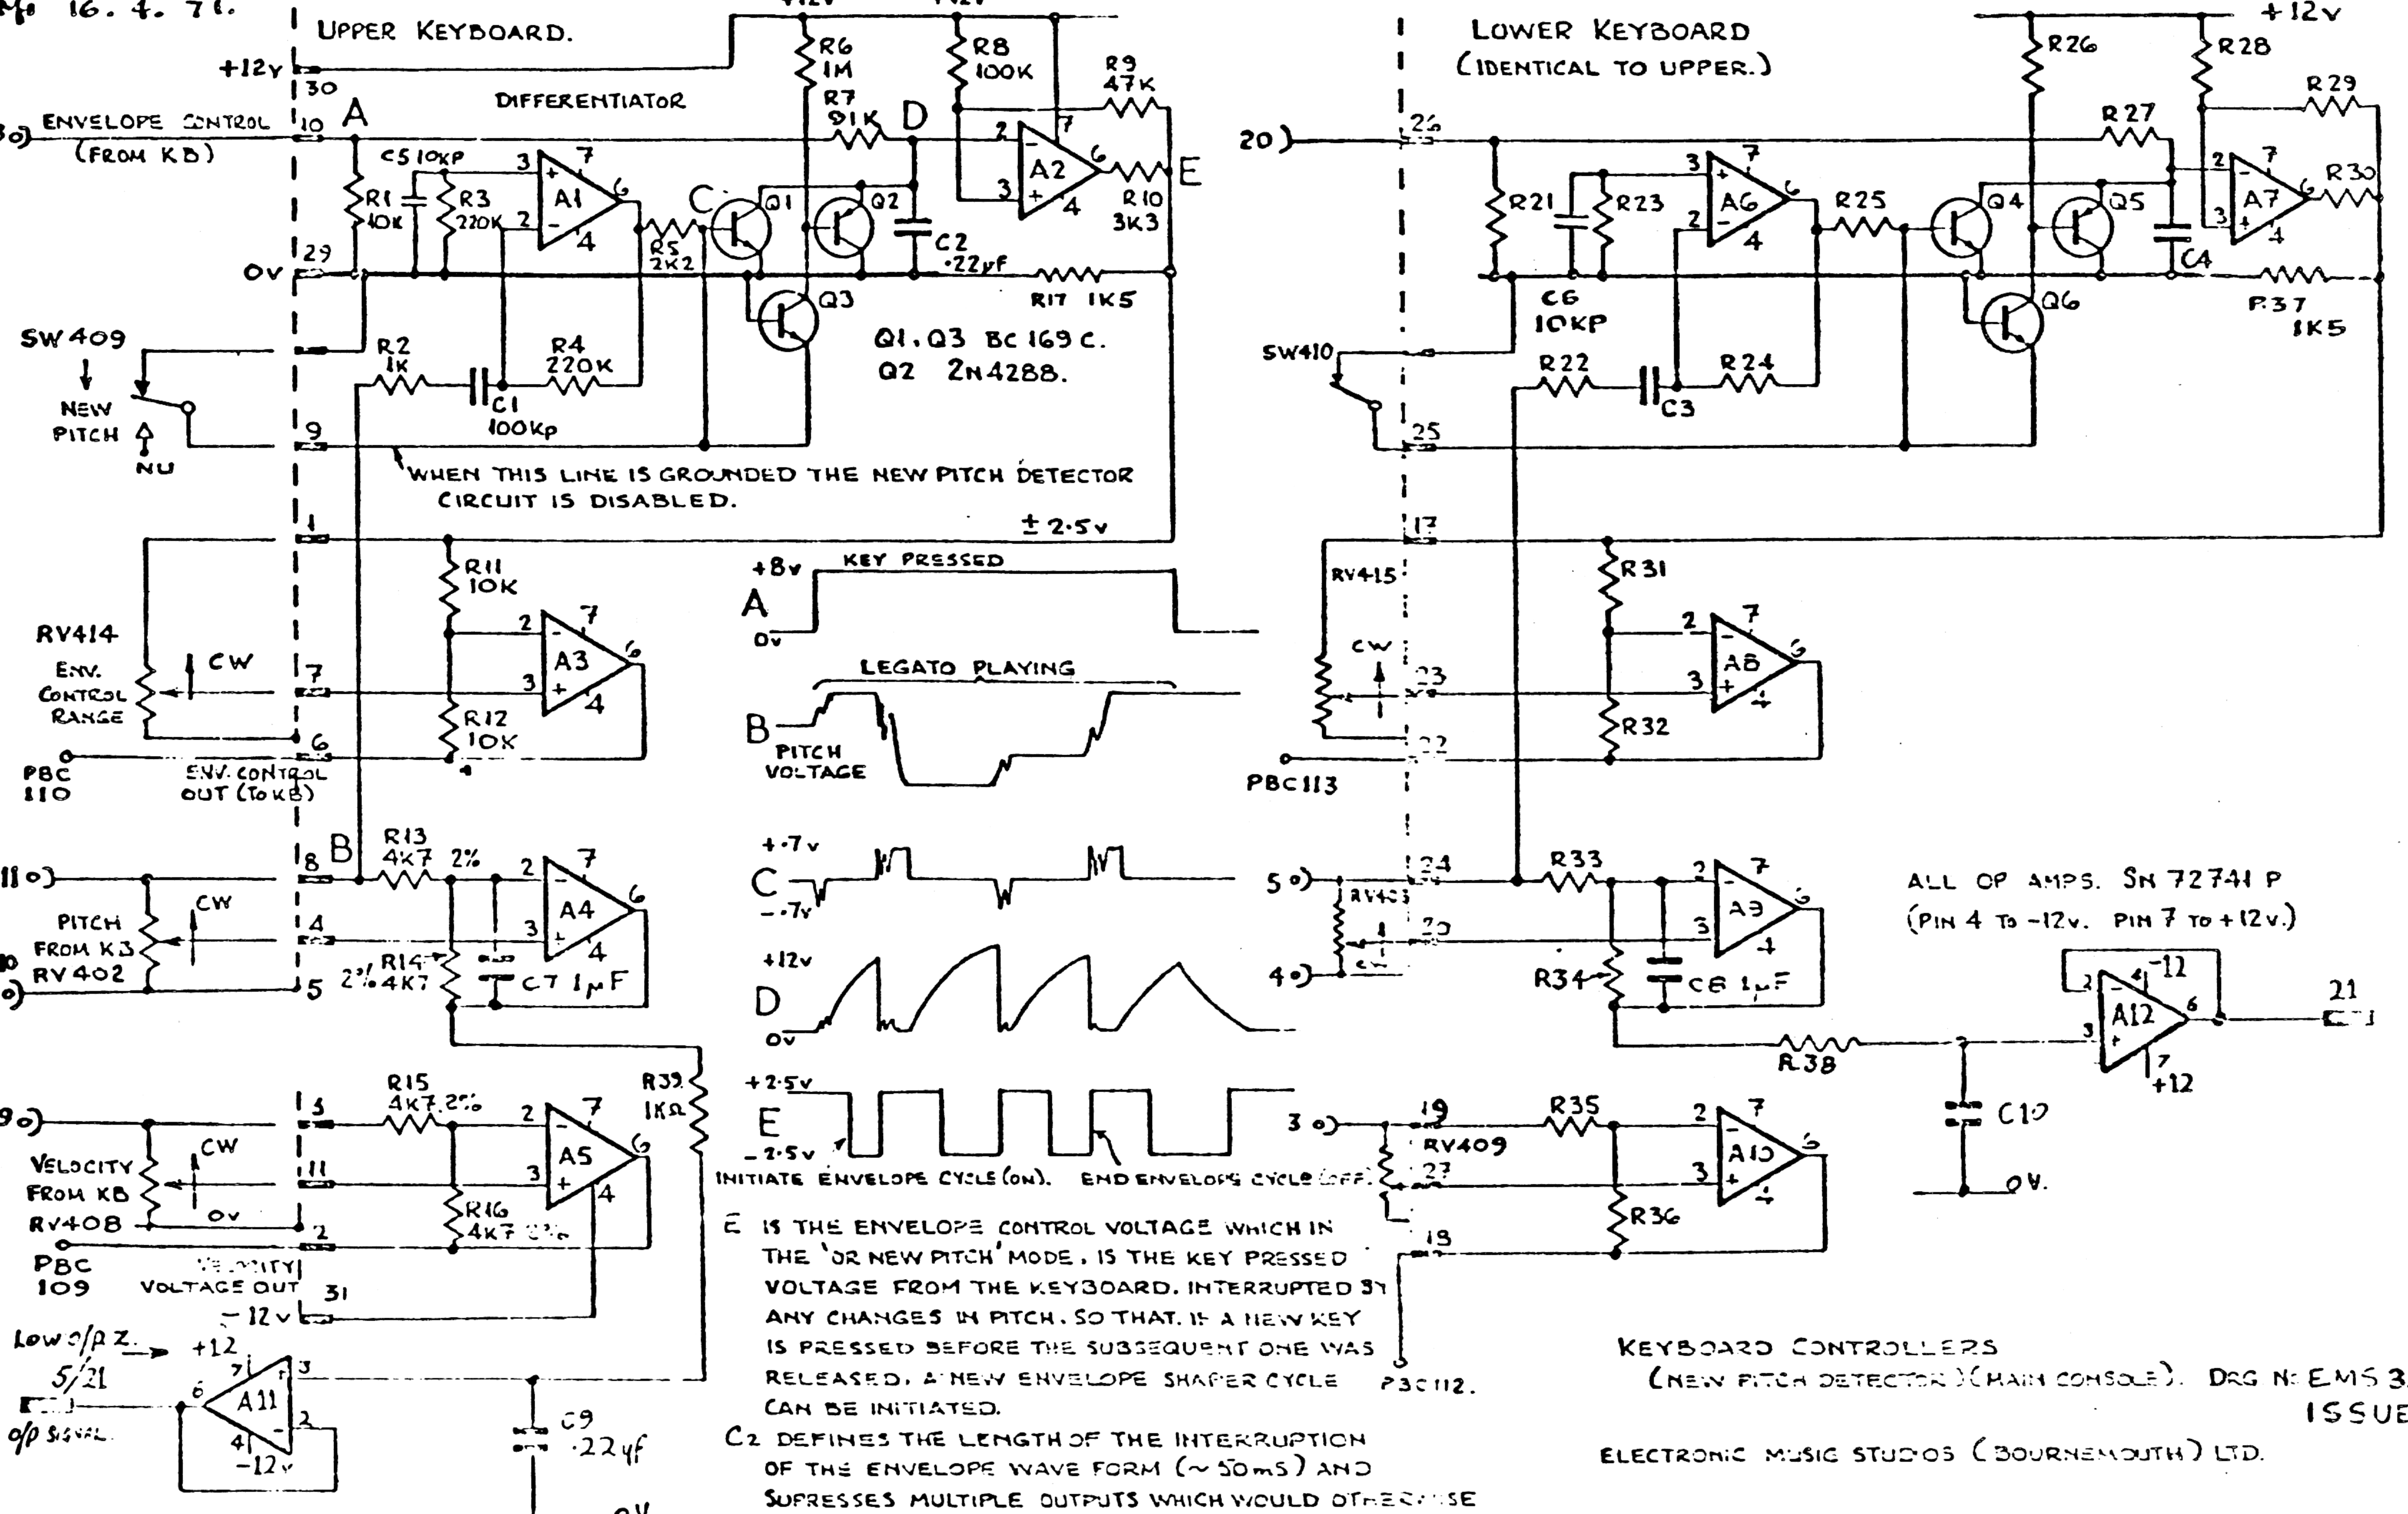

E IS THE ENVELOPE CONTROL VOLTAGE WHICH IN THE 'OR NEW PITCH' MODE, IS THE KEY PRESSED VOLTAGE FROM THE KEYBOARD. INTERRUPTED BY ANY CHANGES IN PITCH. SO THAT, IF A NEW KEY IS PRESSED BEFORE THE SUBSEQUENT ONE WAS RELEASED, A NEW ENVELOPE SHAPER CYCLE CAN BE INITIATED.
 C2 DEFINES THE LENGTH OF THE INTERRUPTION OF THE ENVELOPE WAVE FORM (~50ms) AND SUPPRESSES MULTIPLE OUTPUTS WHICH WOULD OTHERWISE RESULT FROM CONTACT SCRATCH.

KEYBOARD CONTROLLERS
 (NEW PITCH DETECTOR) (MAIN CONSOLE). DRG NO EMS 32/11
 ISSUE 1
 ELECTRONIC MUSIC STUDIOS (BOURNEMOUTH) LTD.


ALL OP AMPS. SN 72741 P
 (PIN 4 TO -12V. PIN 7 TO +12V.)

B. EXTERNAL NOTES ADDED.

9/8. 23.4.71.

C R2 WAS 39K.

7/8. 7.8.71.

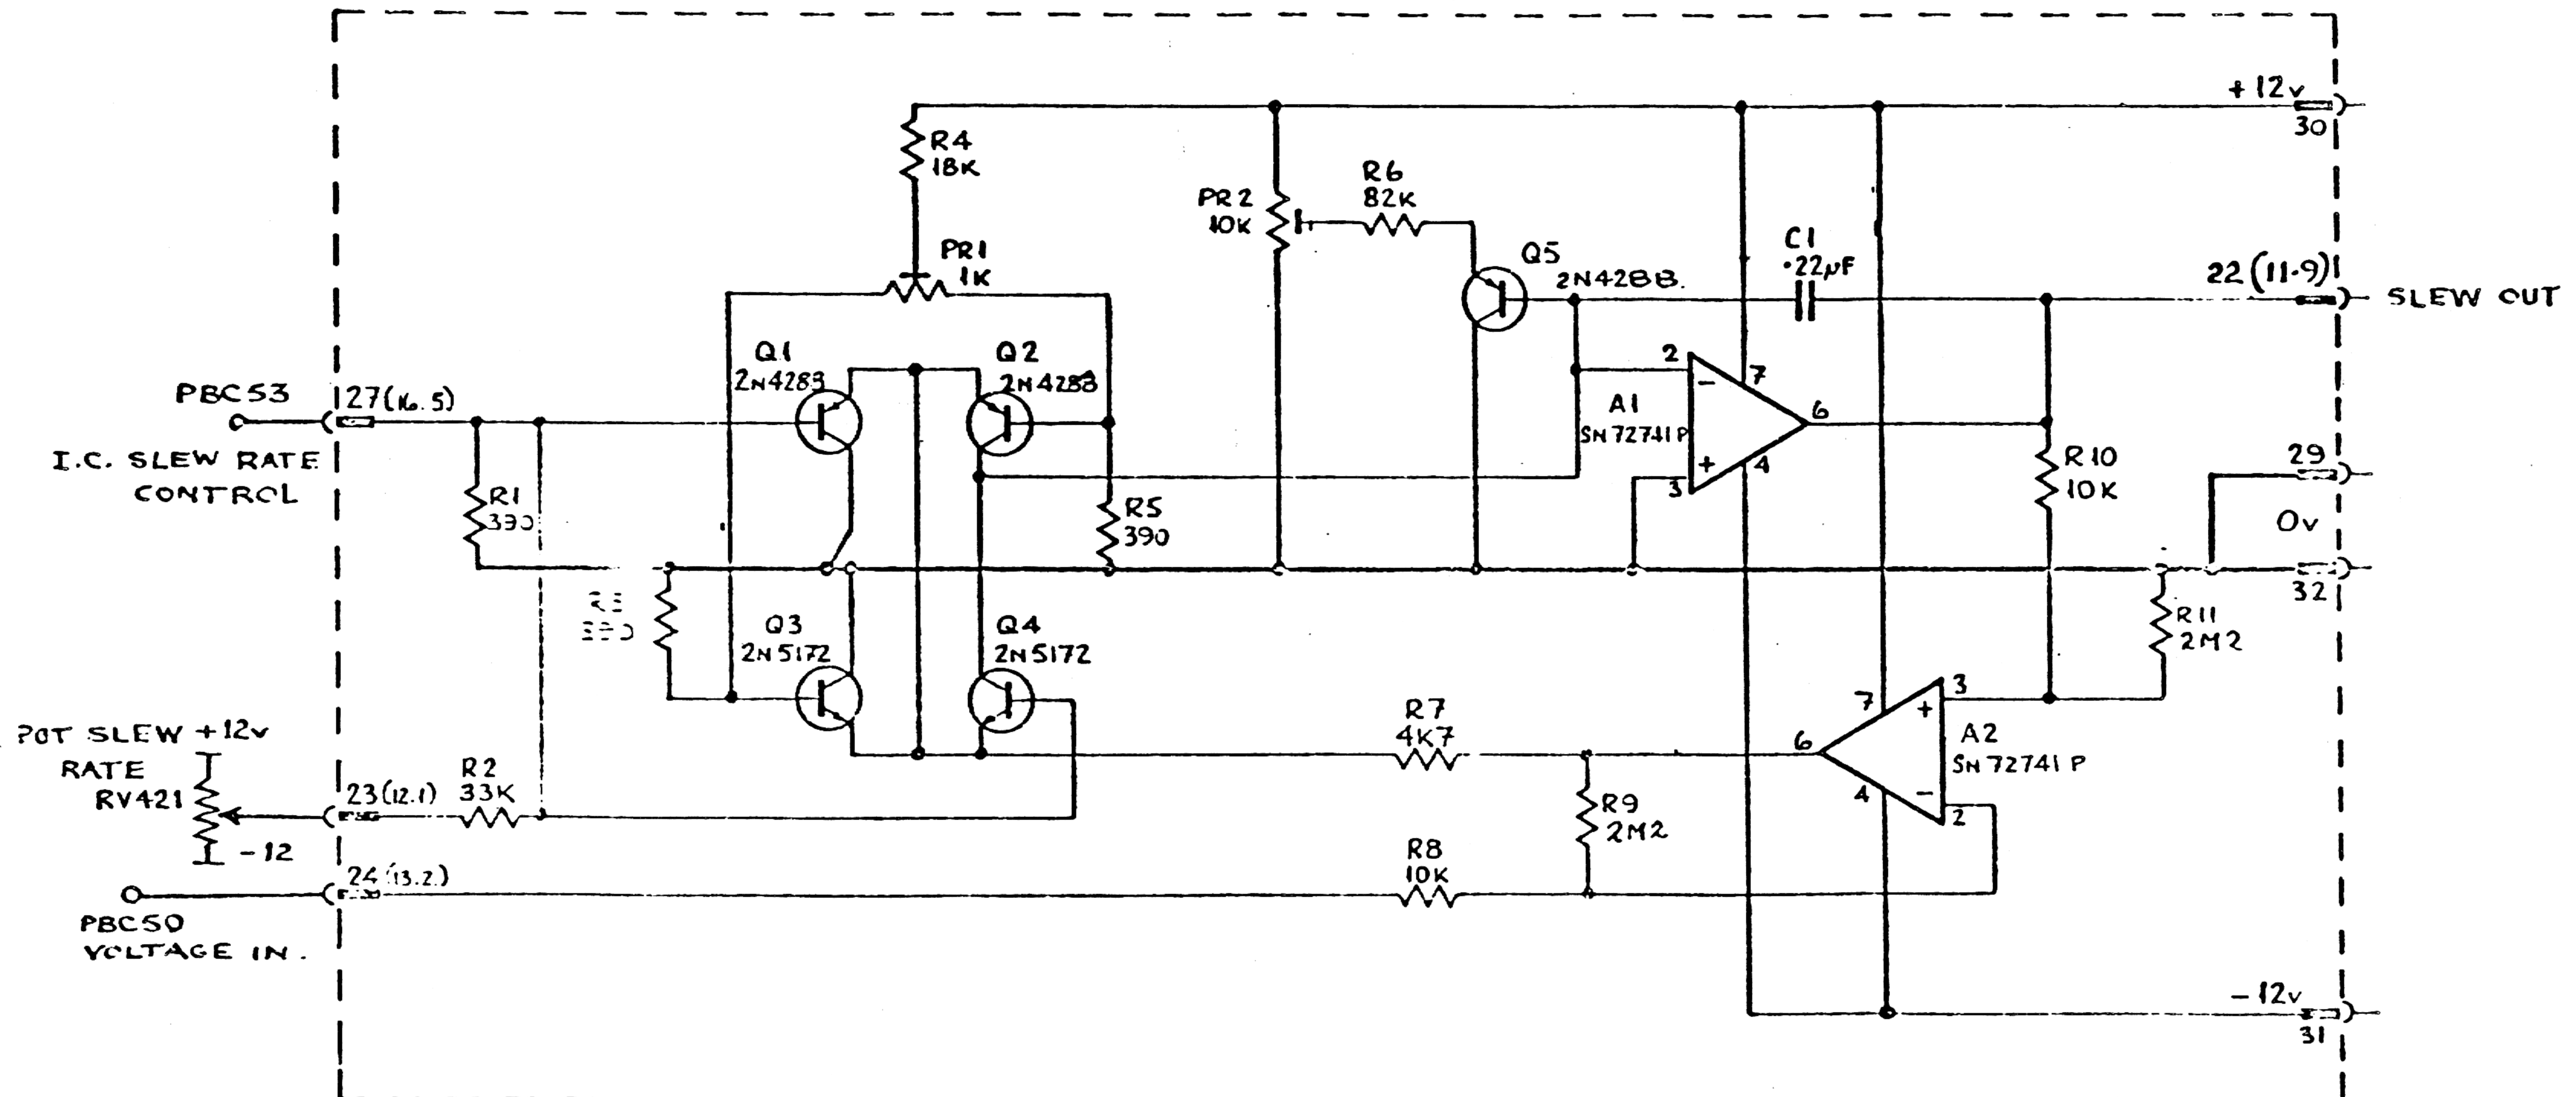


CIRCUIT DIAGRAM TRIPLE SLEW LIMITER. DRG. NO. EMS 32/12
ISSUE C

ELECTRONIC MUSIC STUDIOS (BOURNEMOUTH) LTD.

B R13 - R16 ADDED.
 FROM PIN2 TO 0V
 R17 - R20 ADDED
 M 16.4.71

C R21 TO R24 added
 & C9 TO C12 added
 3.12.71.

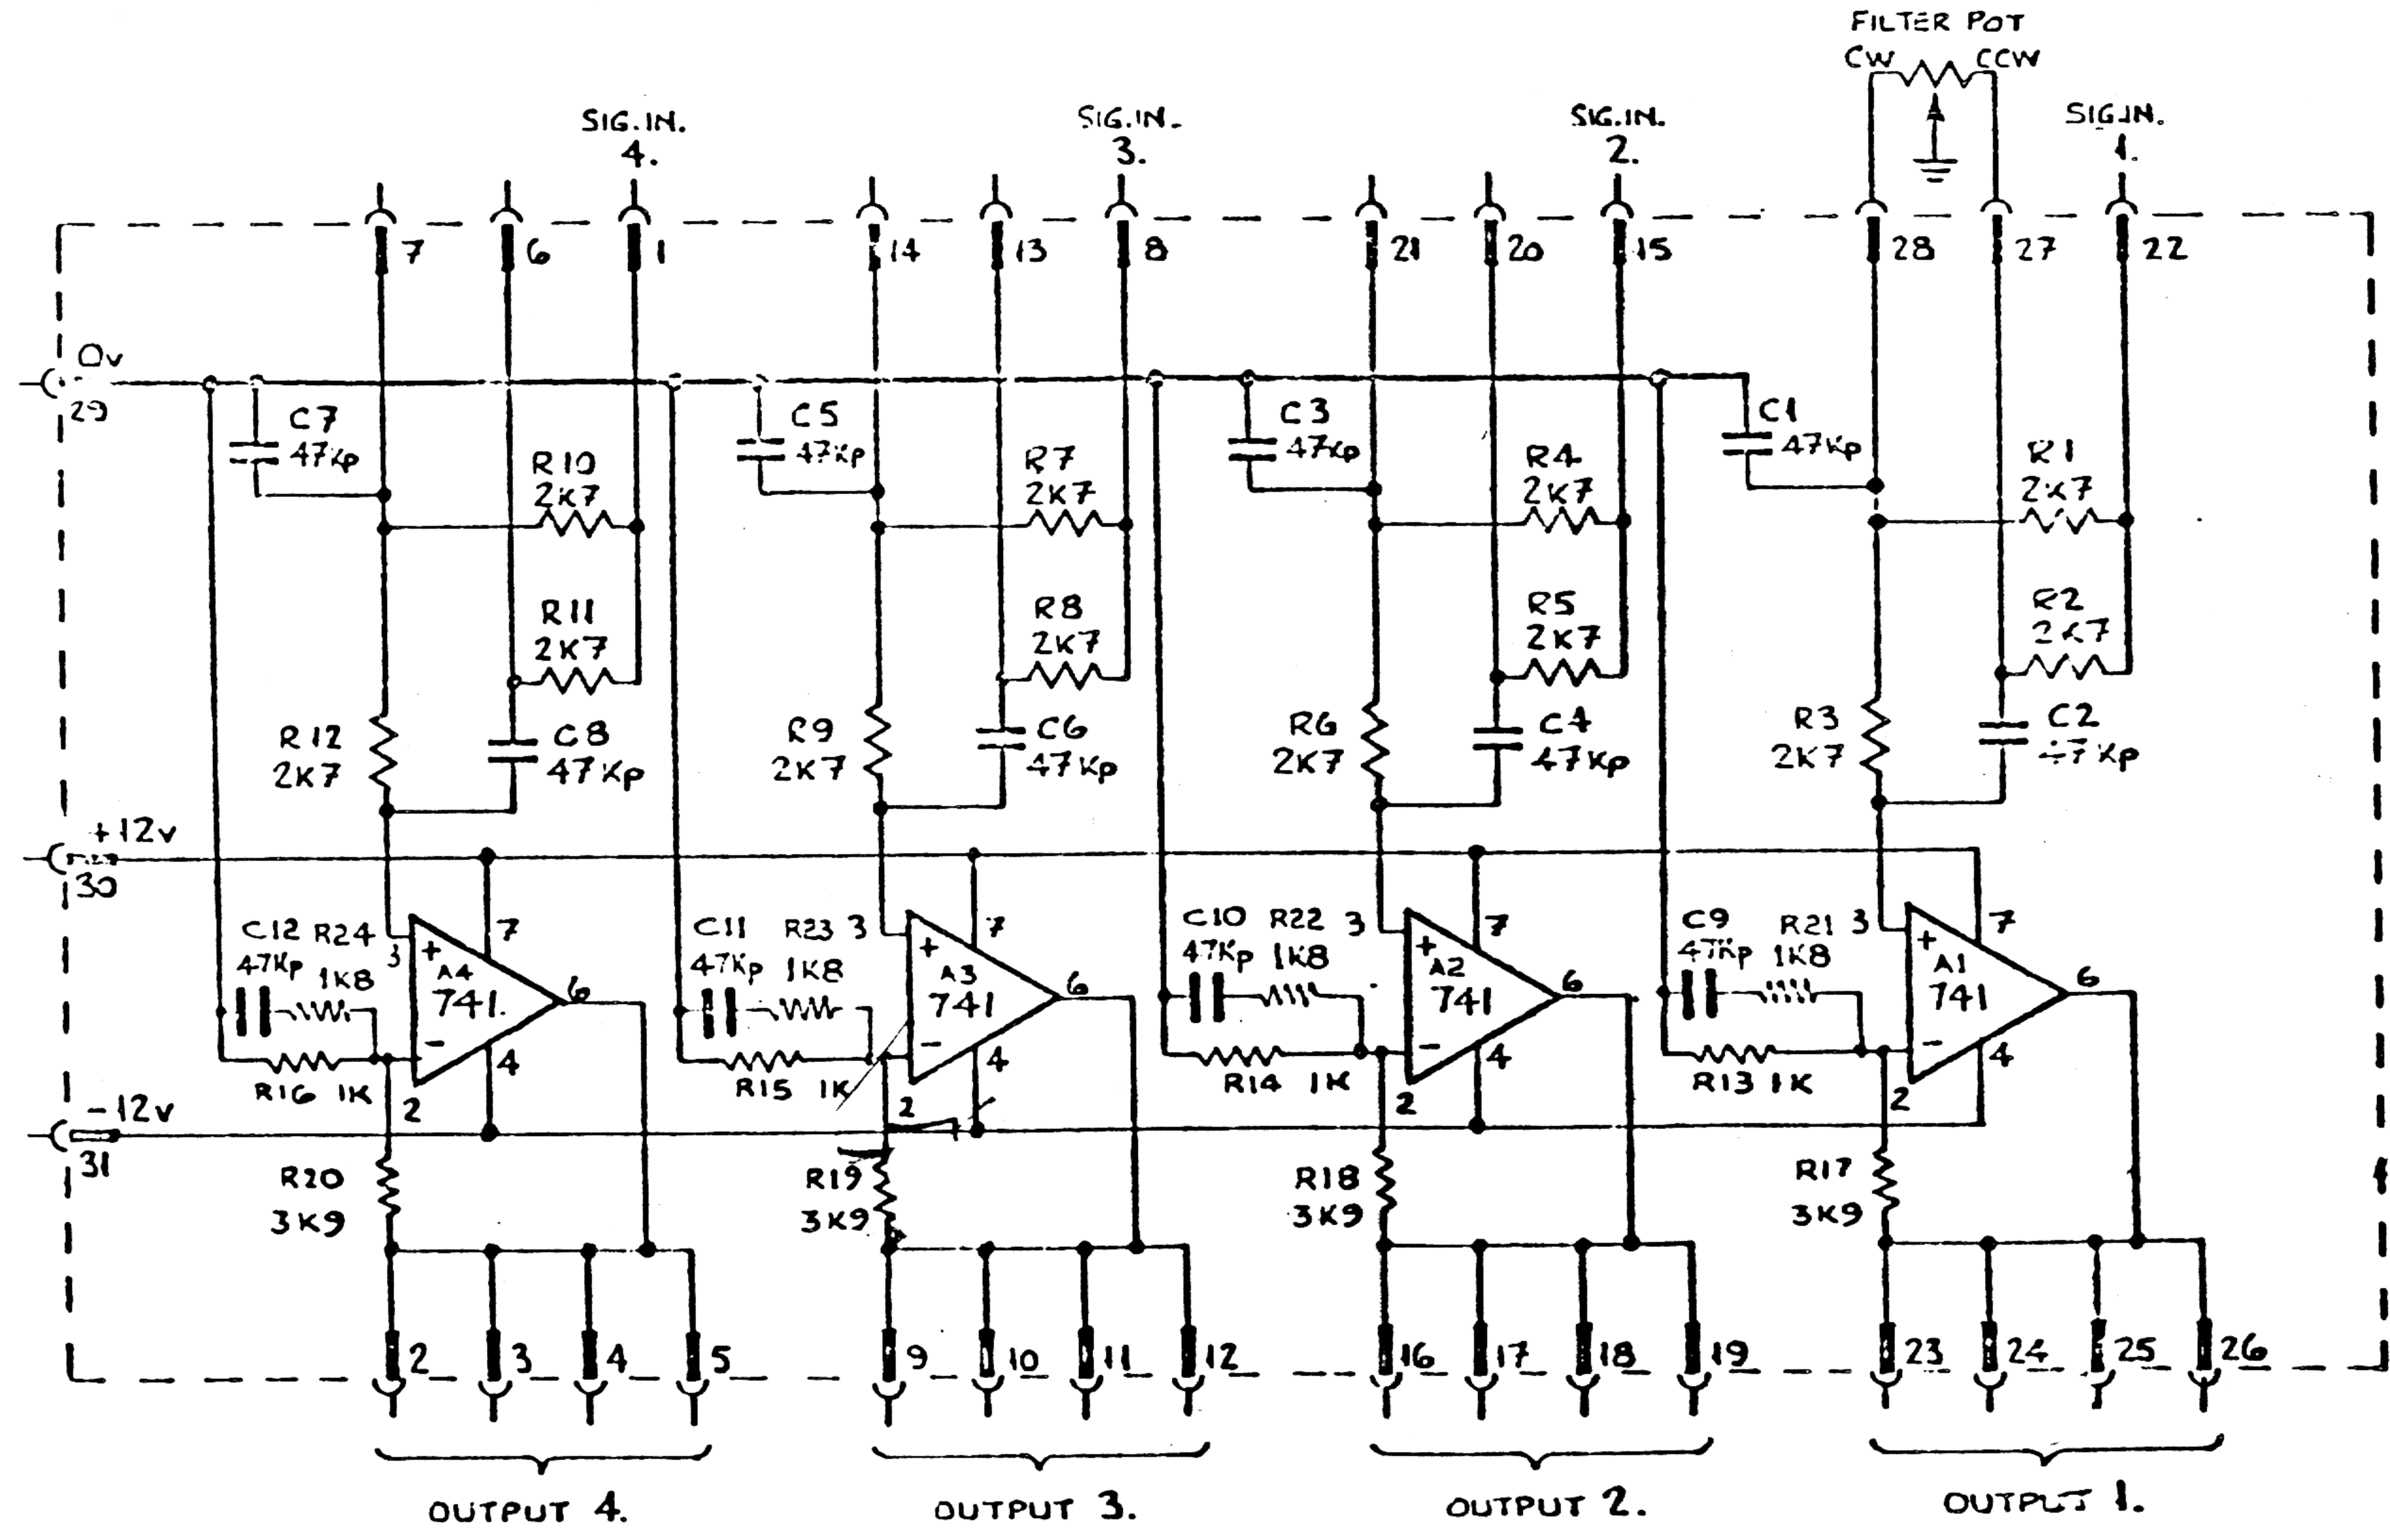


CIRCUIT DIAGRAM QUAD OUTPUT CHANNEL FILTERS. DRC. N° E.M.S 32/13
 ISSUE C
 ELECTRONIC MUSIC STUDIOS (BOURNEMOUTH) LTD.

B C1-C4 ADDED
 A3, C5, C6 R17, R18
 ADDED
 R17 & R18 DELETED
 FROM O/P OF PIN 2.
 M 16. 4. 71.

C R17 & R18 WAS 15K
 25. 6. 71.
 D R17 & R18 WAS 33K
 R19 & R20 ADDED.
 CIRC. CHANGE. REC.
 4. 8. 71.


E C.N. 20.
 5. 3. 73.

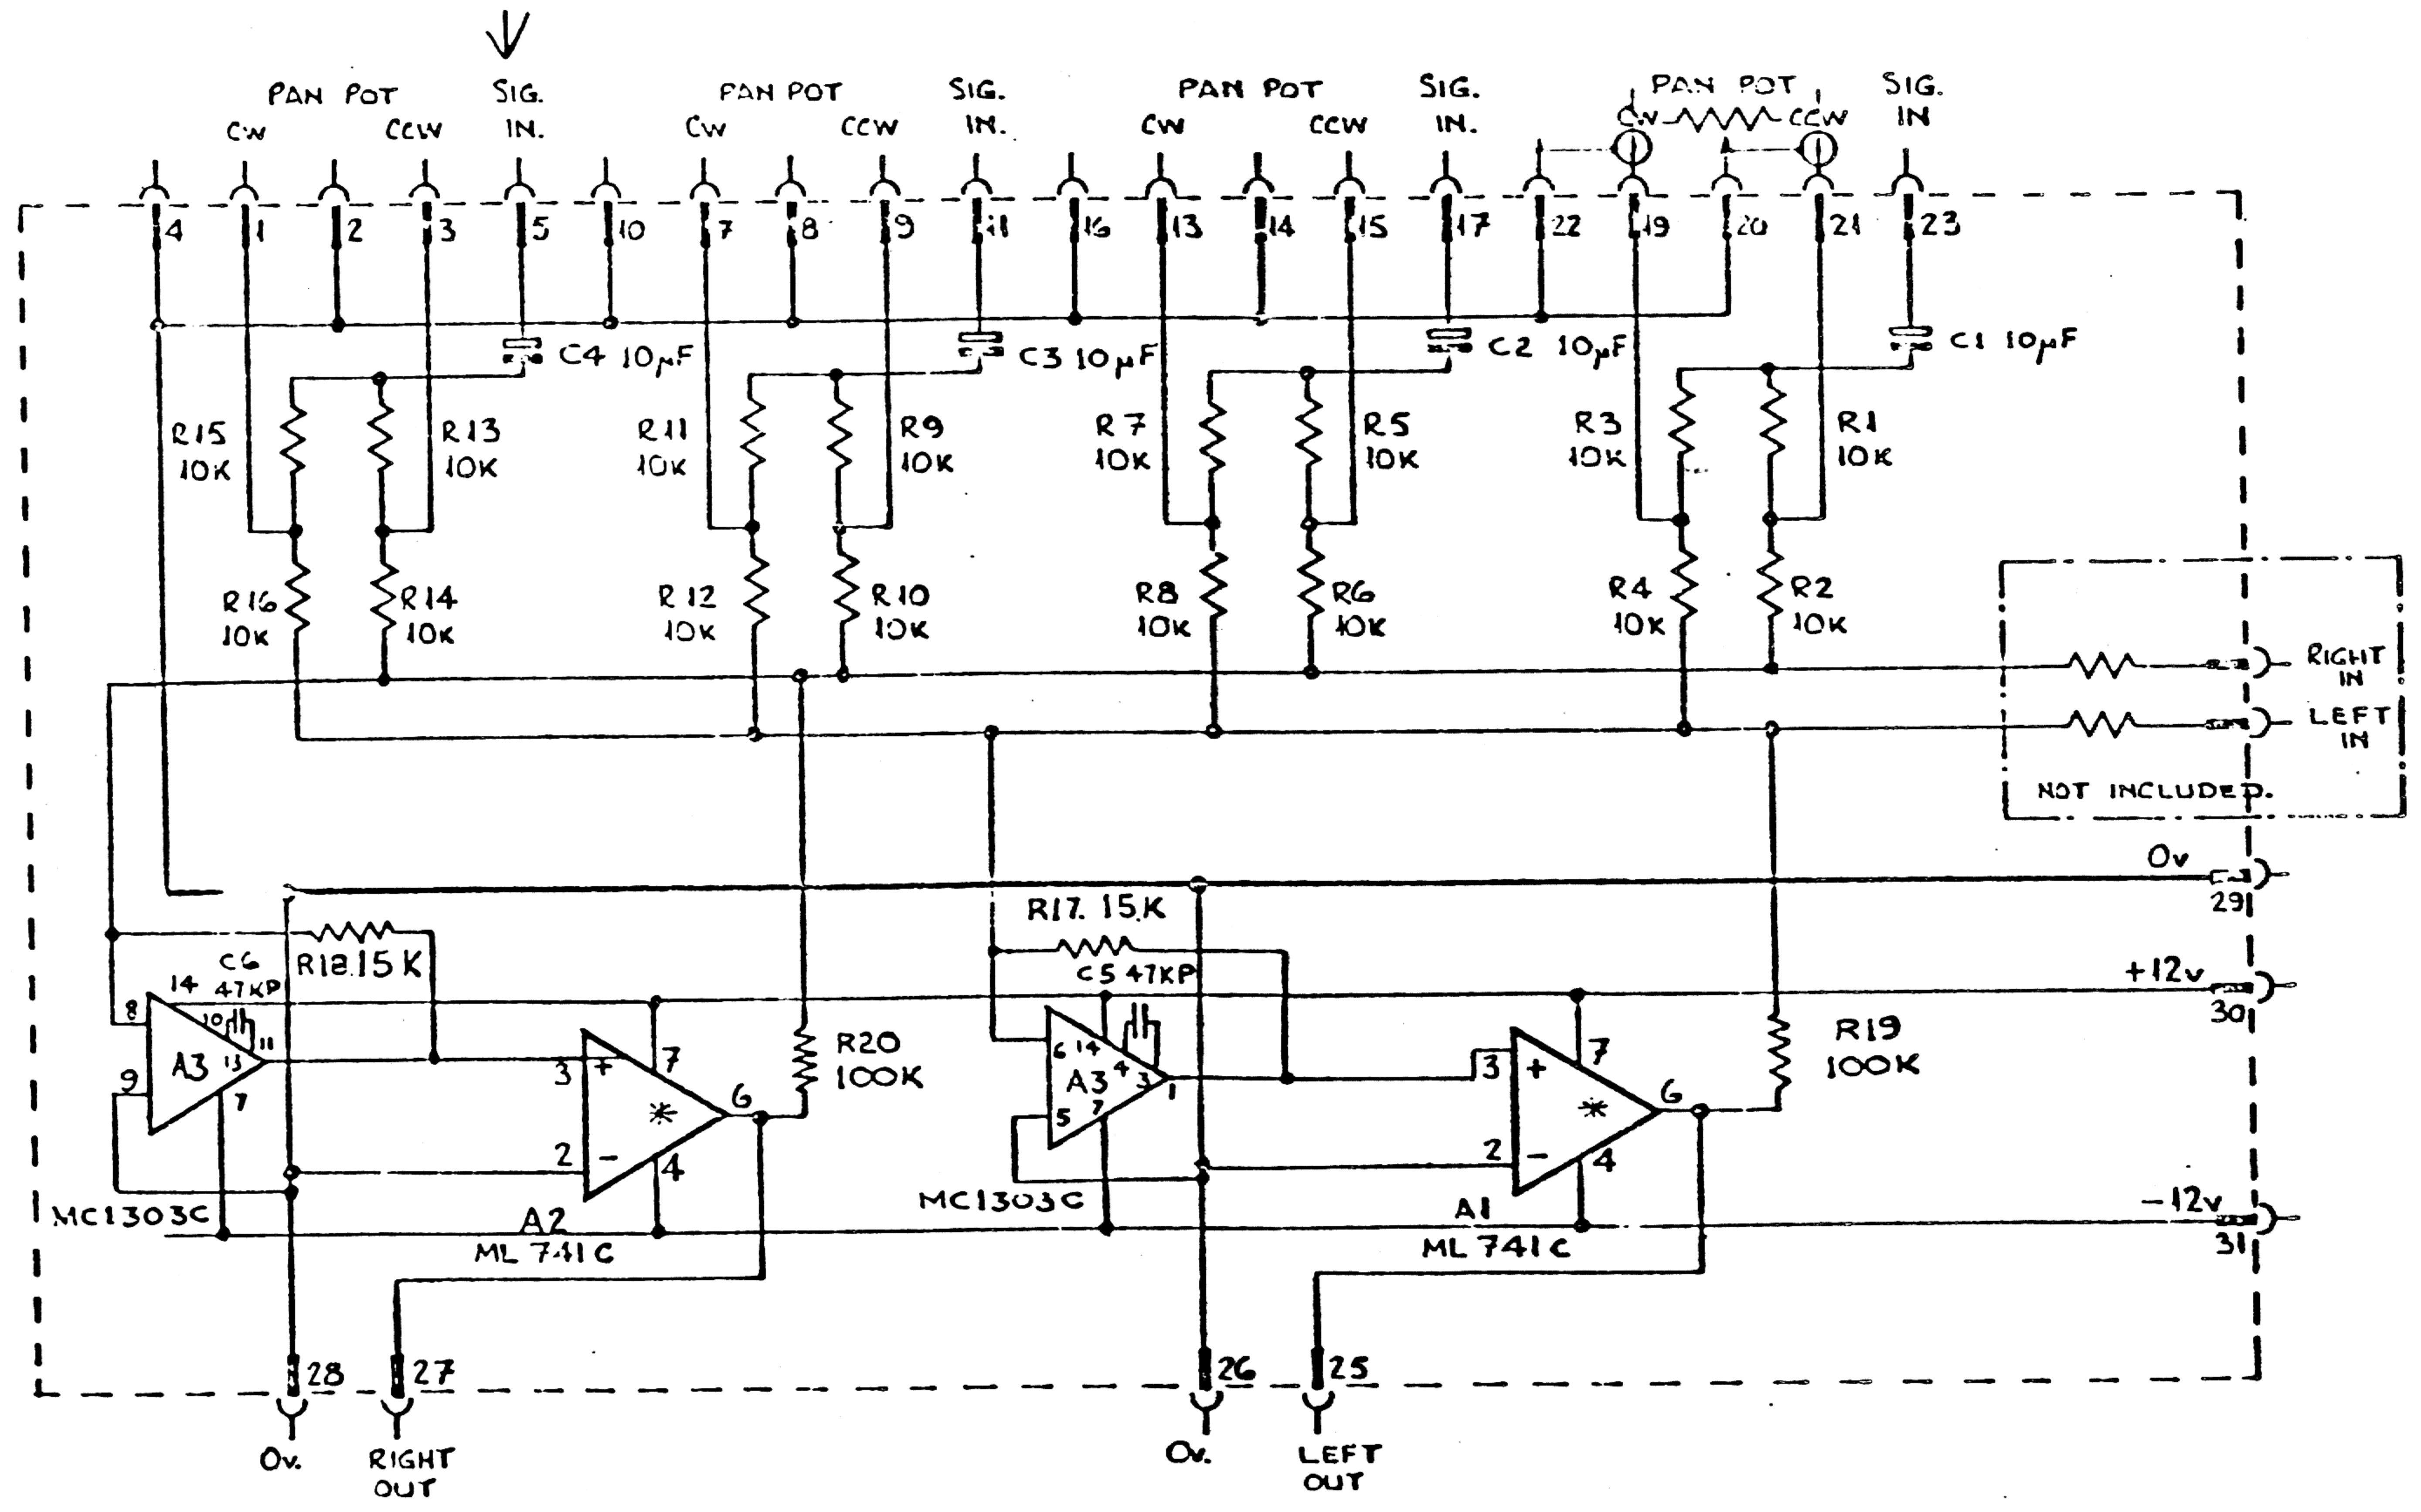


CIRCUIT DIAGRAM PAN SUMMING AMPS. DRG. N° E.M.S 32/14
 ISSUE E
 ELECTRONIC MUSIC STUDIOS (BOURNEMOUTH) LTD.

* A1 & A2 TO BE LOW NOISE TYPE
 (NOT TEXAS)

B C2 WAS 1Kp
 C3, C4, C5 ADDED
 M 16.4.71
 C R15 WAS 470K
 M 25.6.71.
 D RB Details changed.
 note. filed becomes PR4.
 M 28.6.71.
 E C2 & C3 d.d read 330Kp
 M 17.8.71.

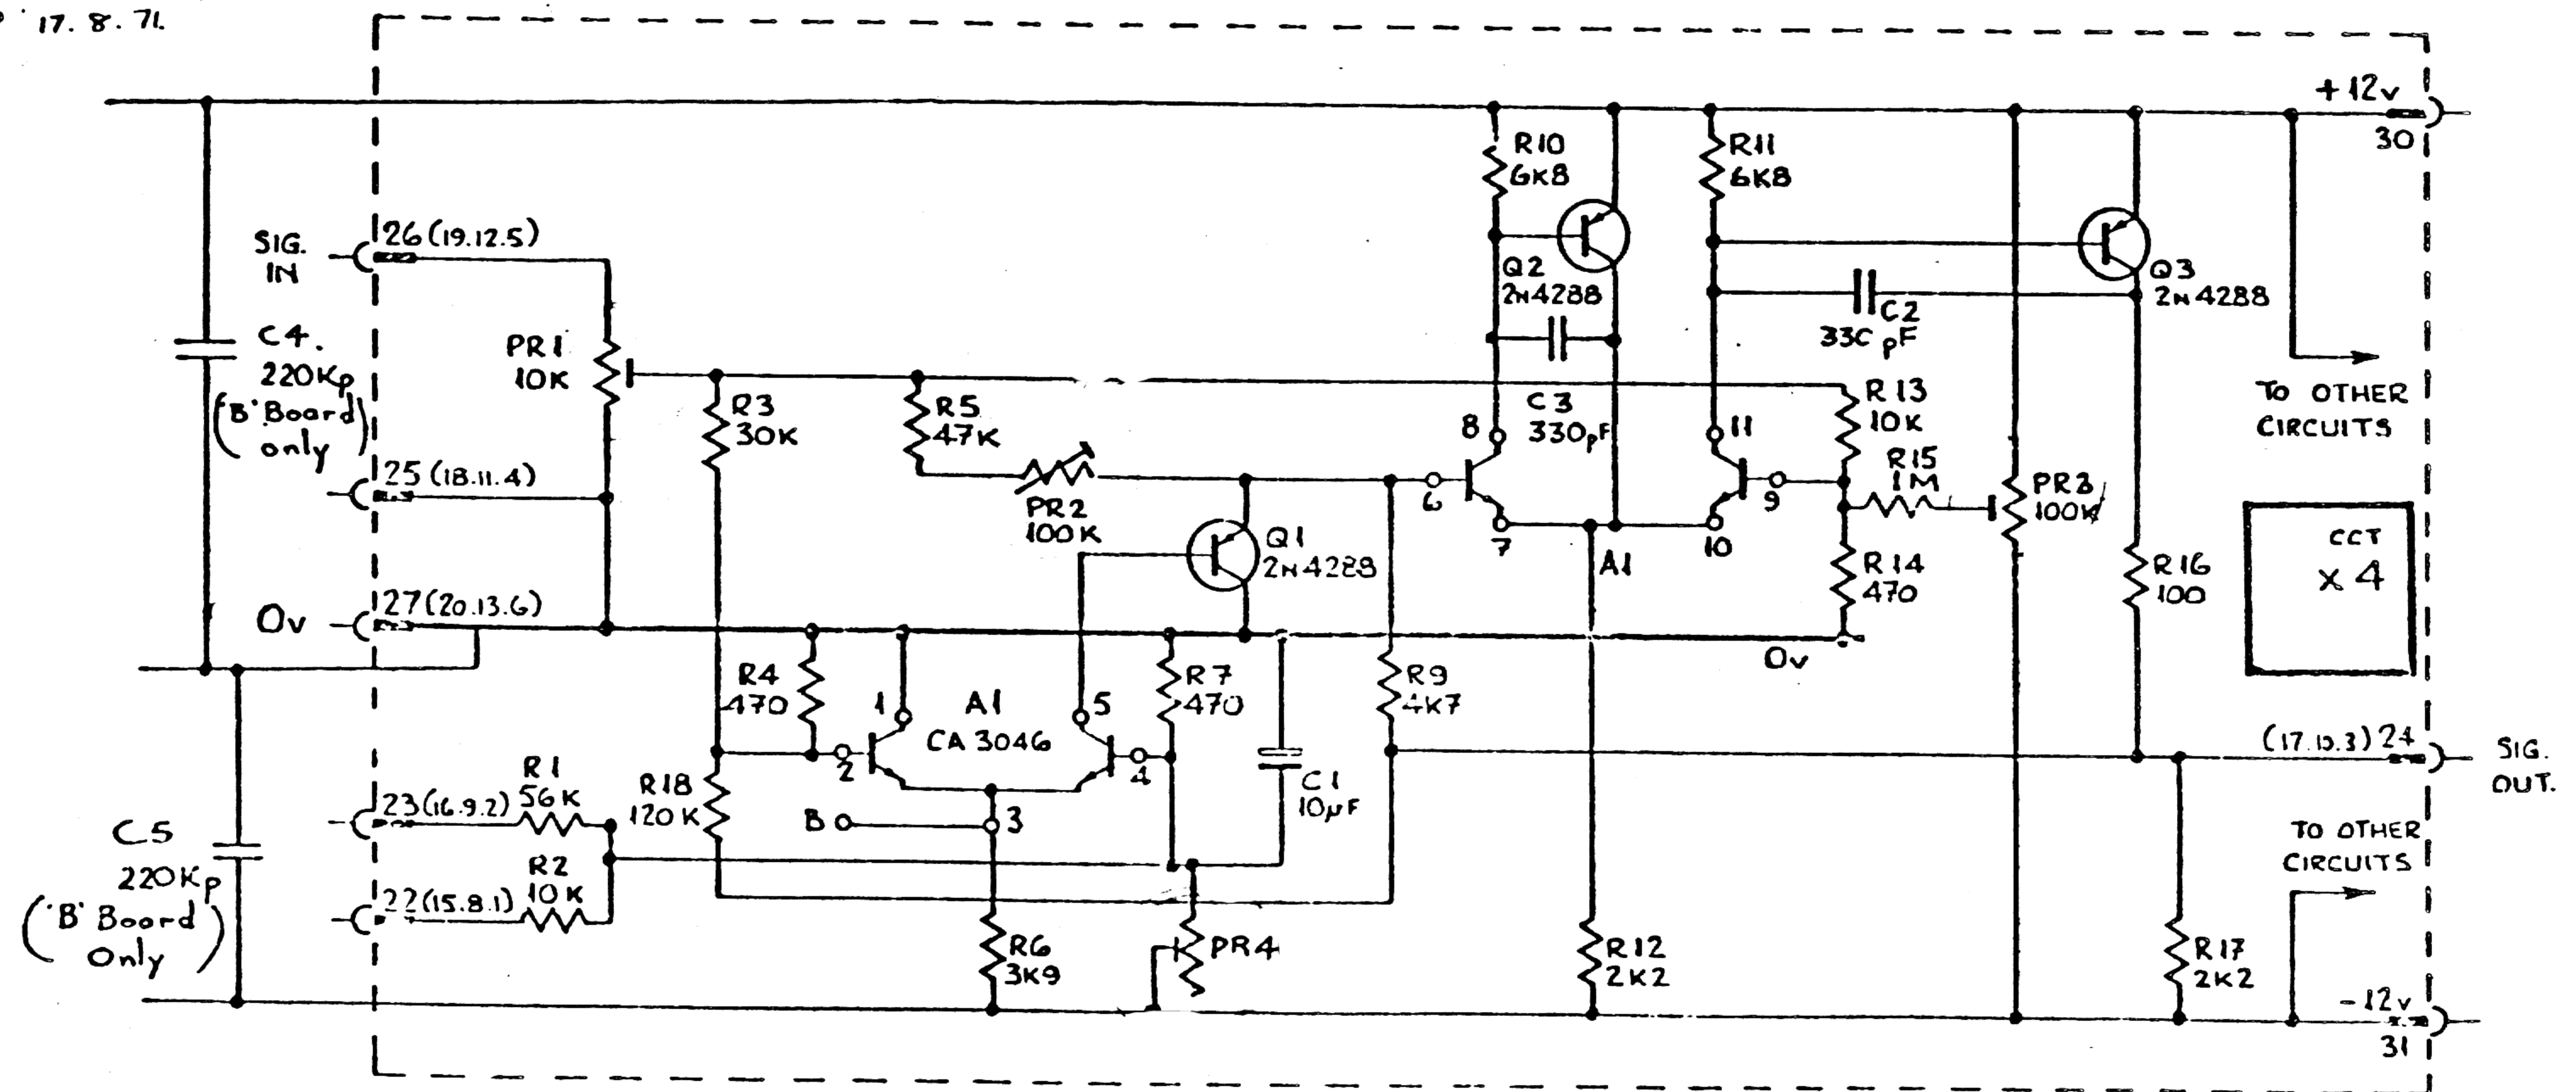

CIRCUIT DIAGRAM QUAD LOG MODULATOR. DRG. N° EMS32/15
 ISSUE E

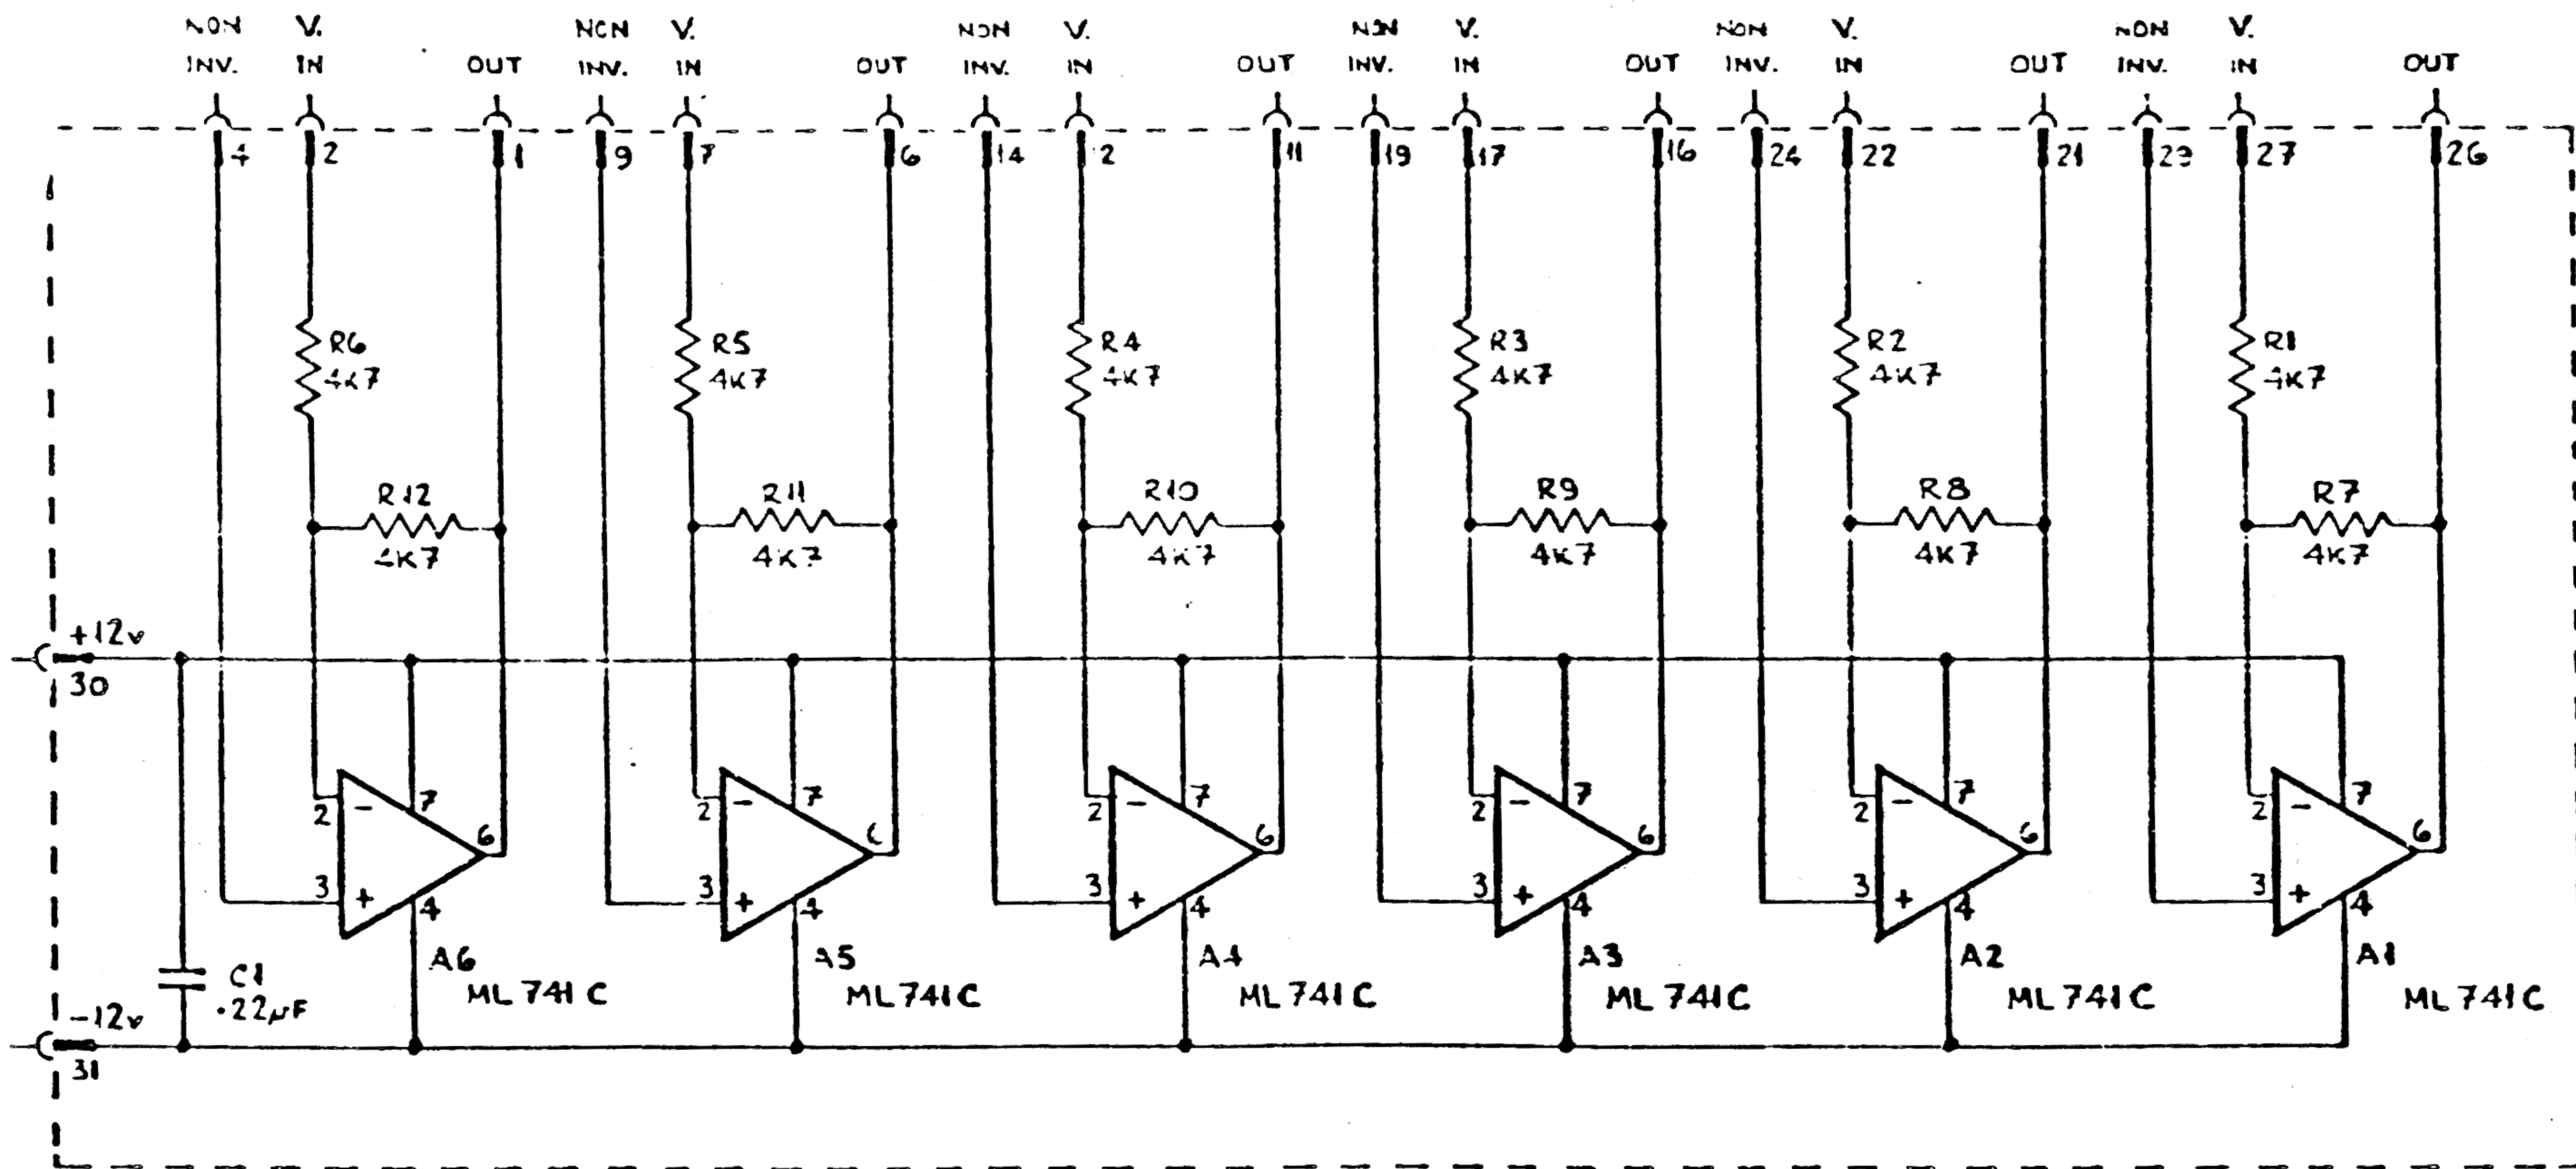

CIRCUIT DIAGRAM HEX OPERATIONAL AMP. FIER DRG. N° EMS 32/16
ISSUE A

ELECTRONIC MUSIC STUDIOS (BOURNEMOUTH) LTD.


B C7 WAS $.22\mu F$
 NOTES ADDED
 R13 - R18 ADDED
 26.4.71.

C PR7 - PR12 ADDED
 19.5.71.

D R13 - R18 DELETED.
 I_{IN} WAS SHOWN.
 COMING FROM JUNC.
 OF R6 & PR12
 17.6.71.

E R7 to R12
 WAS 3K9.
 2.9.71.

F CN 49 4-4-73
 DE

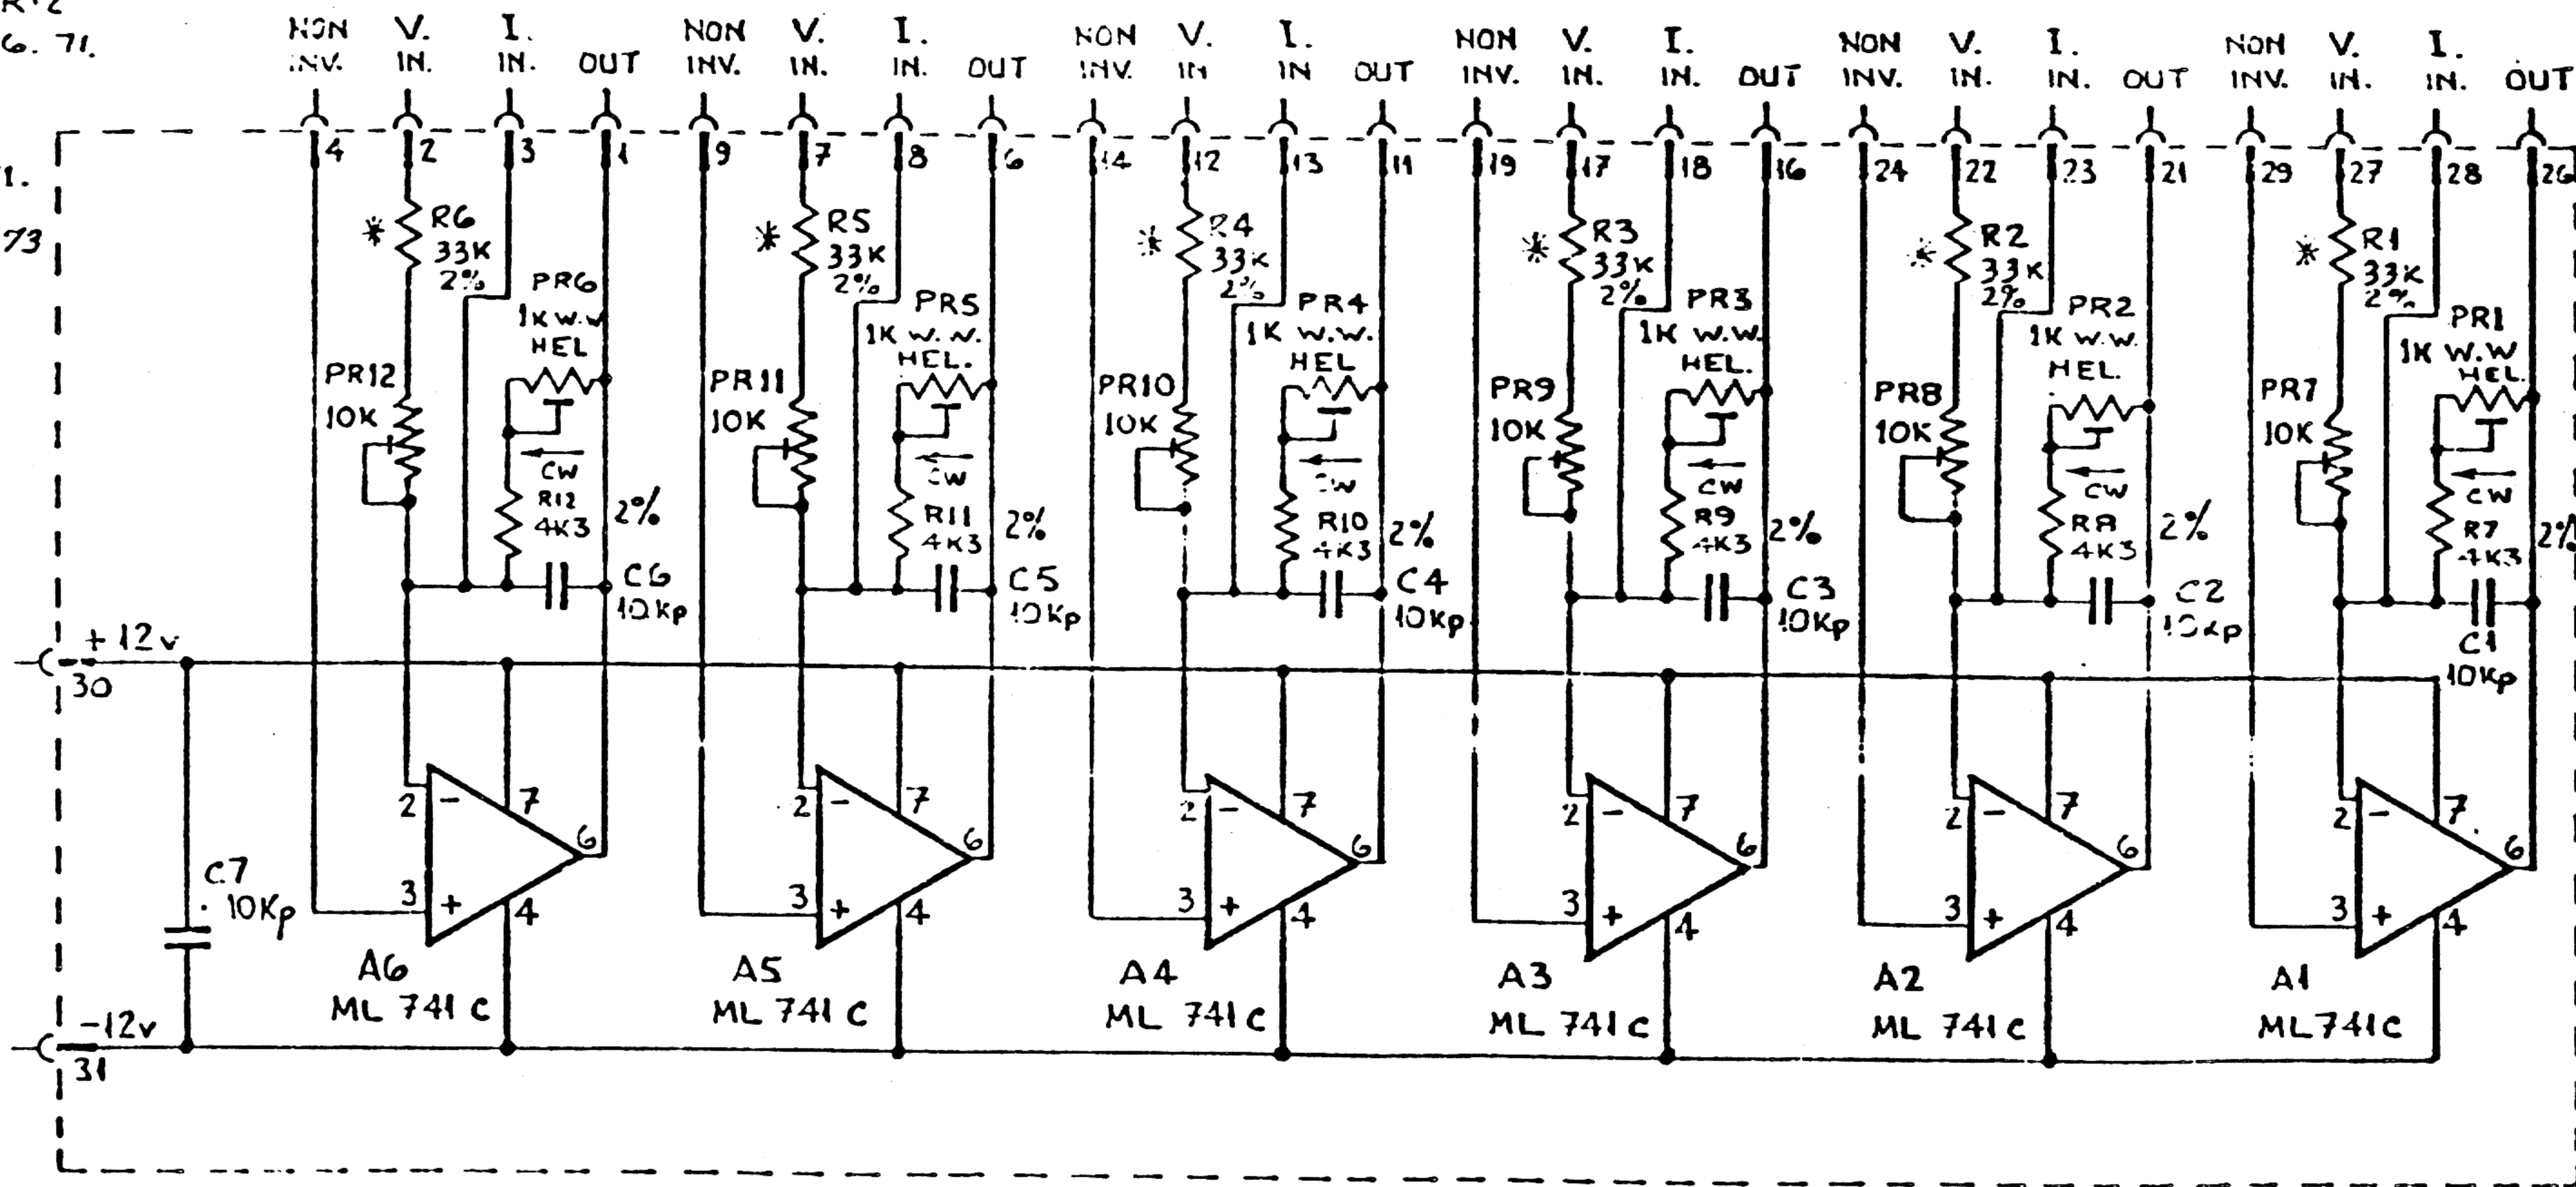

10K Tripart in series with R* Osc 1-9


Replace 22K with 33K on circs 1-4 L.P. Filters

CIRCUIT DIAGRAM HEX OPERATIONAL AMPLIFIERS DRGN° EMS 32/17
 SUMMING BUFFER.


ISSUE F

ELECTRONIC MUSIC STUDIOS (BOURNEMOUTH) LTD.

B NOTE ADDED.
M 15.4.71
C C11 & C12 ADDED
M 28.4.71.
D ... ADDED
M 17.6.71.
E ... ADDED
M 11.8.71.

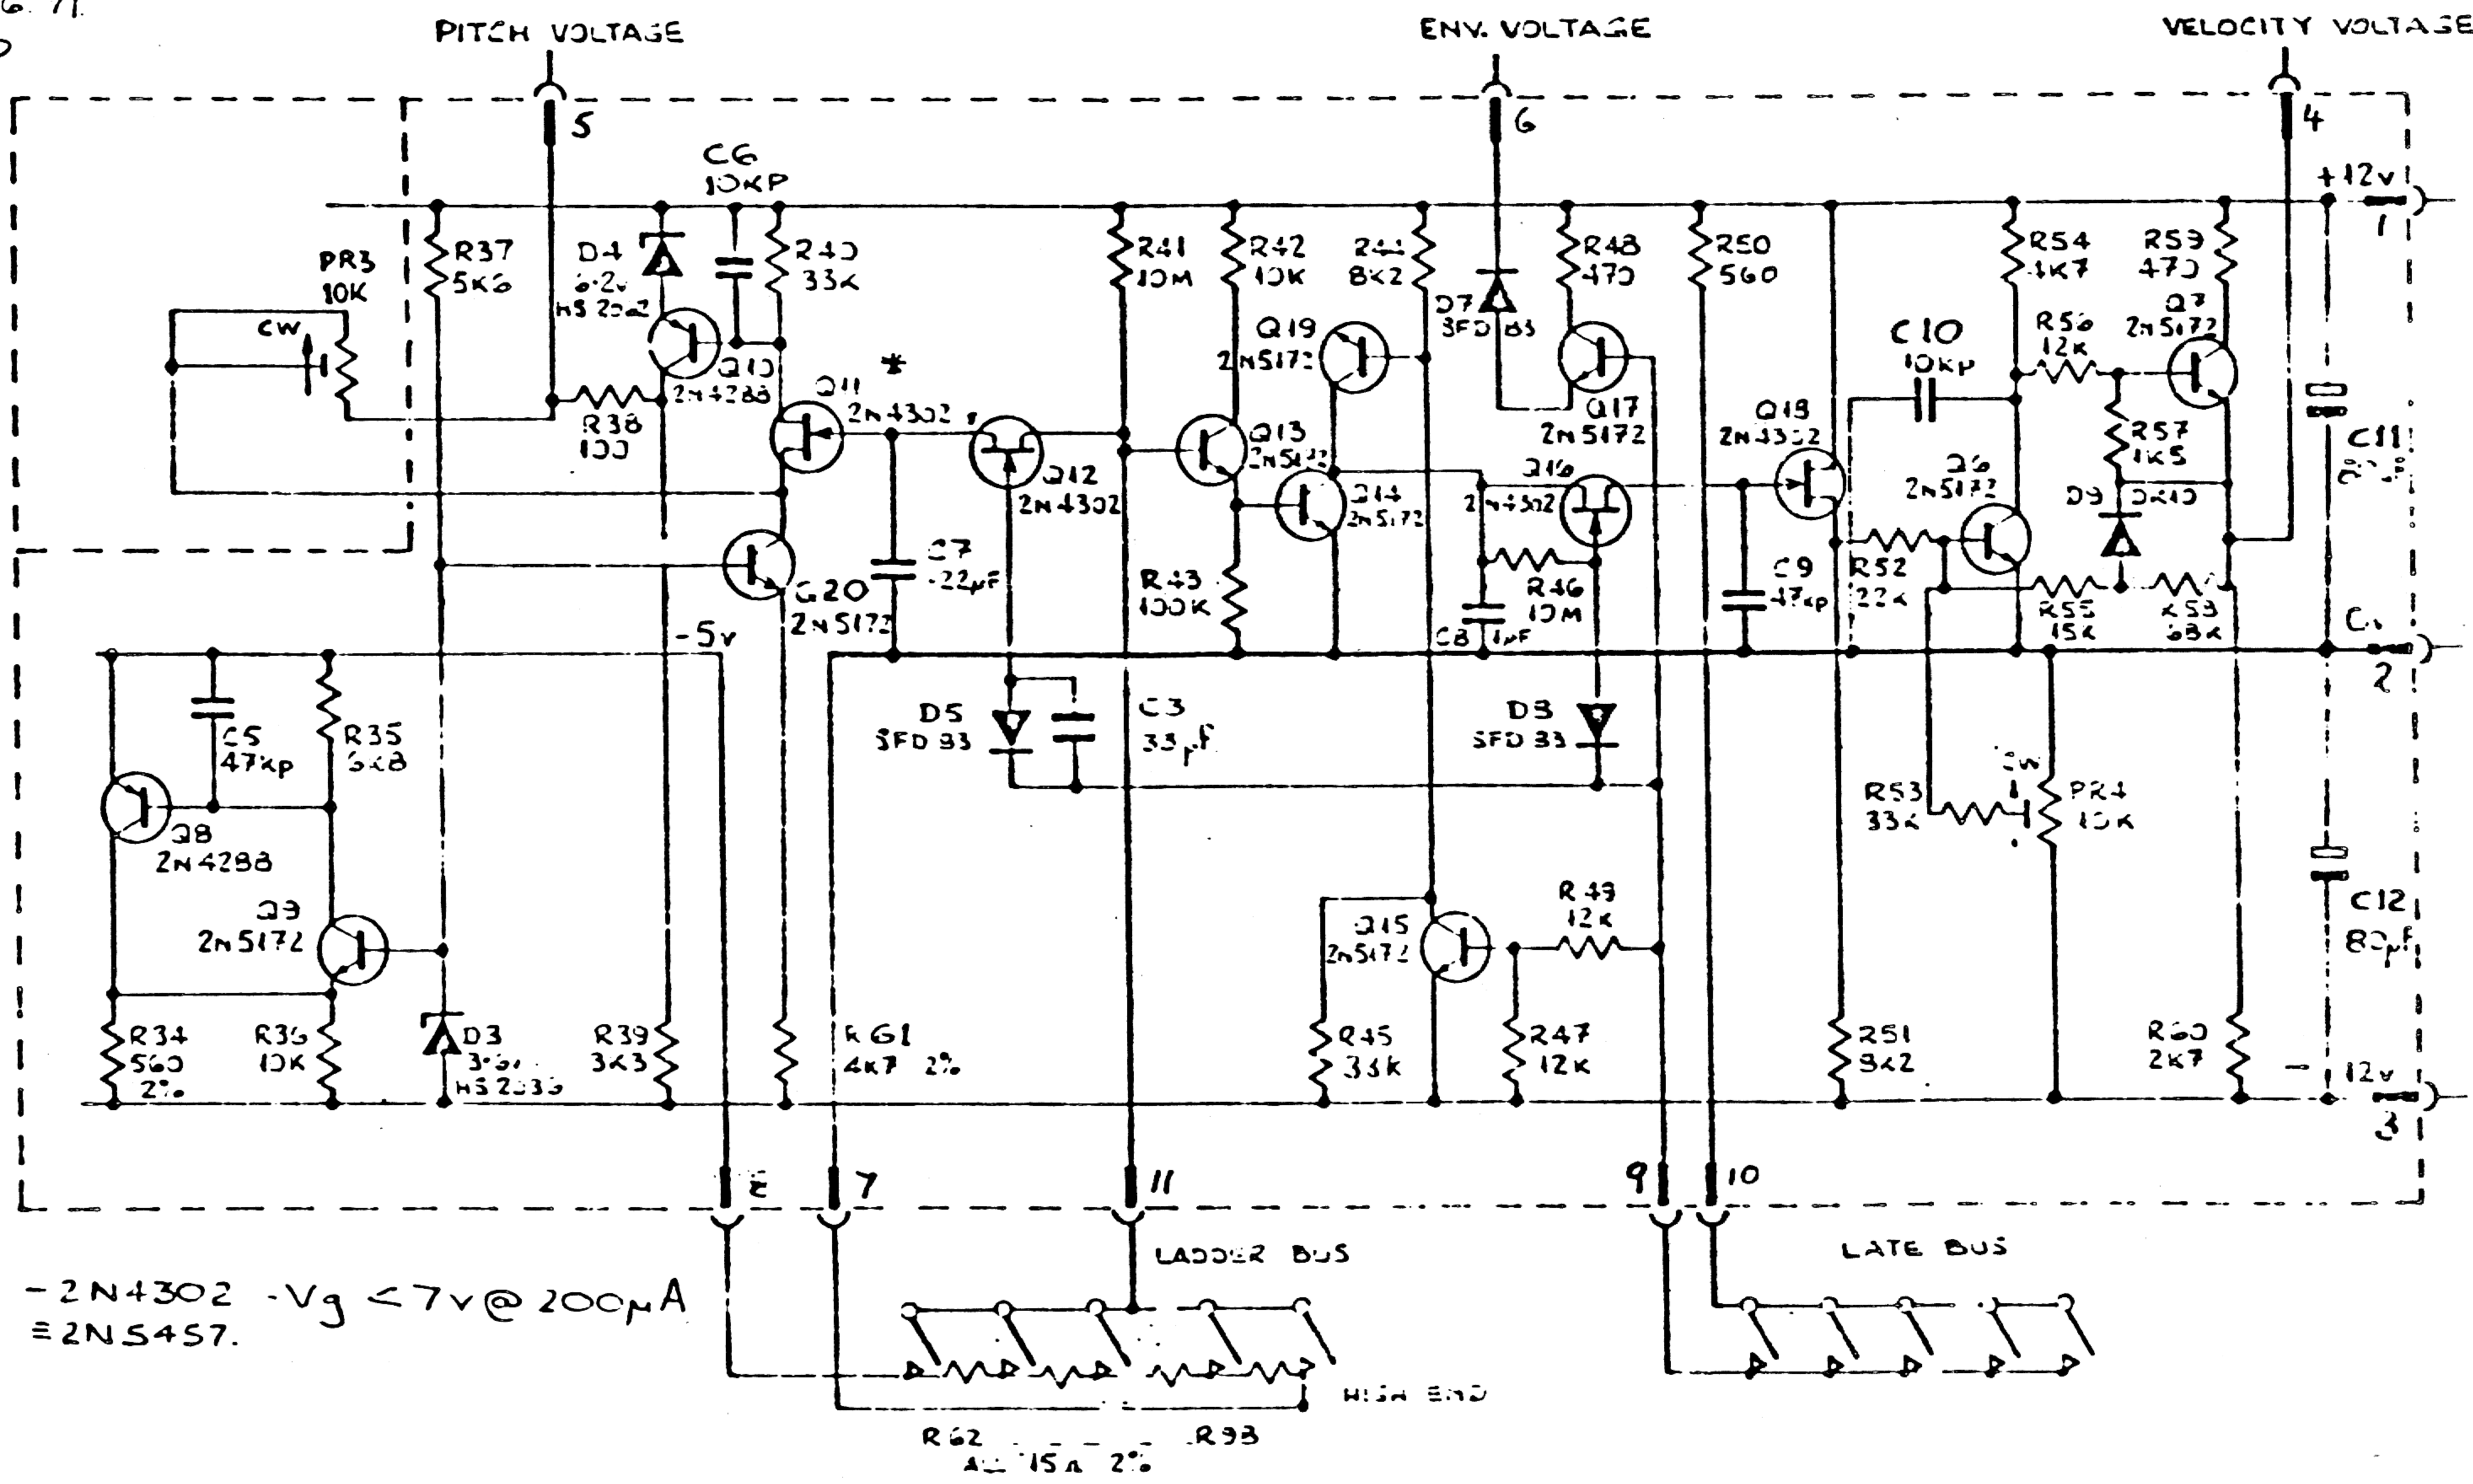

CIRCUIT DIAGRAM MODIFIED DYNAMIC KEYBOARD. SER. NO. EMS 32/12
ISSUE E
ELECTRONIC MUSIC STUDIOS (BOURNEMOUTH) LTD

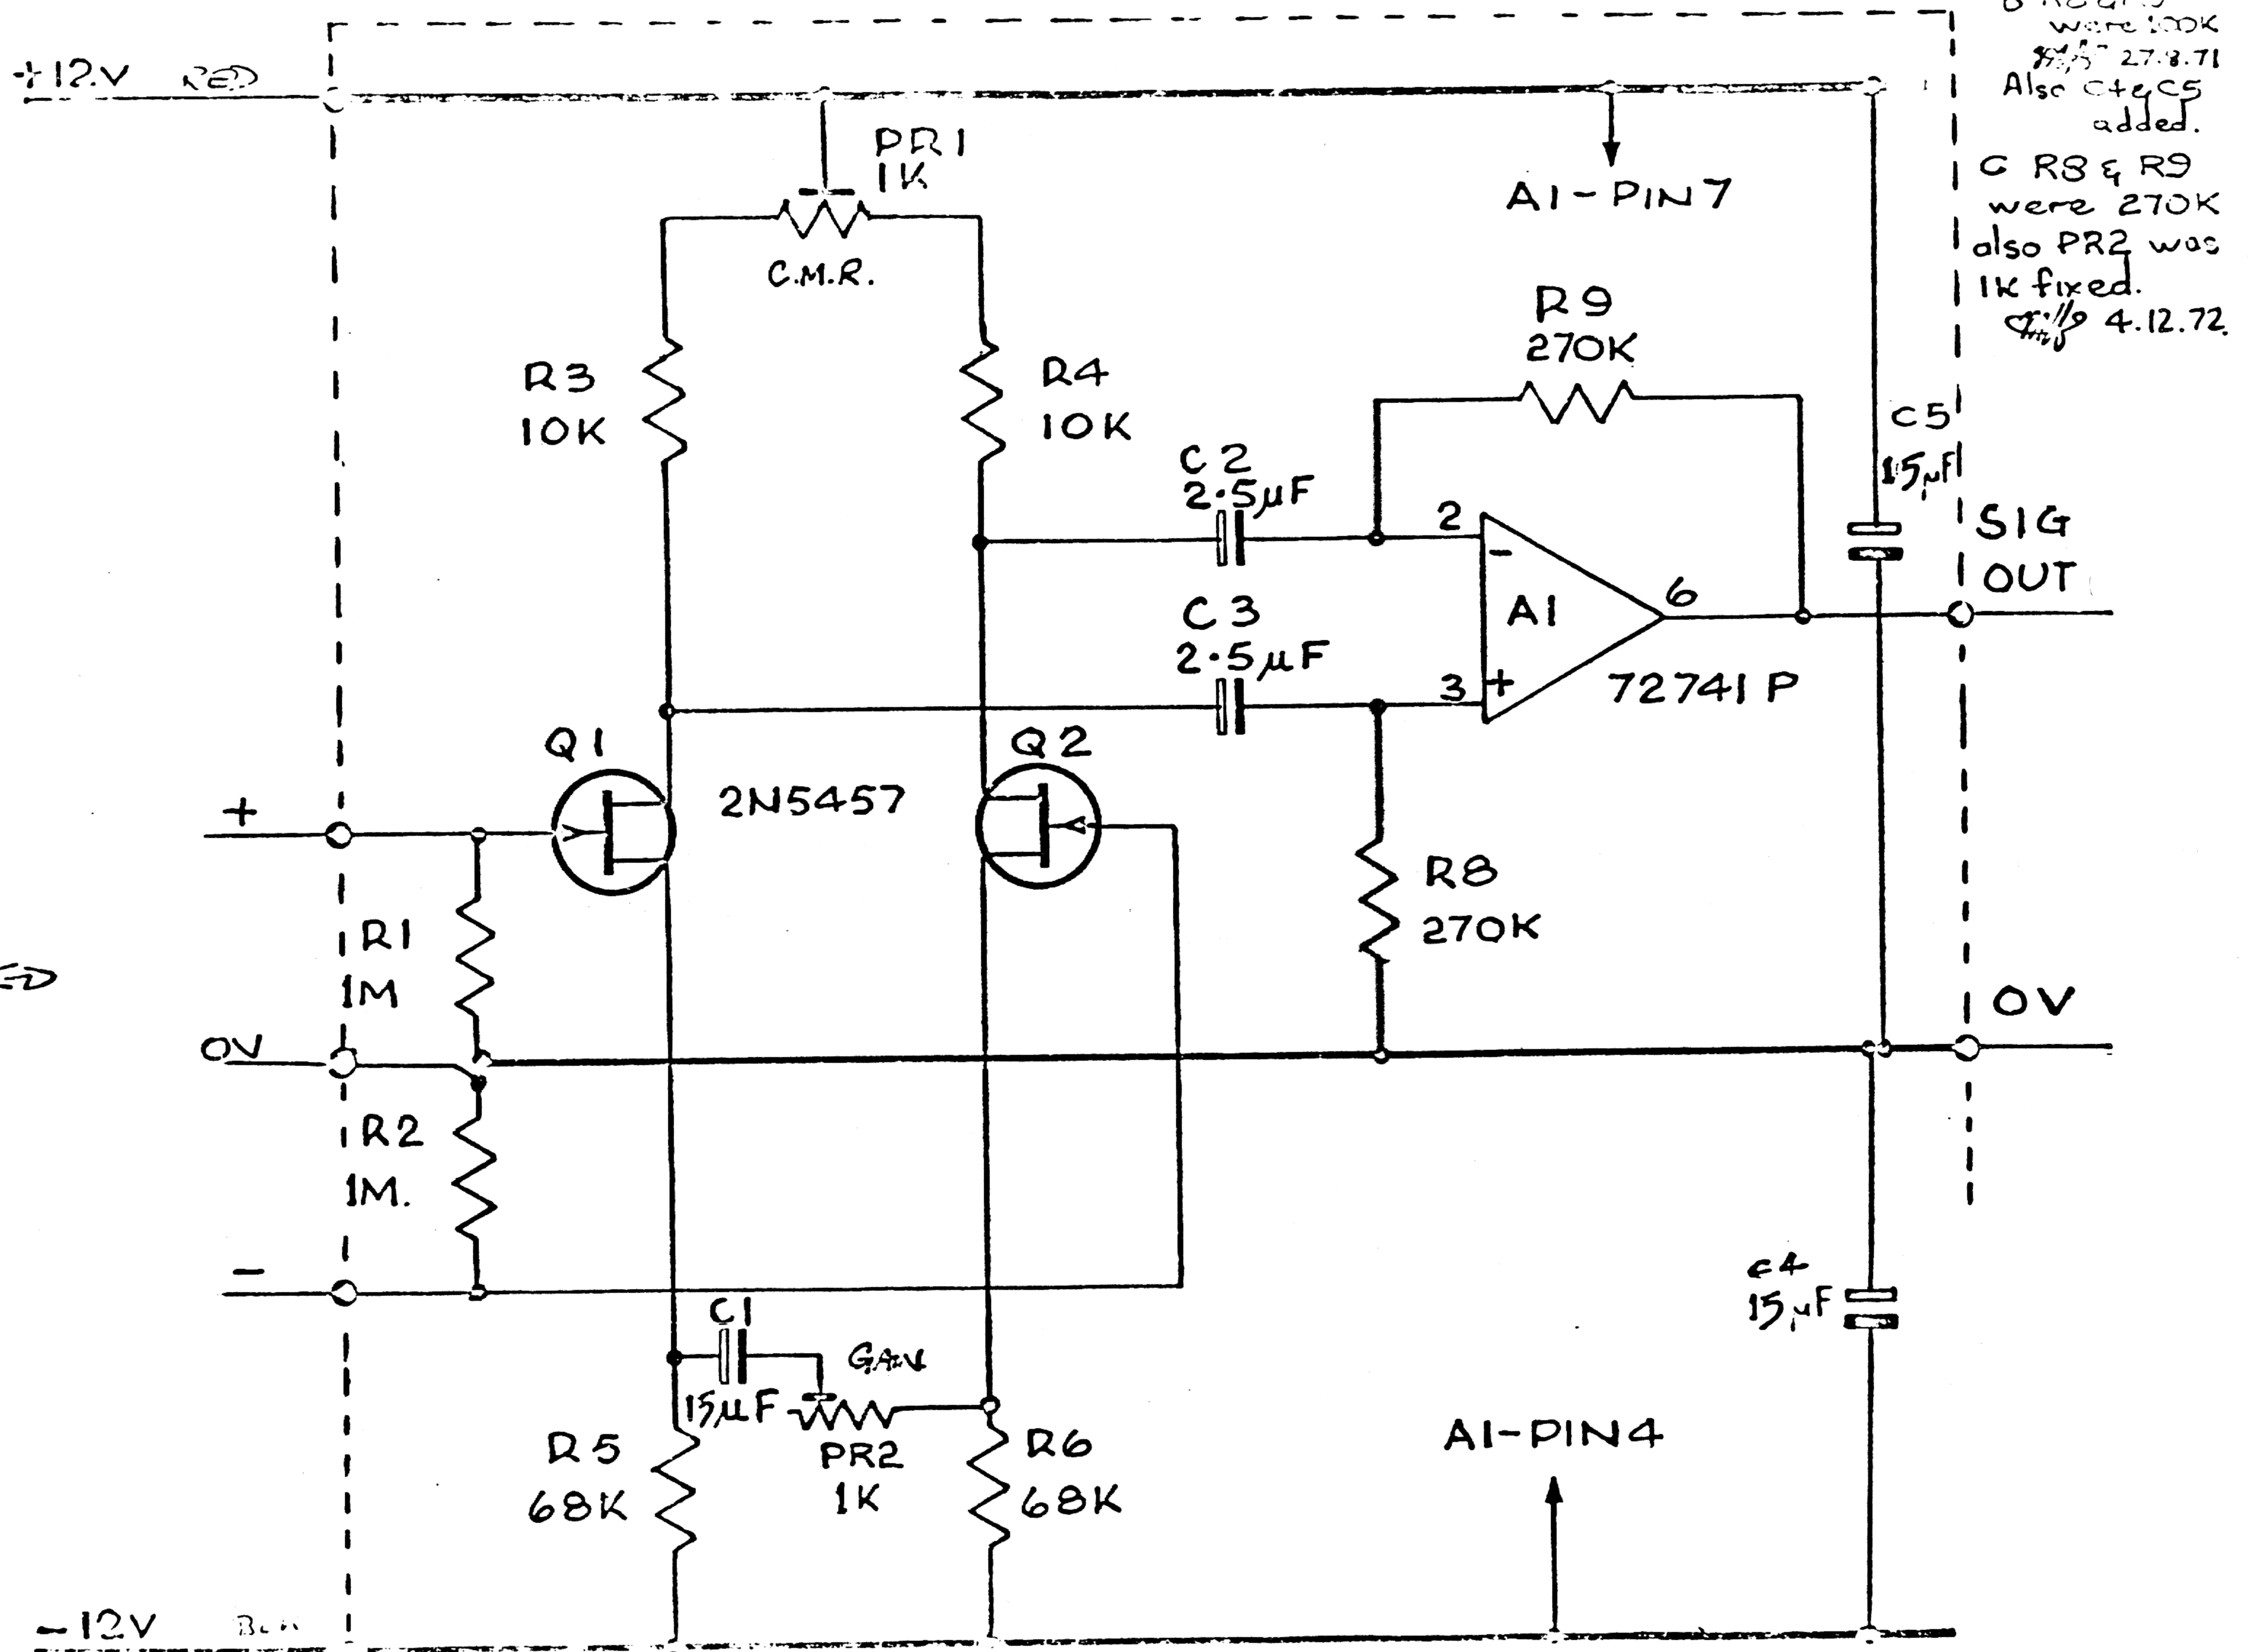

B R8 & R9 were 100K
 27.8.71
 Also C4 & C5 added.
 C R8 & R9 were 270K
 also PR2 was 1K fixed.
 4.12.72

BALANCED
 MIC:
 INPUT

CIRCUIT DIAGRAM: MIC: AMP DRG: N° EMS 32-51

ELECTRO MUSIC STUDIOS (BOURNEMOUTH) LTD 1972



12v
0v
12v
Voltage
Voltage
Voltage

UPPER

BOTH CIRCUITS IDENTICAL.

LOWER

Emitter to be cut out.

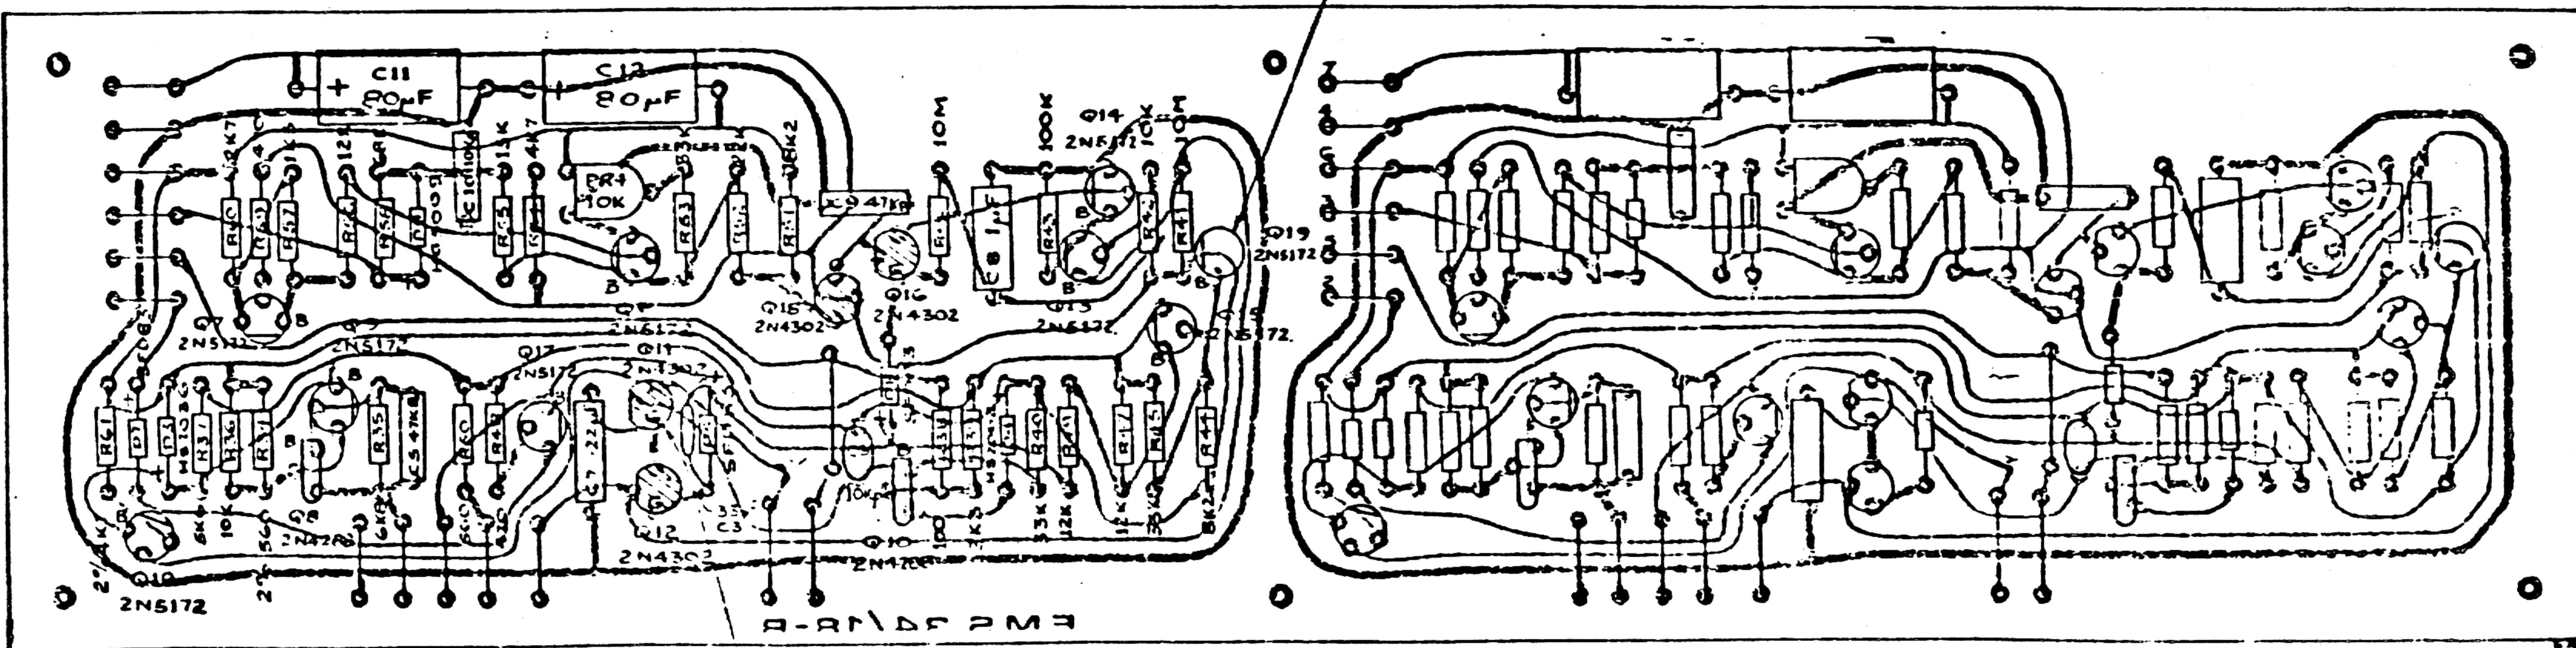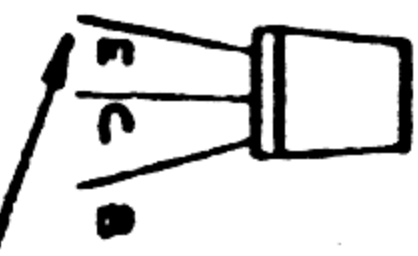

7u 8u 9u 10u 11u

7L 8L 9L 10L 11L

Q11 Selected 2N4302 ($V_{\beta} < 0.7V @ 200\mu A$)
2N5457 Preferred.

Transistors shown thus to have Lead Sockets mounted in P.C.B.

ELECTRONIC MUSIC STUDIOS
BOURNEMOUTH LTD


TITLE DYNAMIC KEYBOARD

DRG N° 33/18 ISSUE βC

DRN M/ 28.4.71.

33/18


View from Connectors.

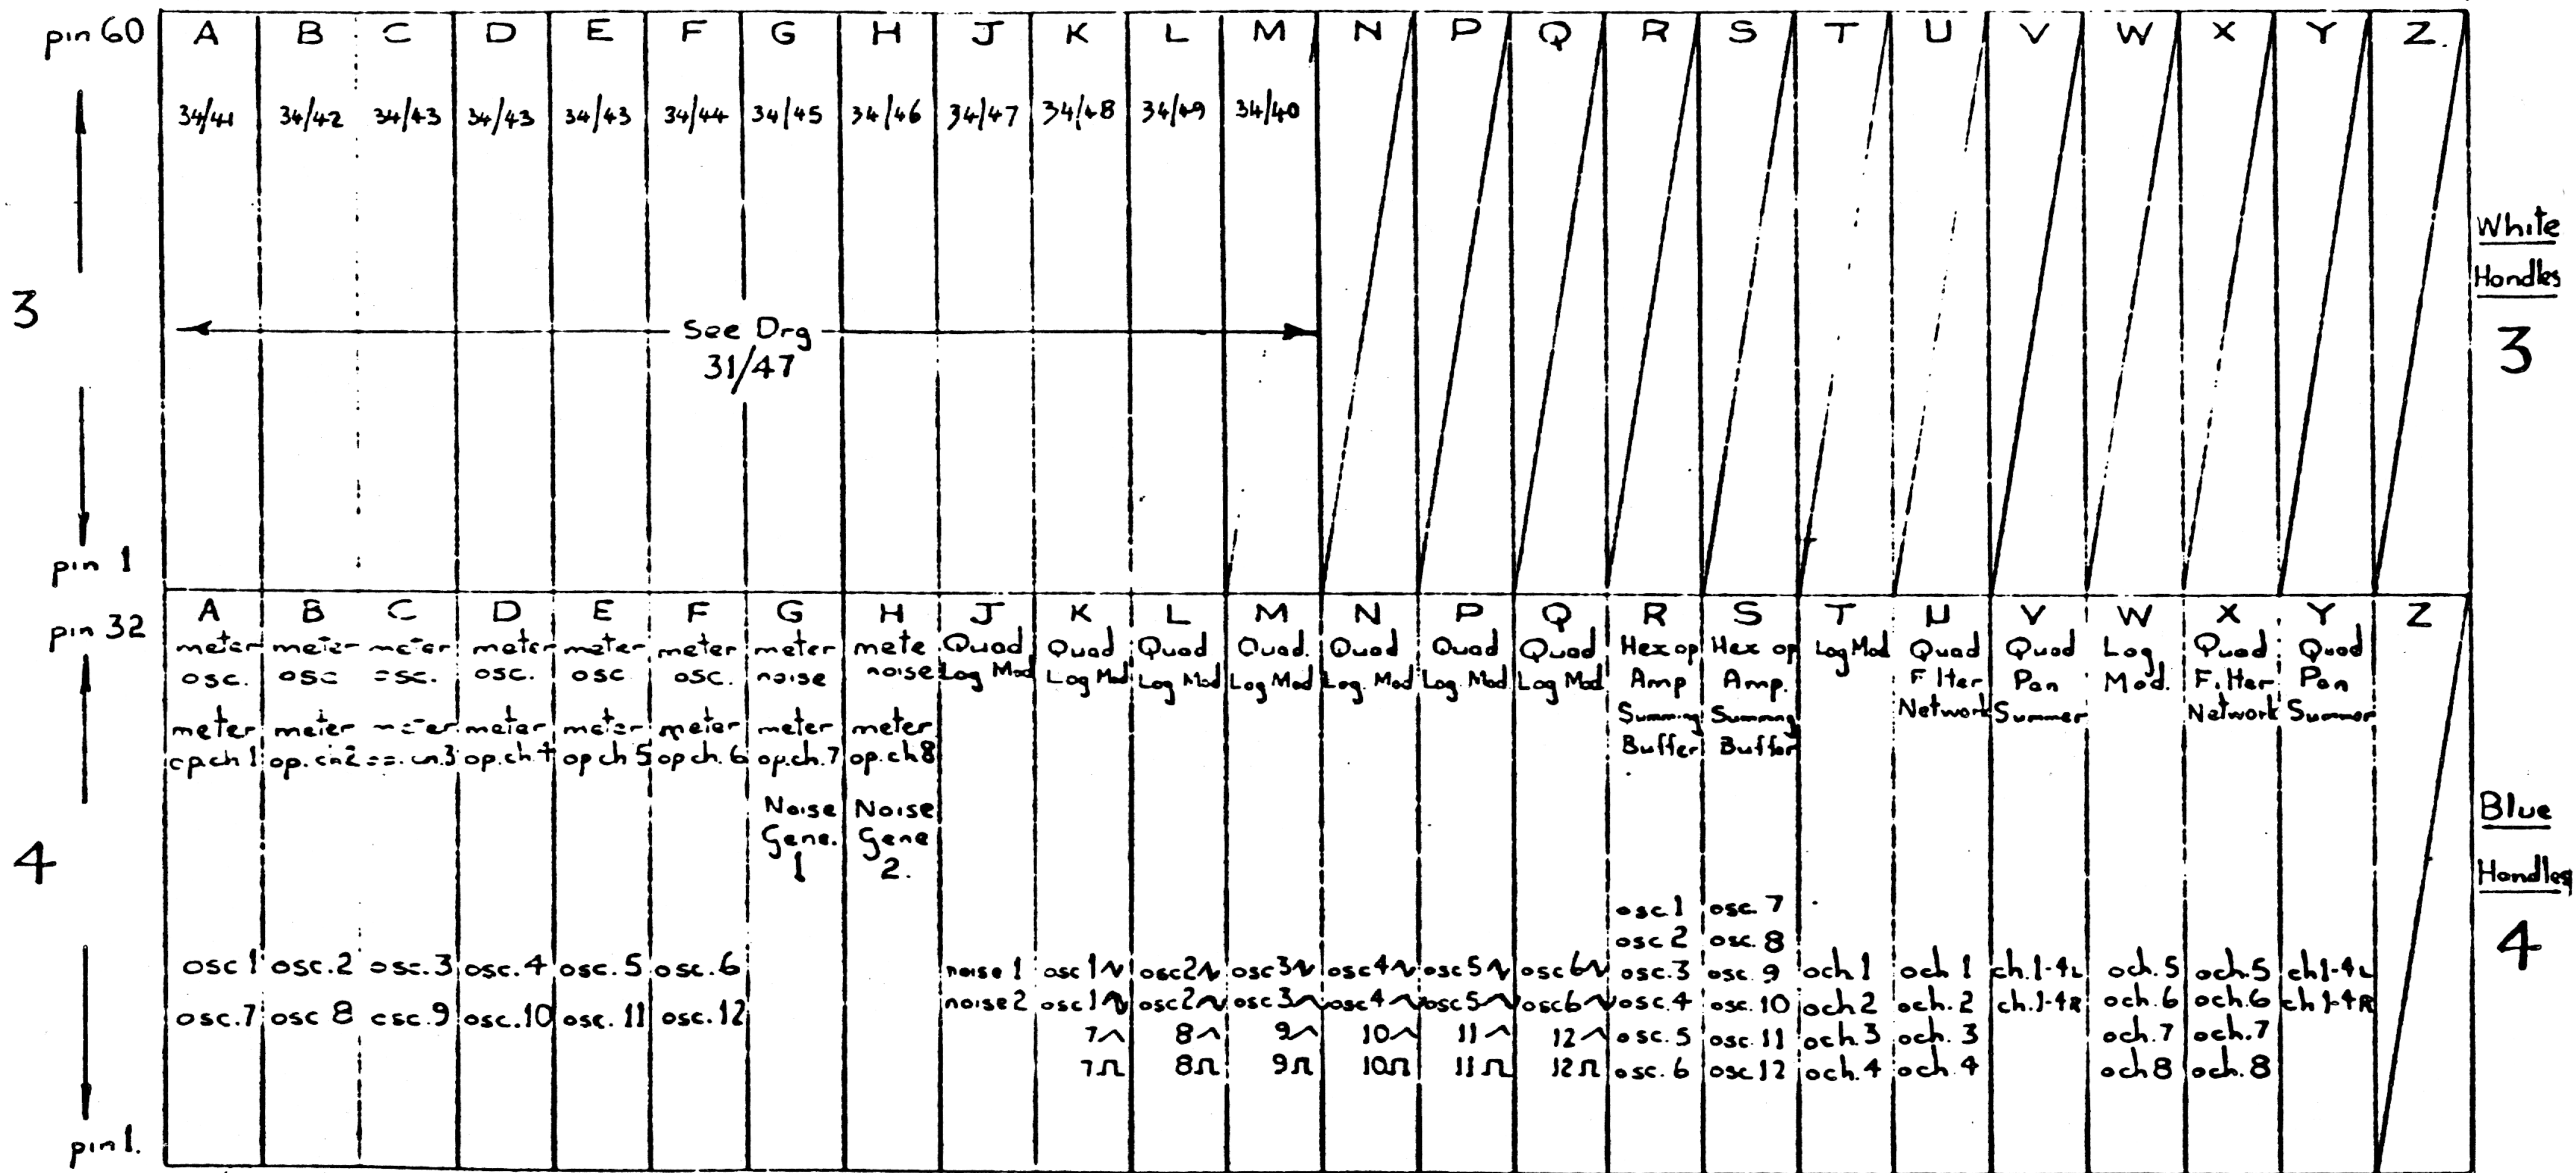


34/06 34/06 34/06 34/06 34/06 34/06 34/07 34/07 34/15 34/15 34/15 34/15 34/15 34/15 34/15 34/17 34/17 34/03 34/13 34/14 34/03 34/13 34/14. P.C.B. N°
 31/16 31/16 31/16 31/16 31/16 31/16 31/19 31/19 31/19 31/16 31/16 31/16 31/16 31/16 31/16 31/16 31/18 31/25 31/25 31/25 31/26 31/26 31/26 Interconnection N°
 31/17 31/17 31/17 31/17 31/17 31/17 31/17 31/17 31/17 31/18 31/18 31/18 31/18 31/18 31/18
 31/18 31/18 31/18 31/18 31/18 31/18

8 positions T&W.
 were 34/15
 P.C.B.
 T.R.K. 24/4/73


ELECTRONIC MUSIC STUDIOS (Bournemouth) Ltd		issue 8
MATL	TITLE MODULE LOCATION CARD FRAME 344	Drg No 31/02
FINISH	UNIT ON SYNTHI 100	
TOL	FEAR	CHKD
DATE	DATE	DATE

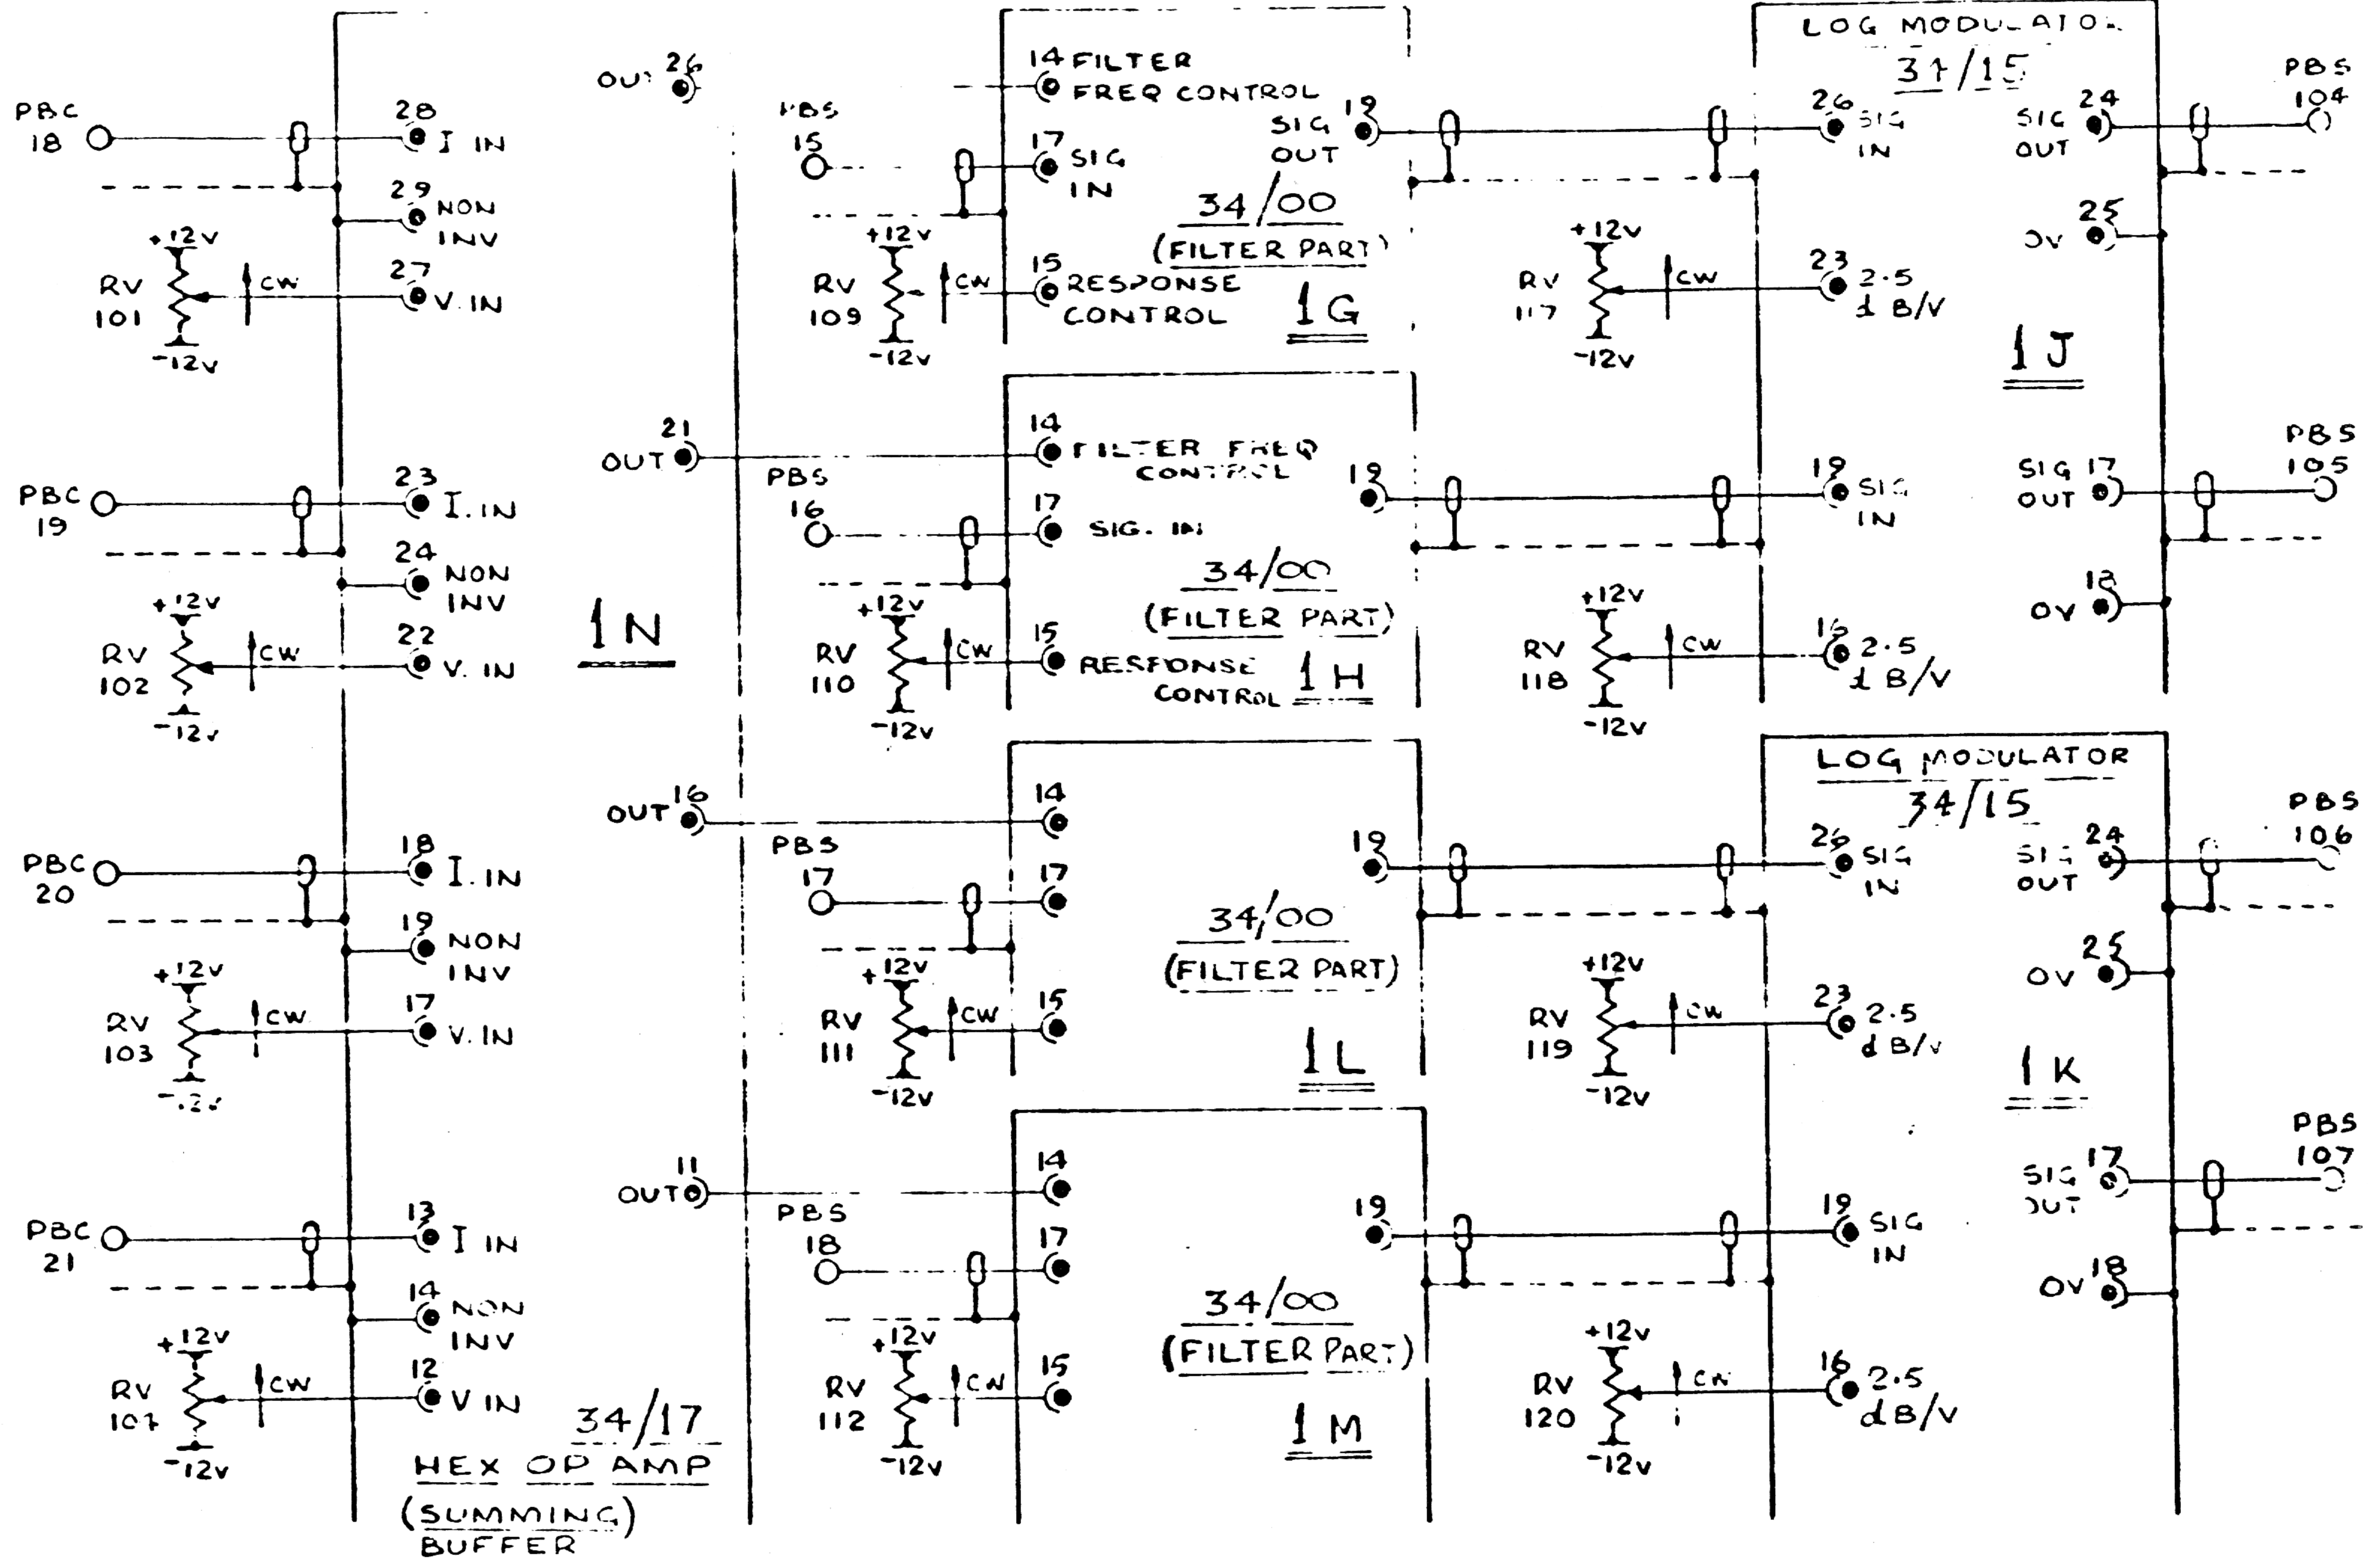


ELECTRONIC MUSIC STUDIOS Bournemouth Ltd		Issue A
L.P. FILTER/OSC 1-4		Draw No.
SYNTHI 100		31/06
NO.	DATE	DATE

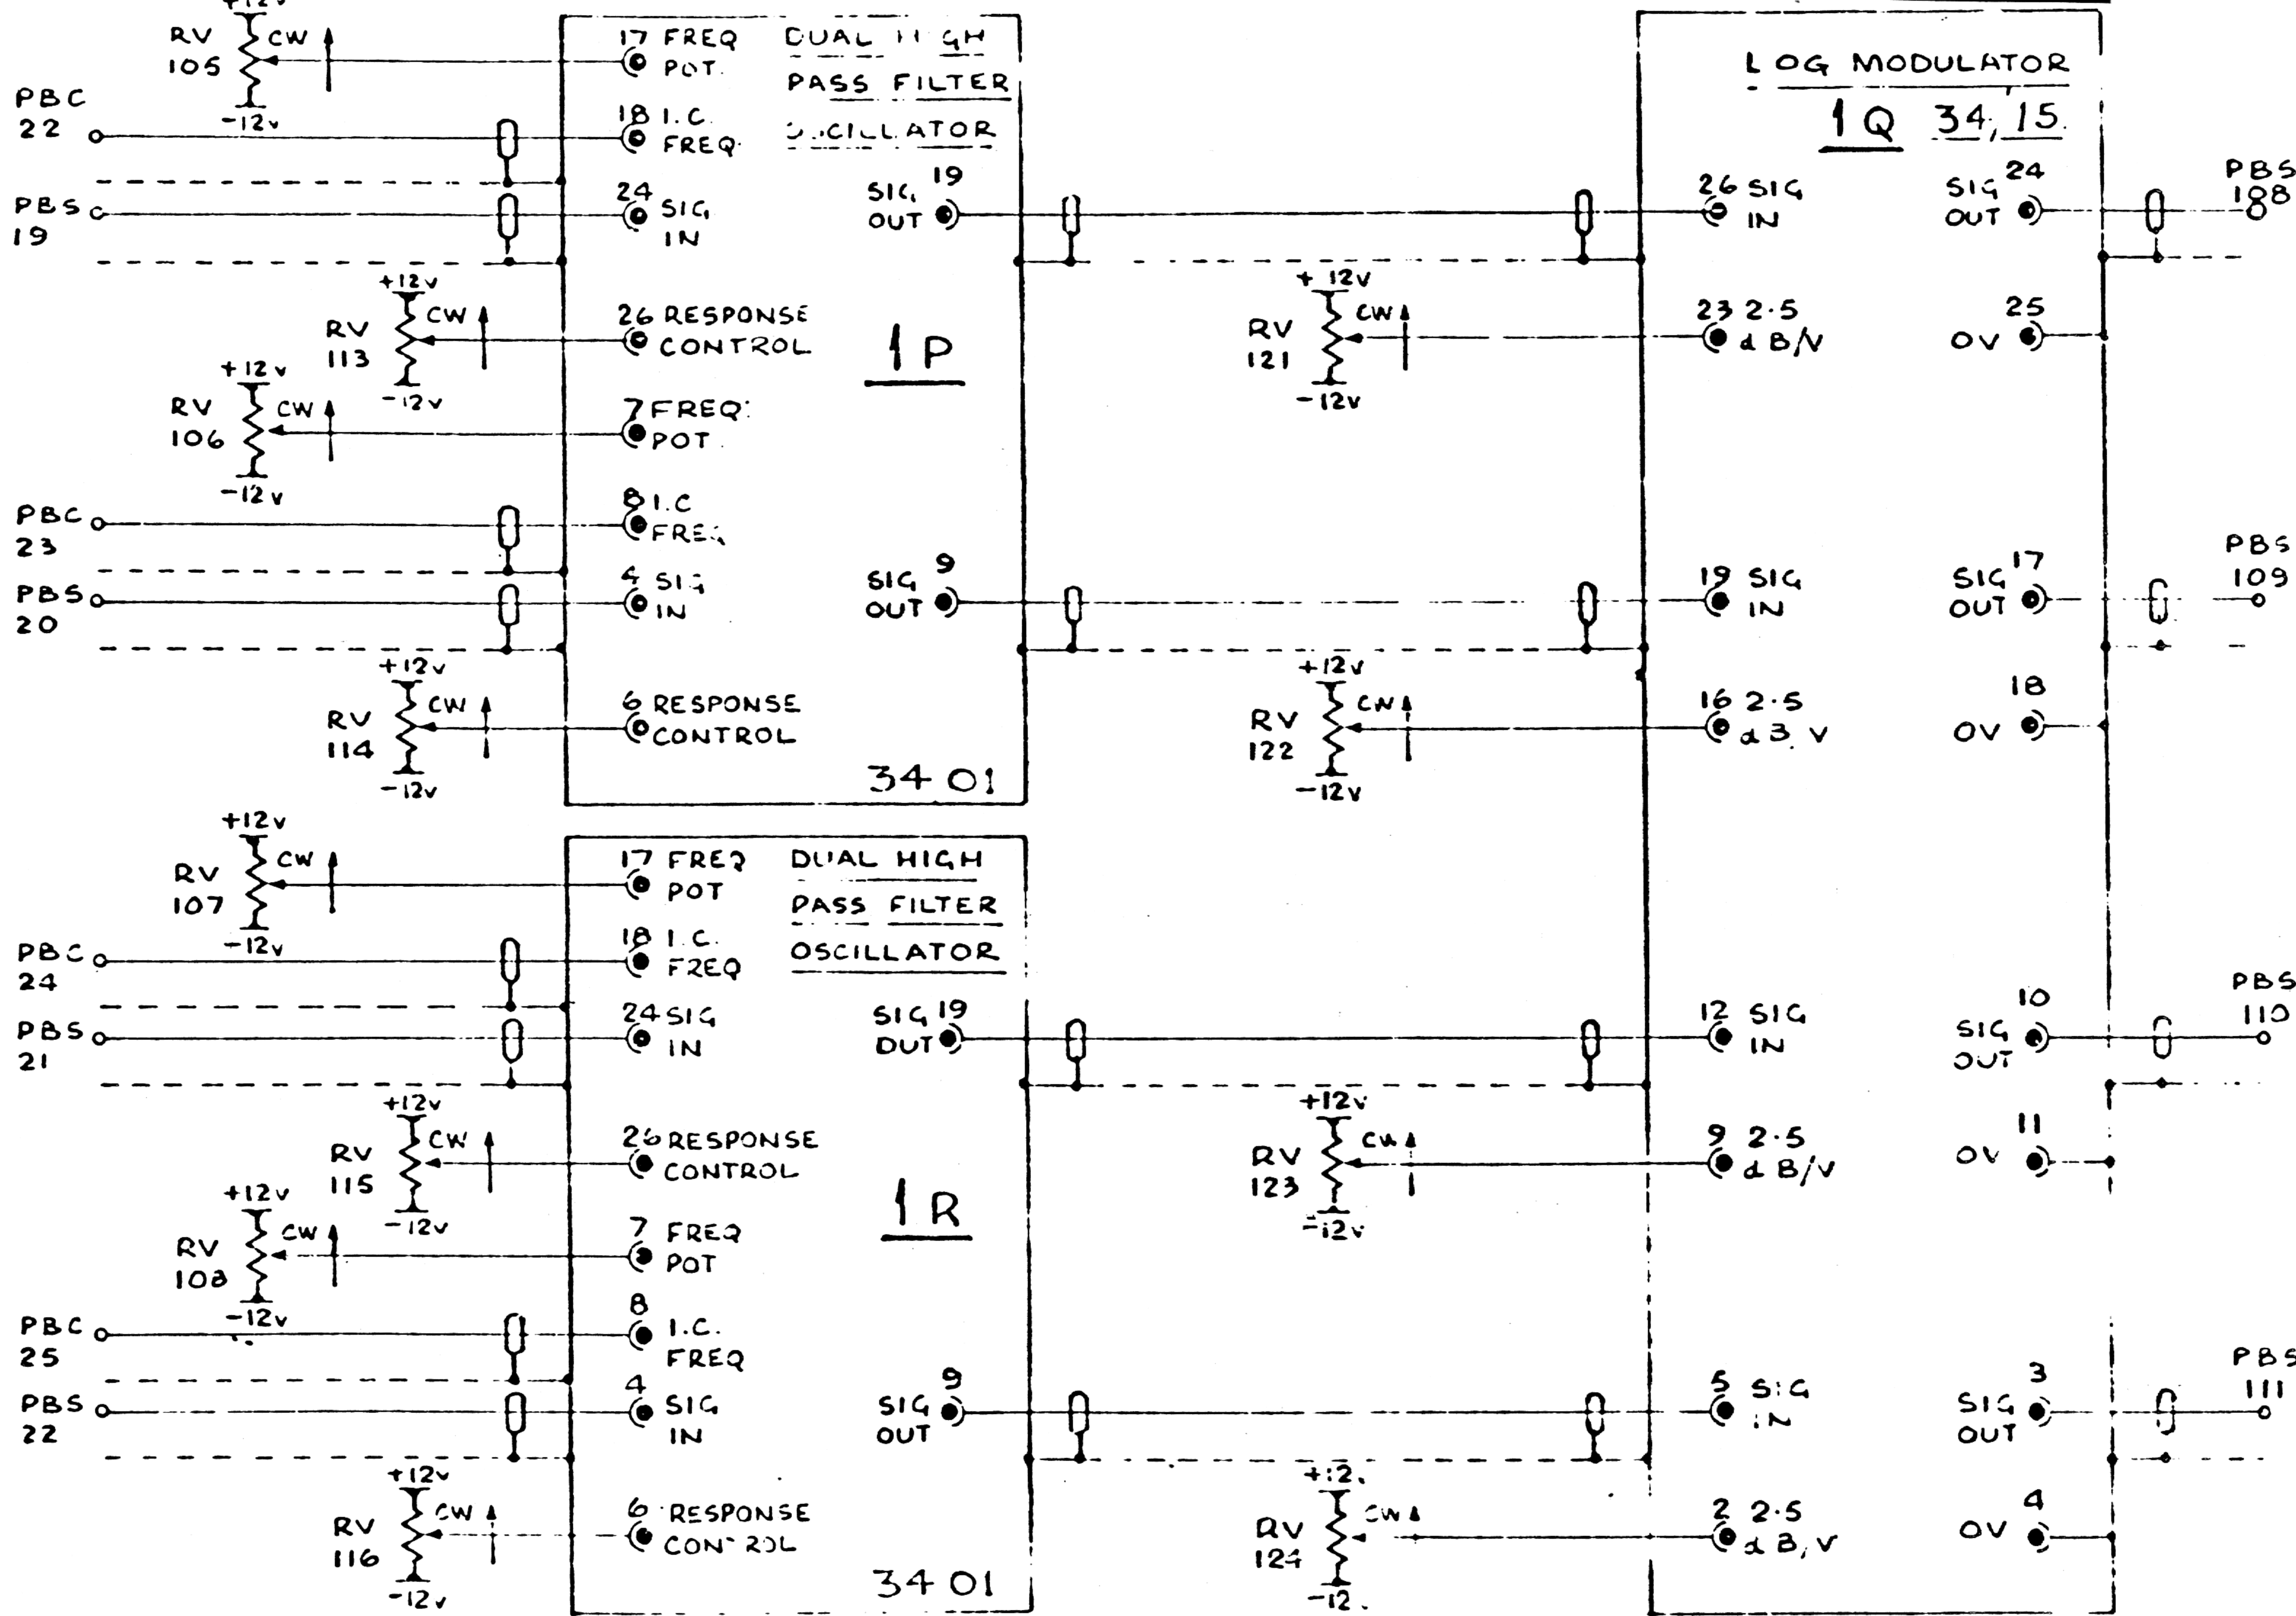


HIGH-PASS FILTER OSCILLATORS 56738

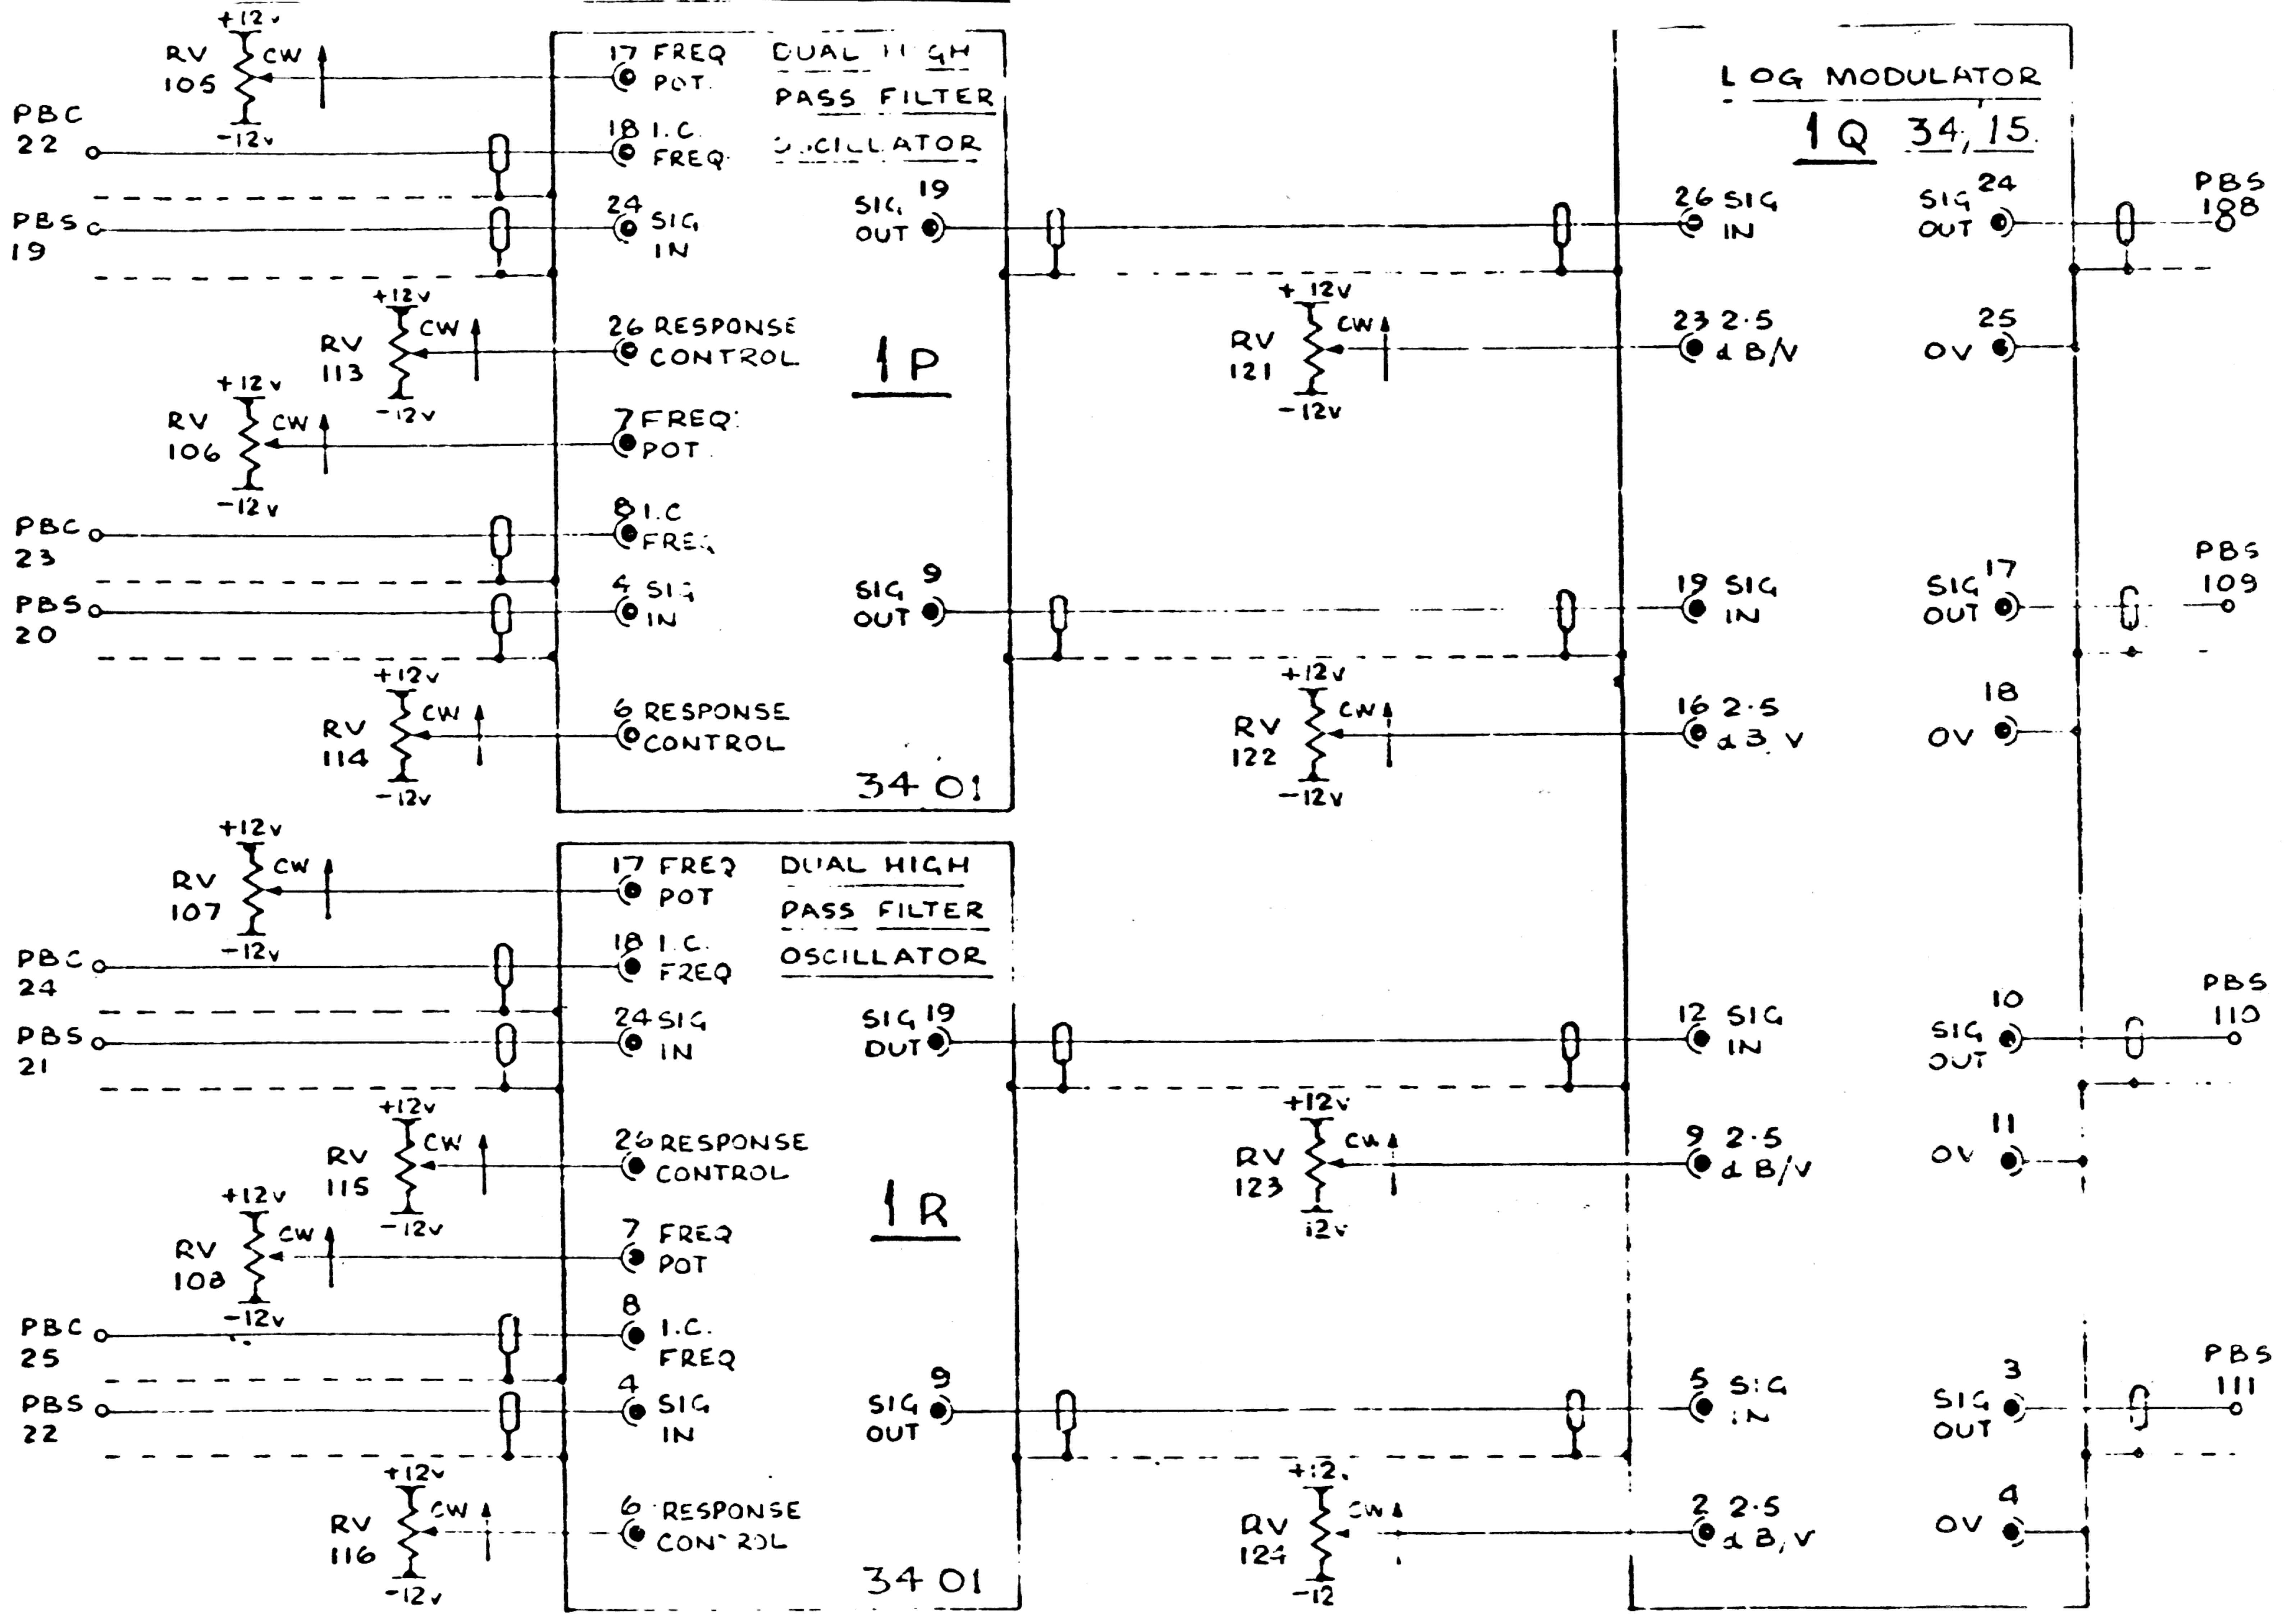


HIGH PASS FILTER OSCILLATORS 56738

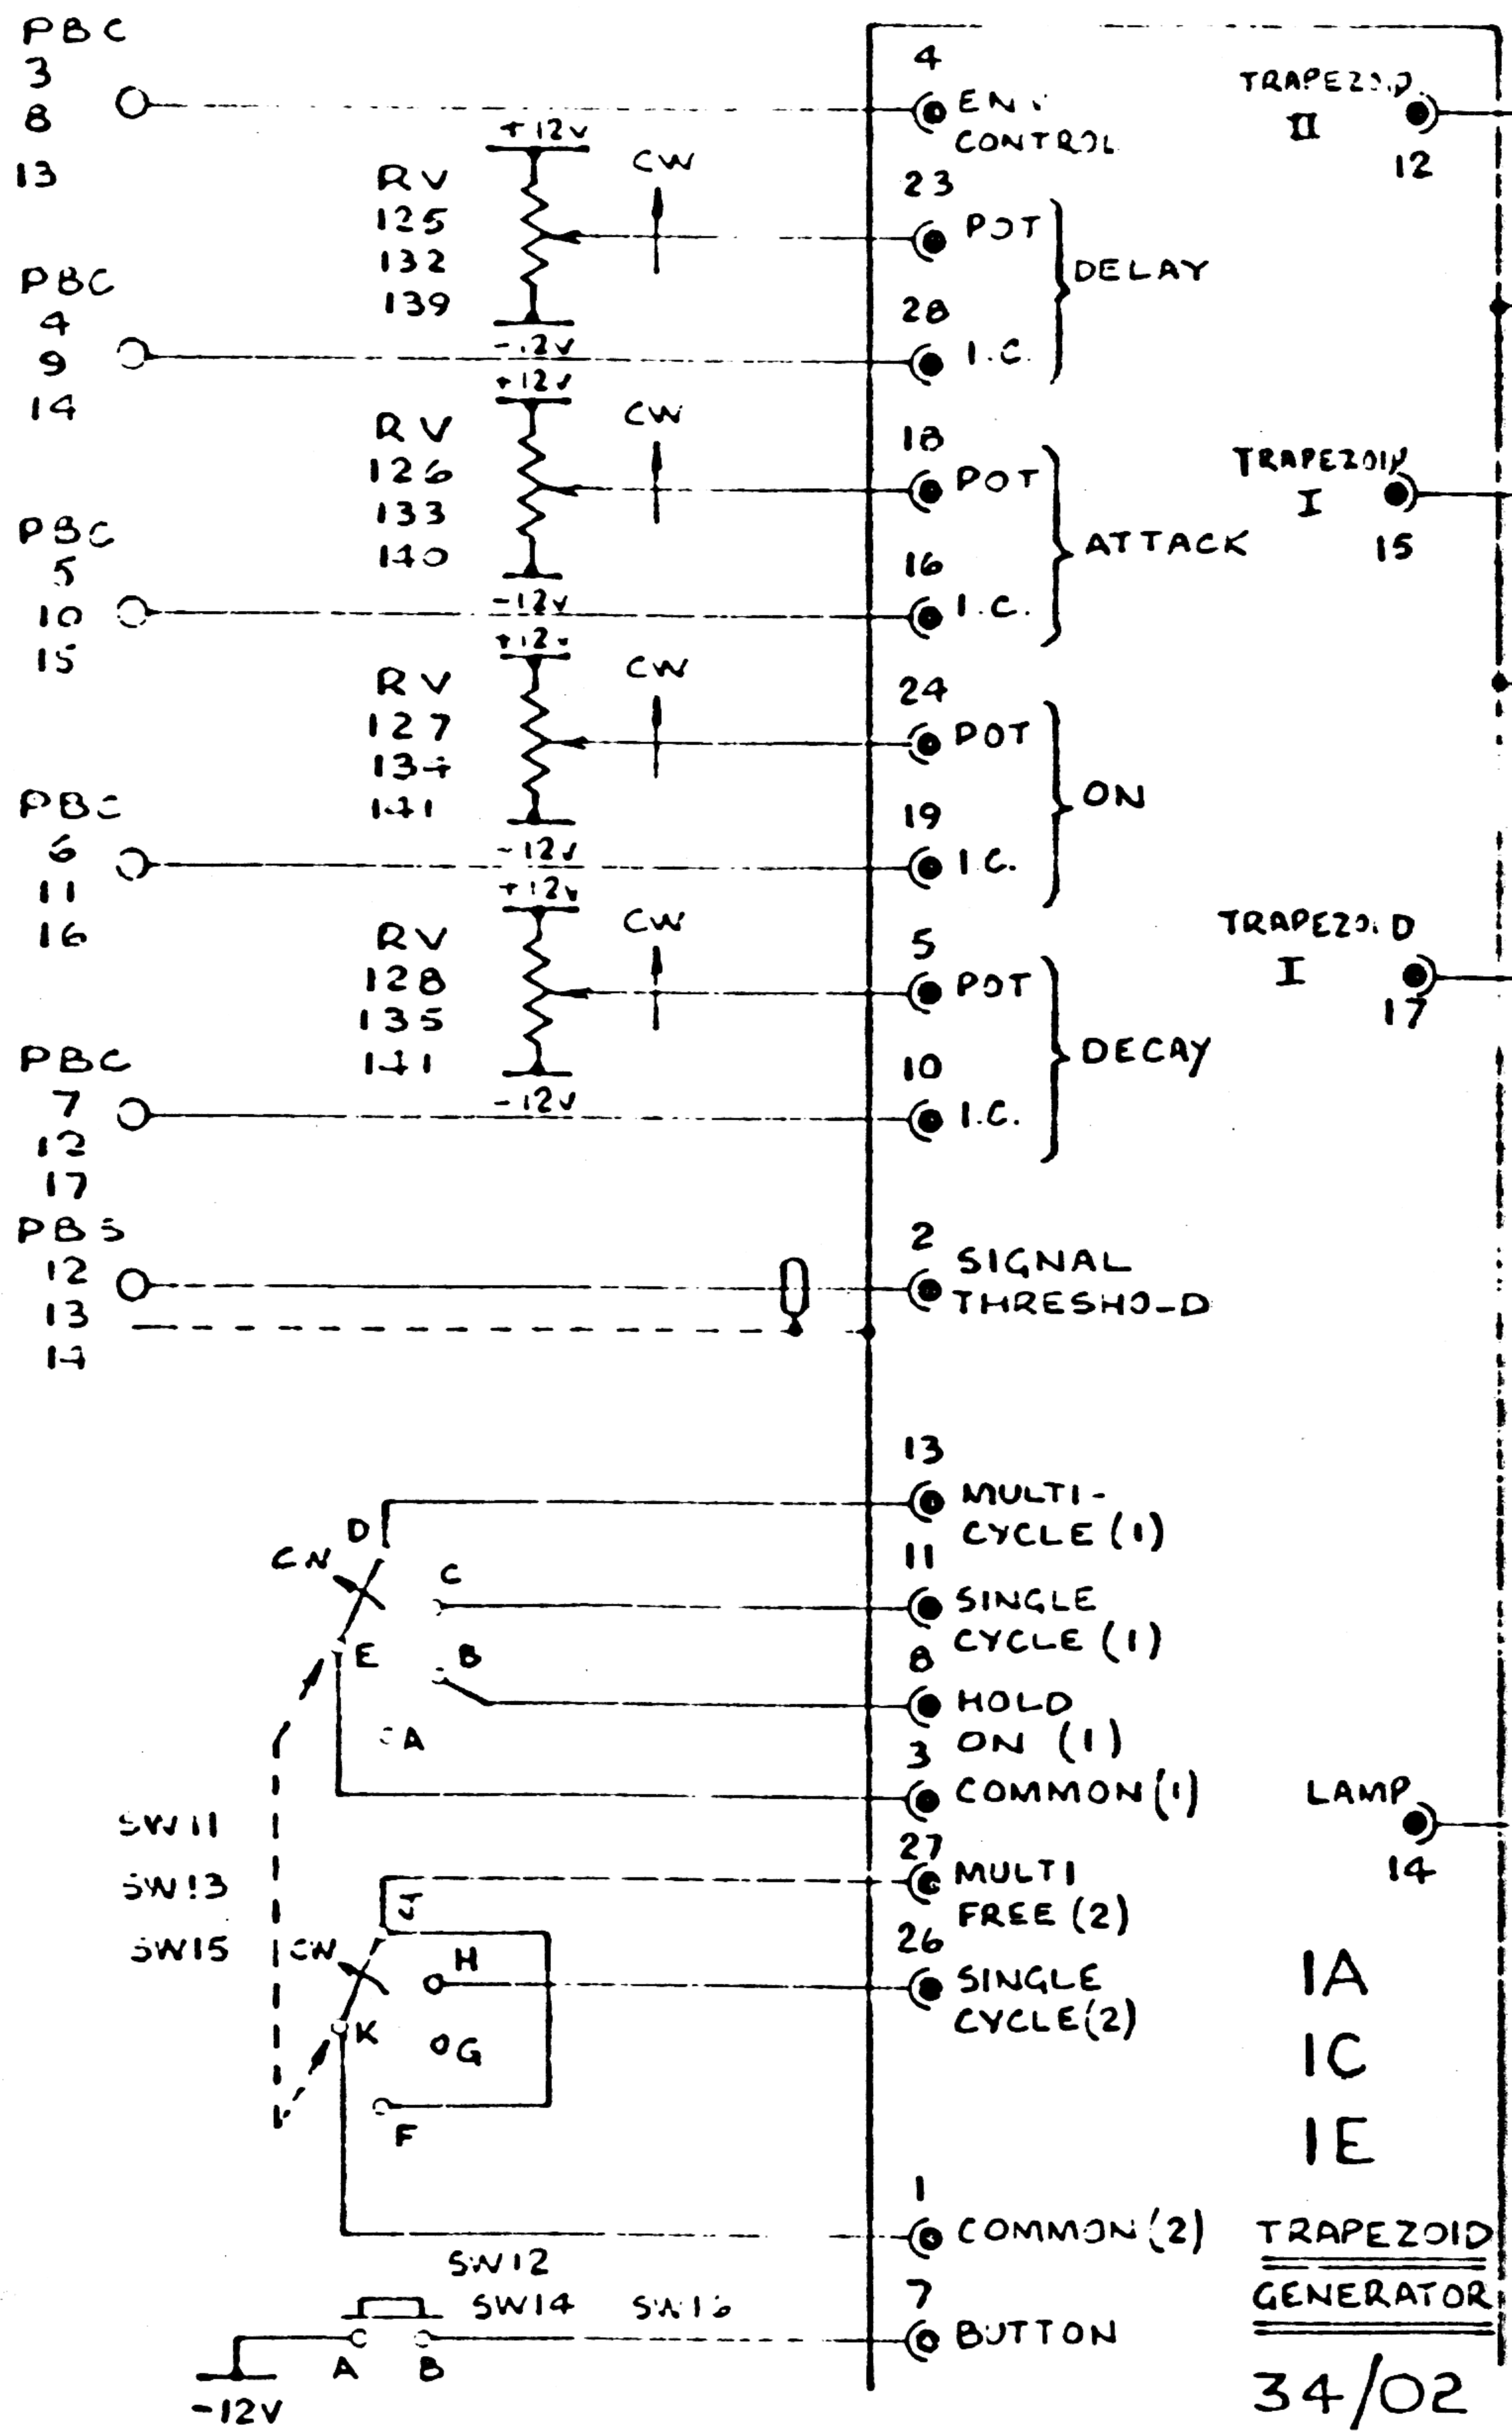

TRAPEZOID GENERATOR
34/02

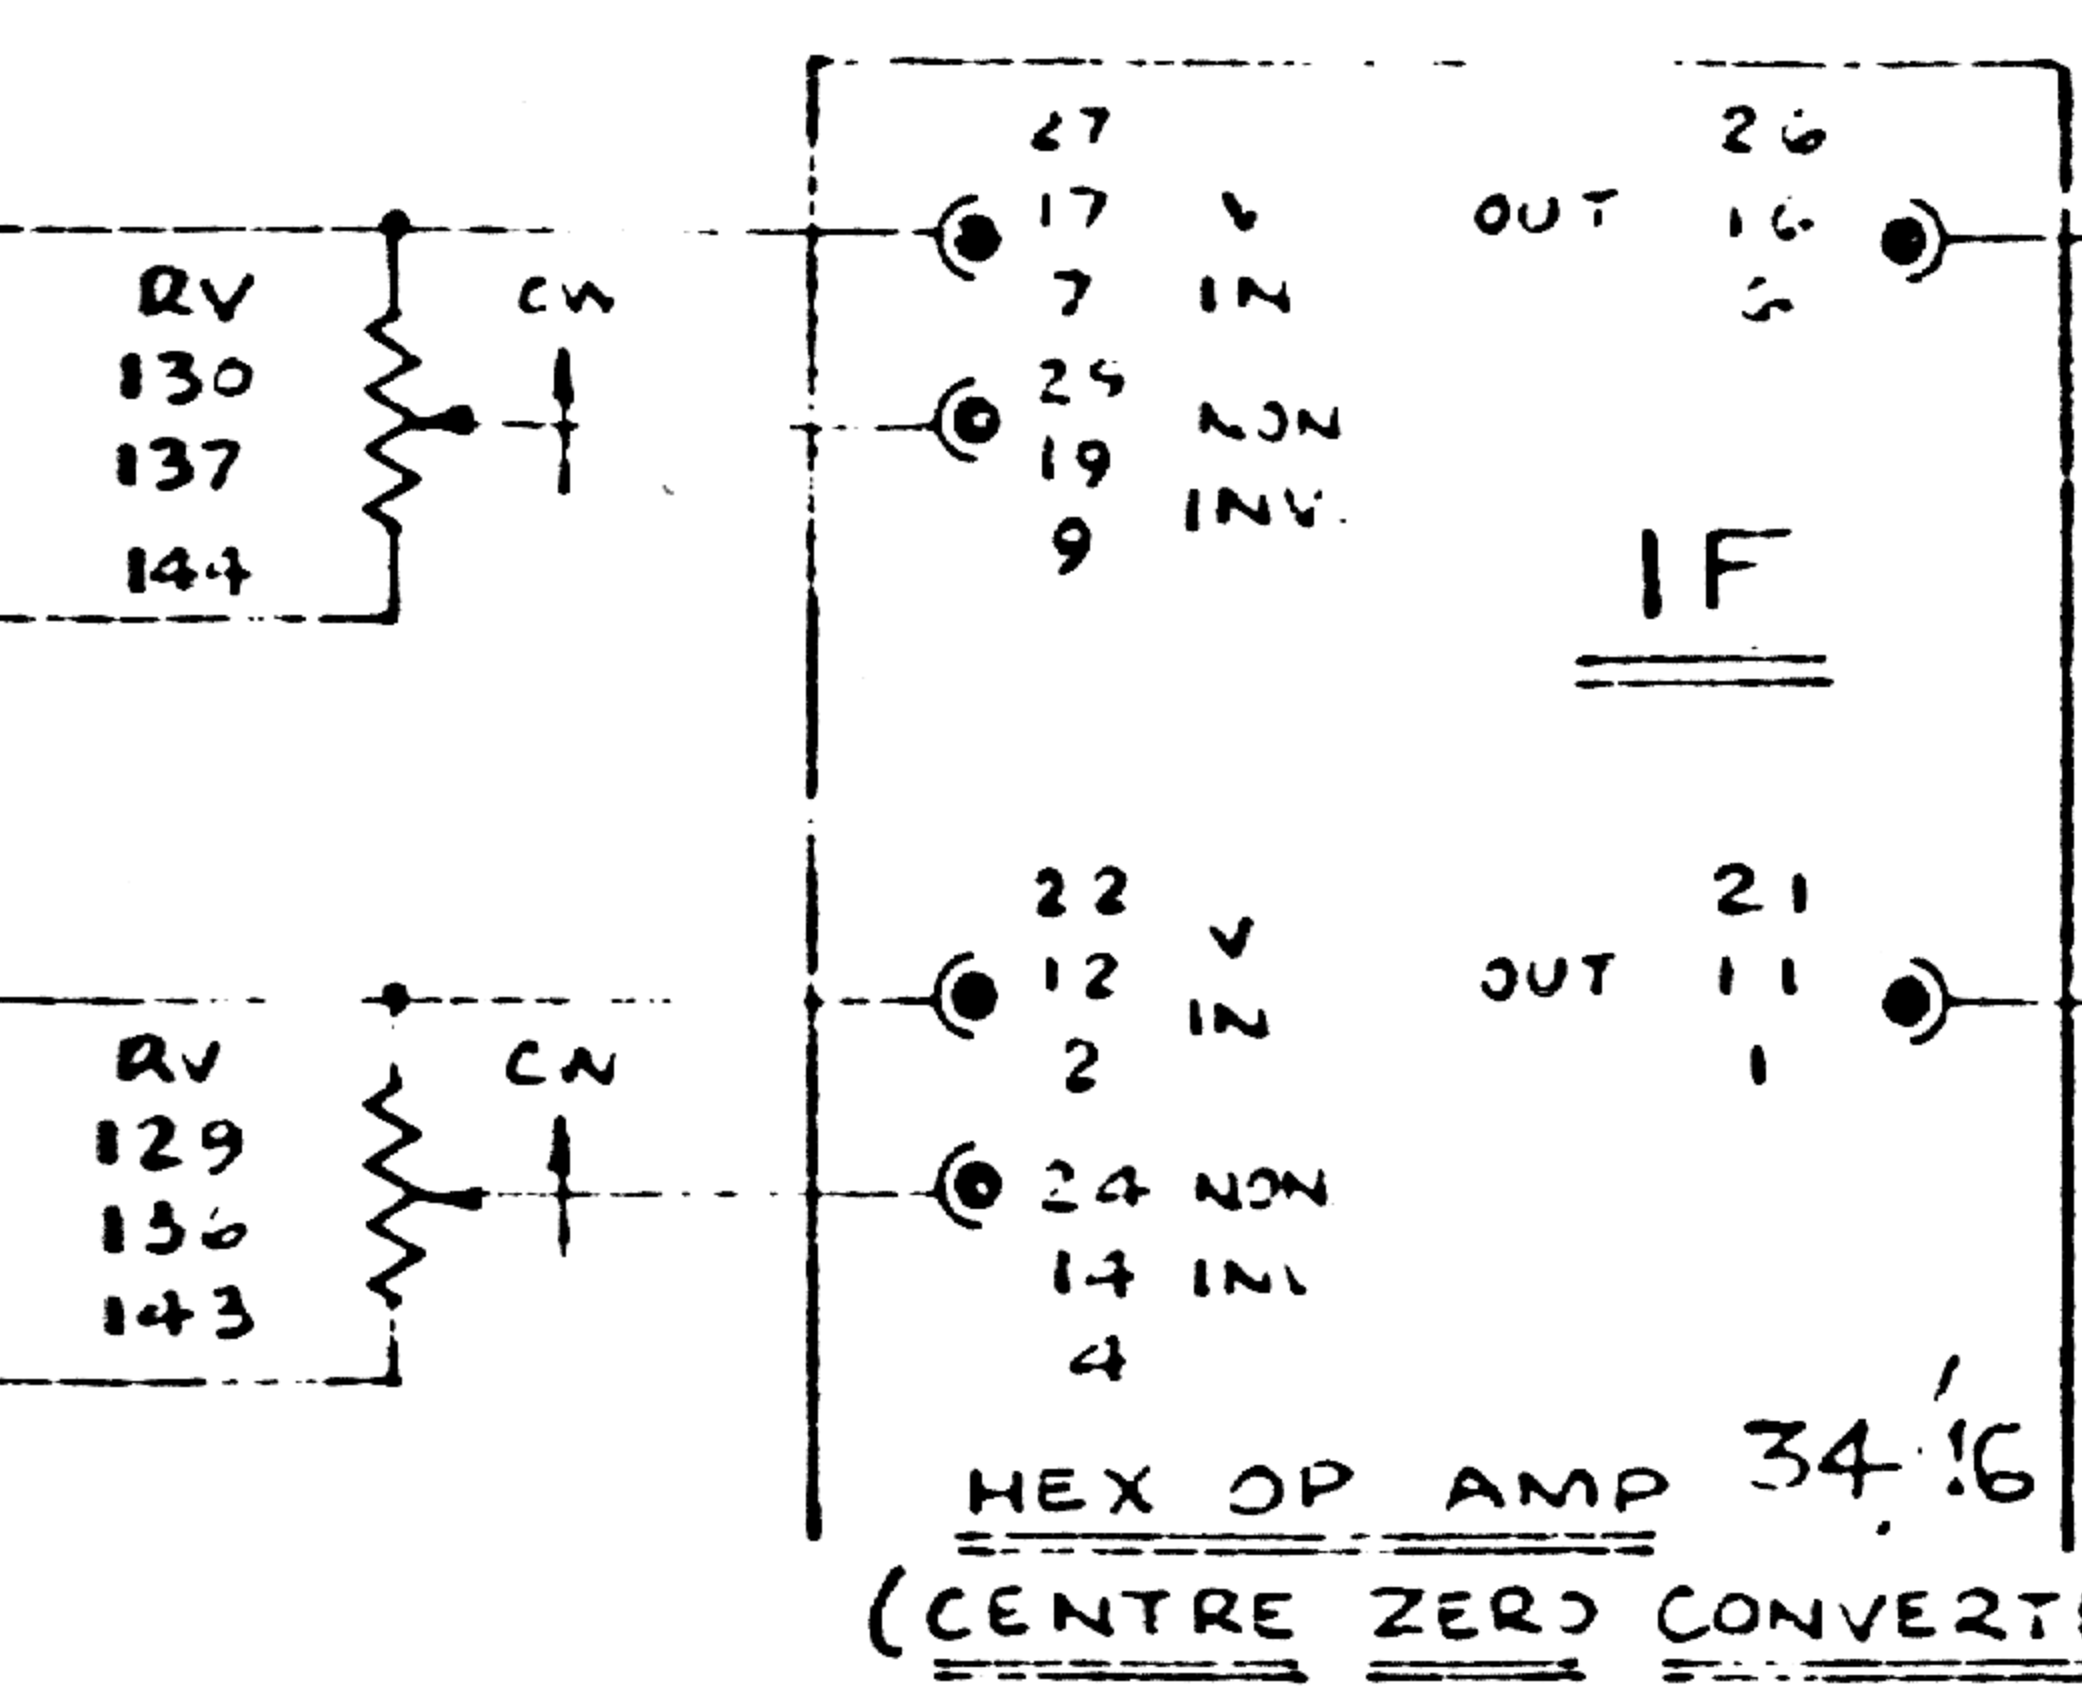

HEX OP AMP 3416
(CENTRE ZERO CONVERTER)

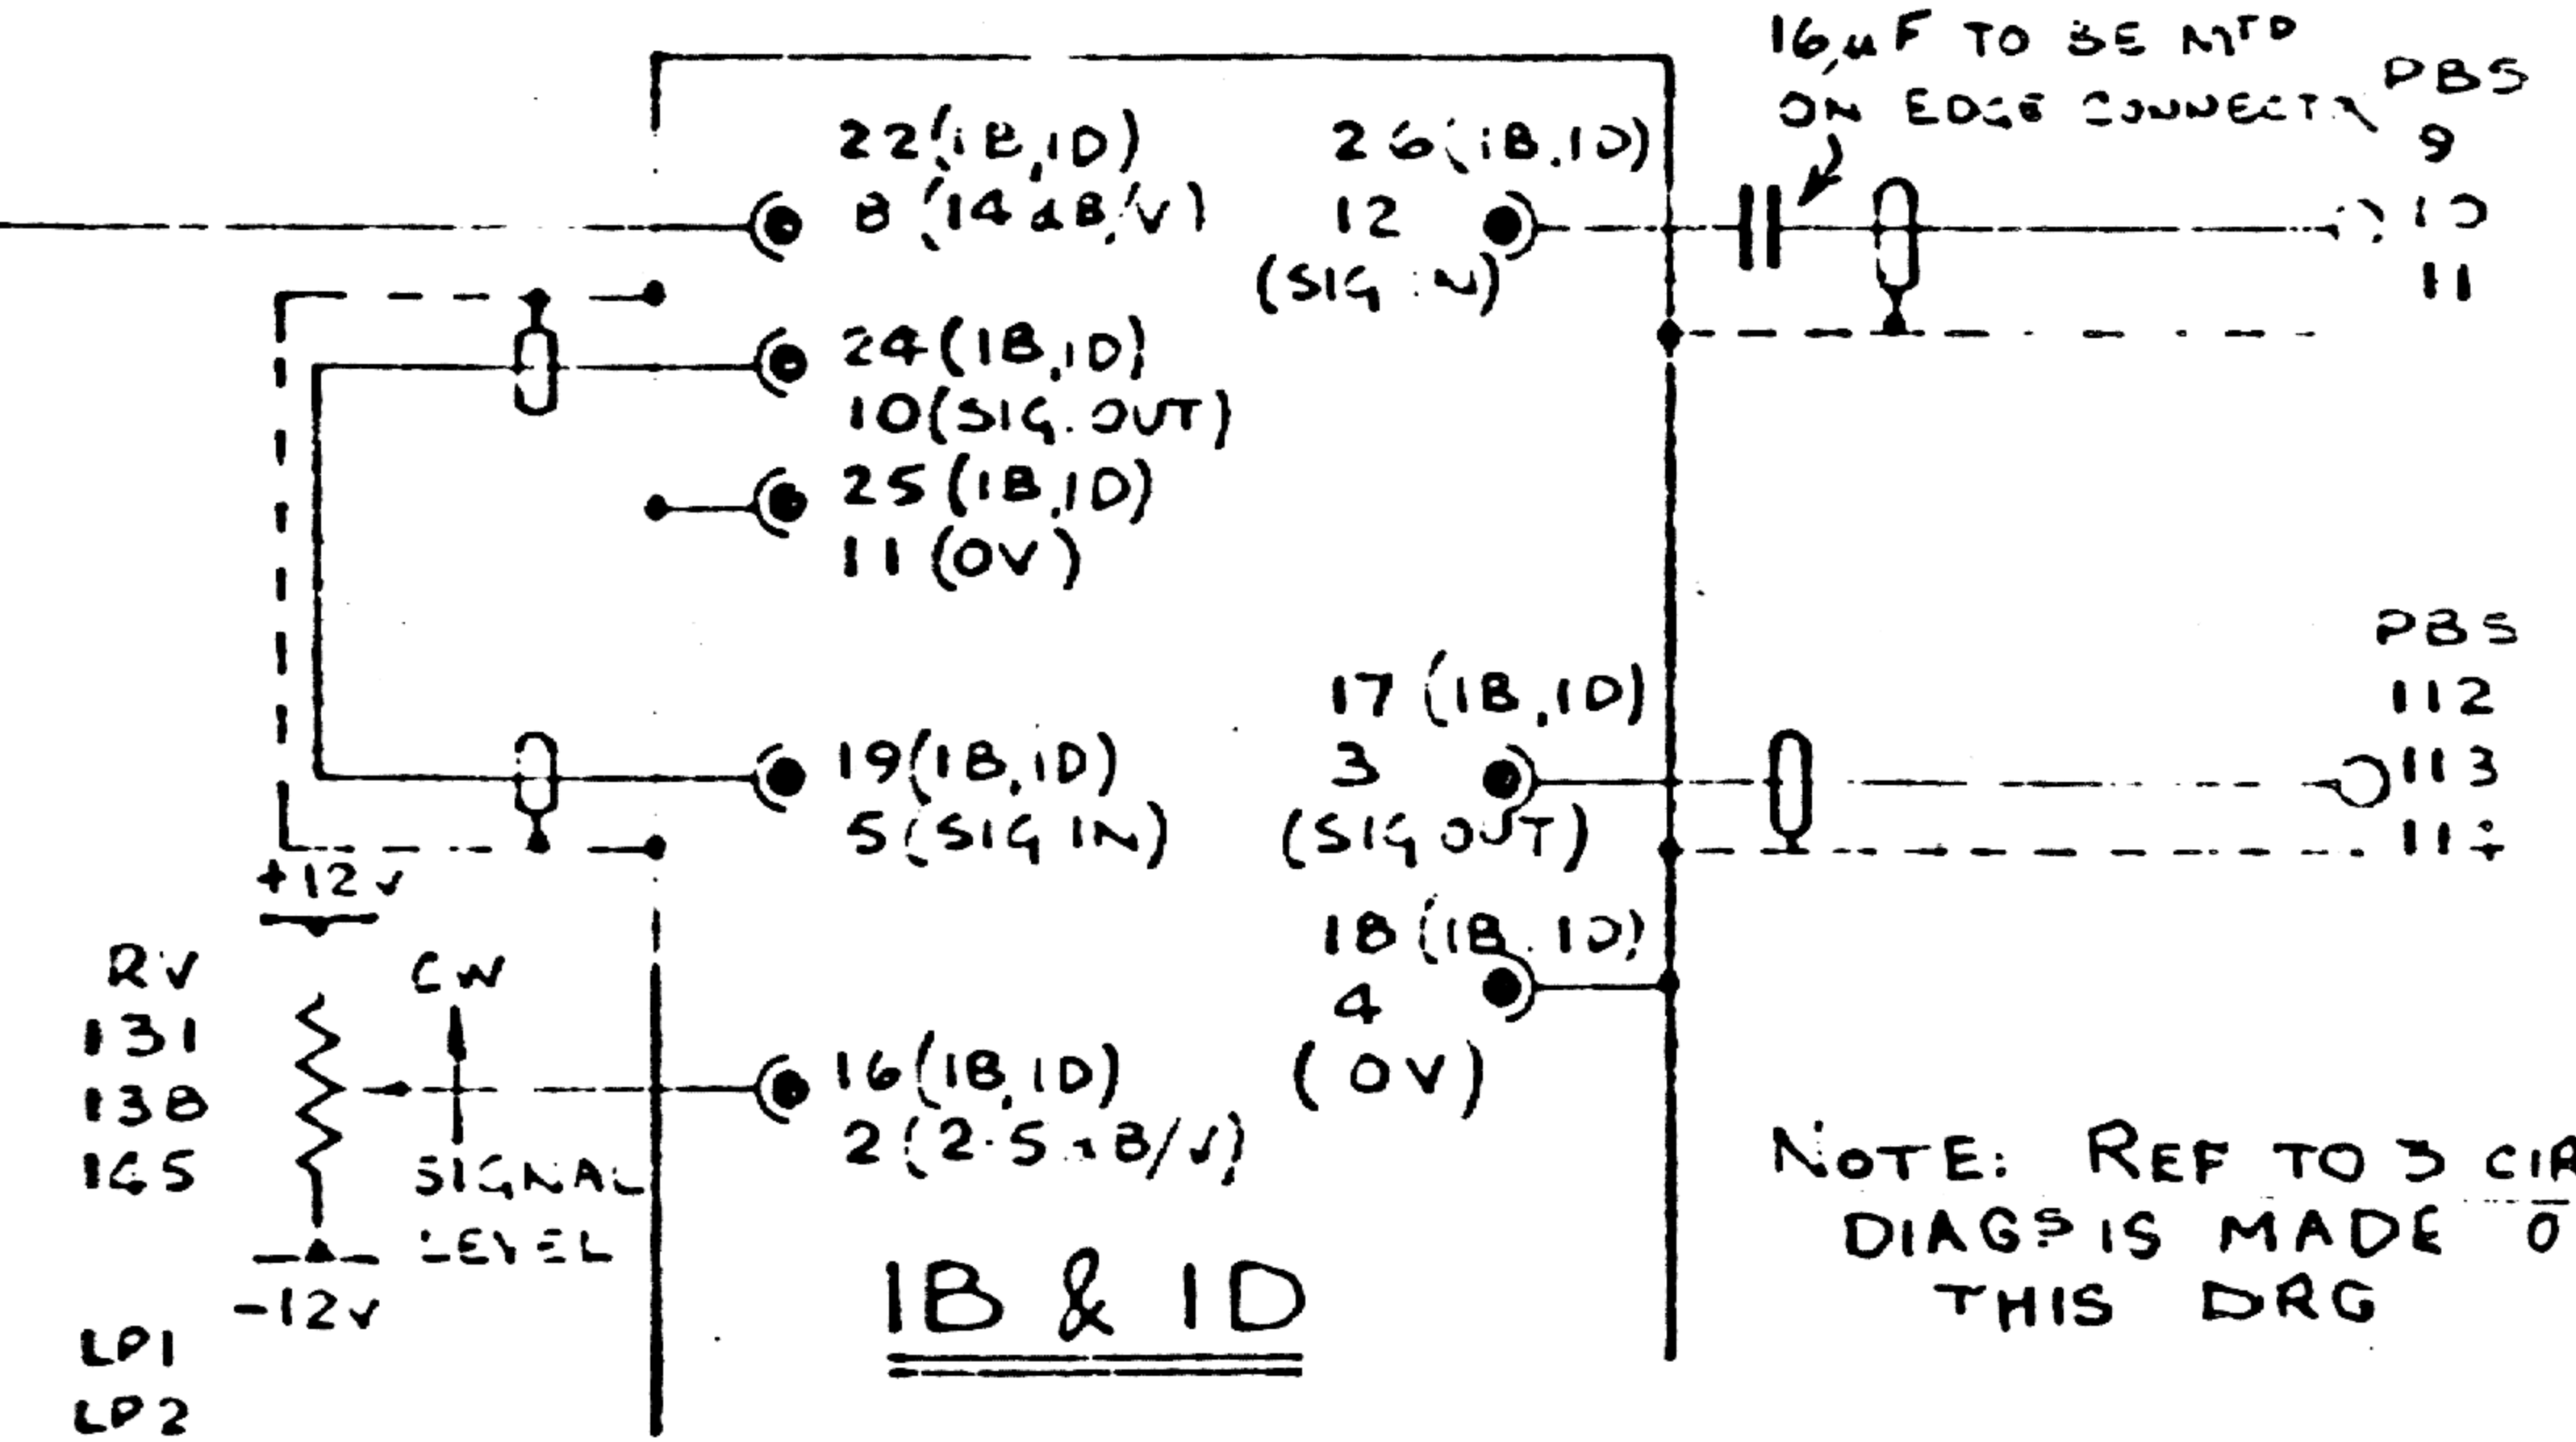


LOG MODULATOR
34/15


NOTE: REF TO 3 CIRC. DIAGS MADE ON THIS DRG

ENVELOPE SHAPER (3 IDENTICAL)

ELECTRONIC MUSIC STUDIOS (Bournemouth) Ltd		ISSUE A
ENVELOPE SHAPER		DRG NO:
USED ON SYNTHI 100.		31/08-10
TOL	FINISH	CHKD
DATE	DRG	OWN JIM

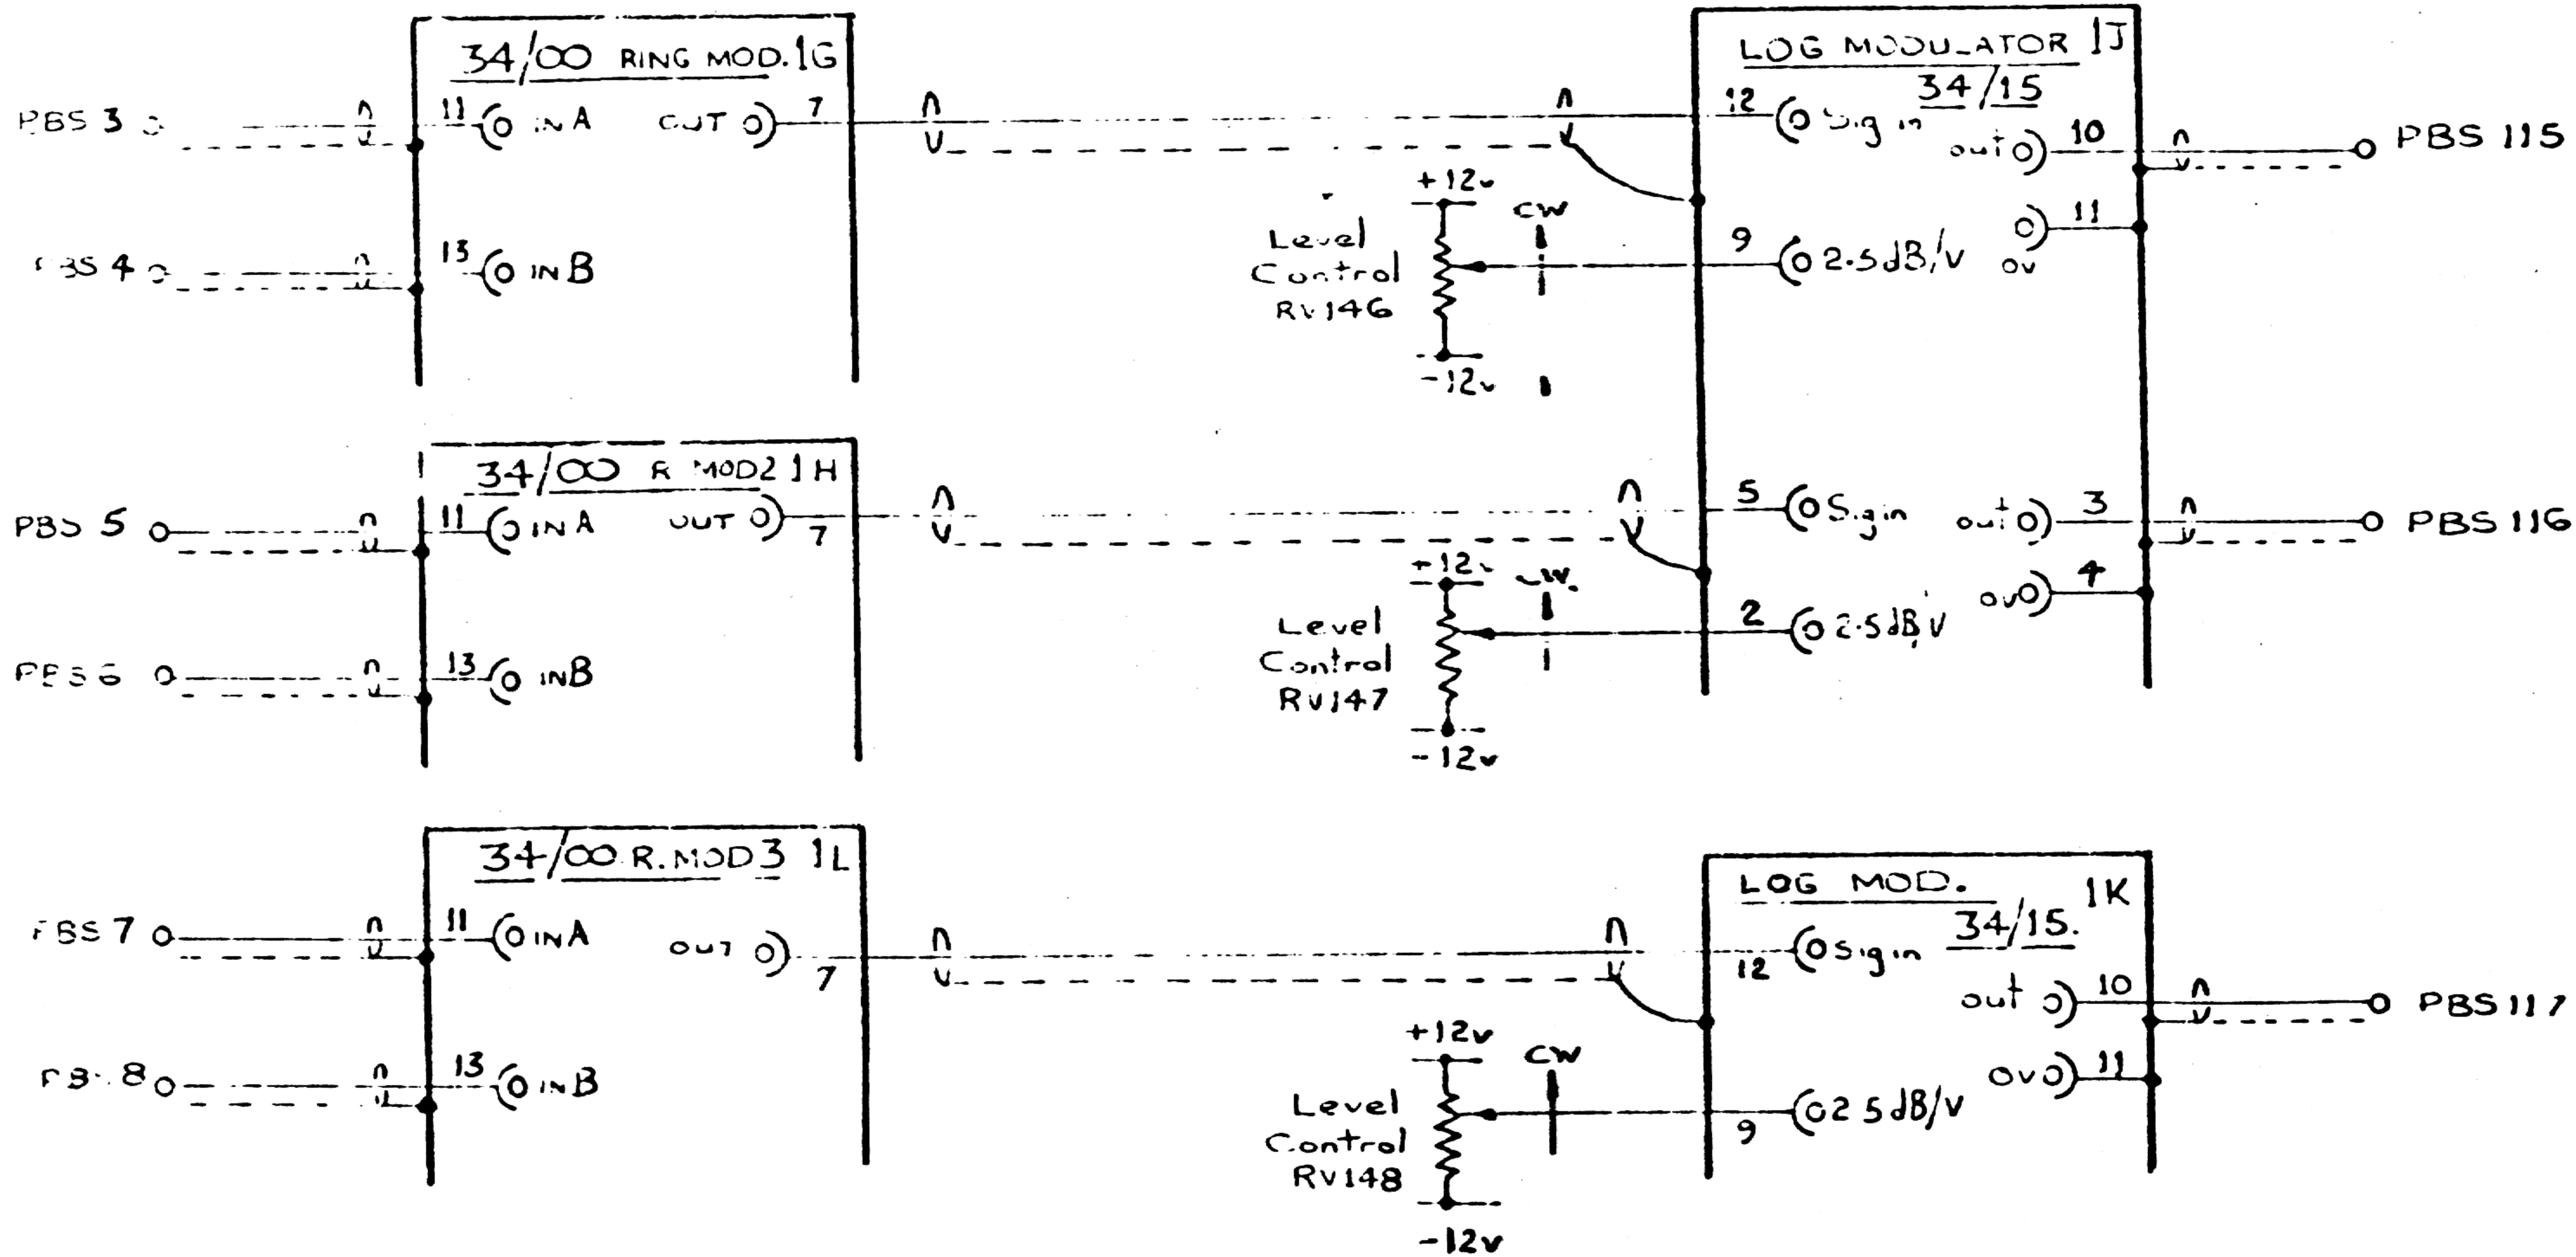


ELECTRONIC MUSIC STUDIOS (Bournemouth) Ltd		issue A
MATL	MODULE WIRING RING MOD. 1243	Drg No
FINISH		31/11
TO:	SCALE	DATE
		DATE 11/6/71

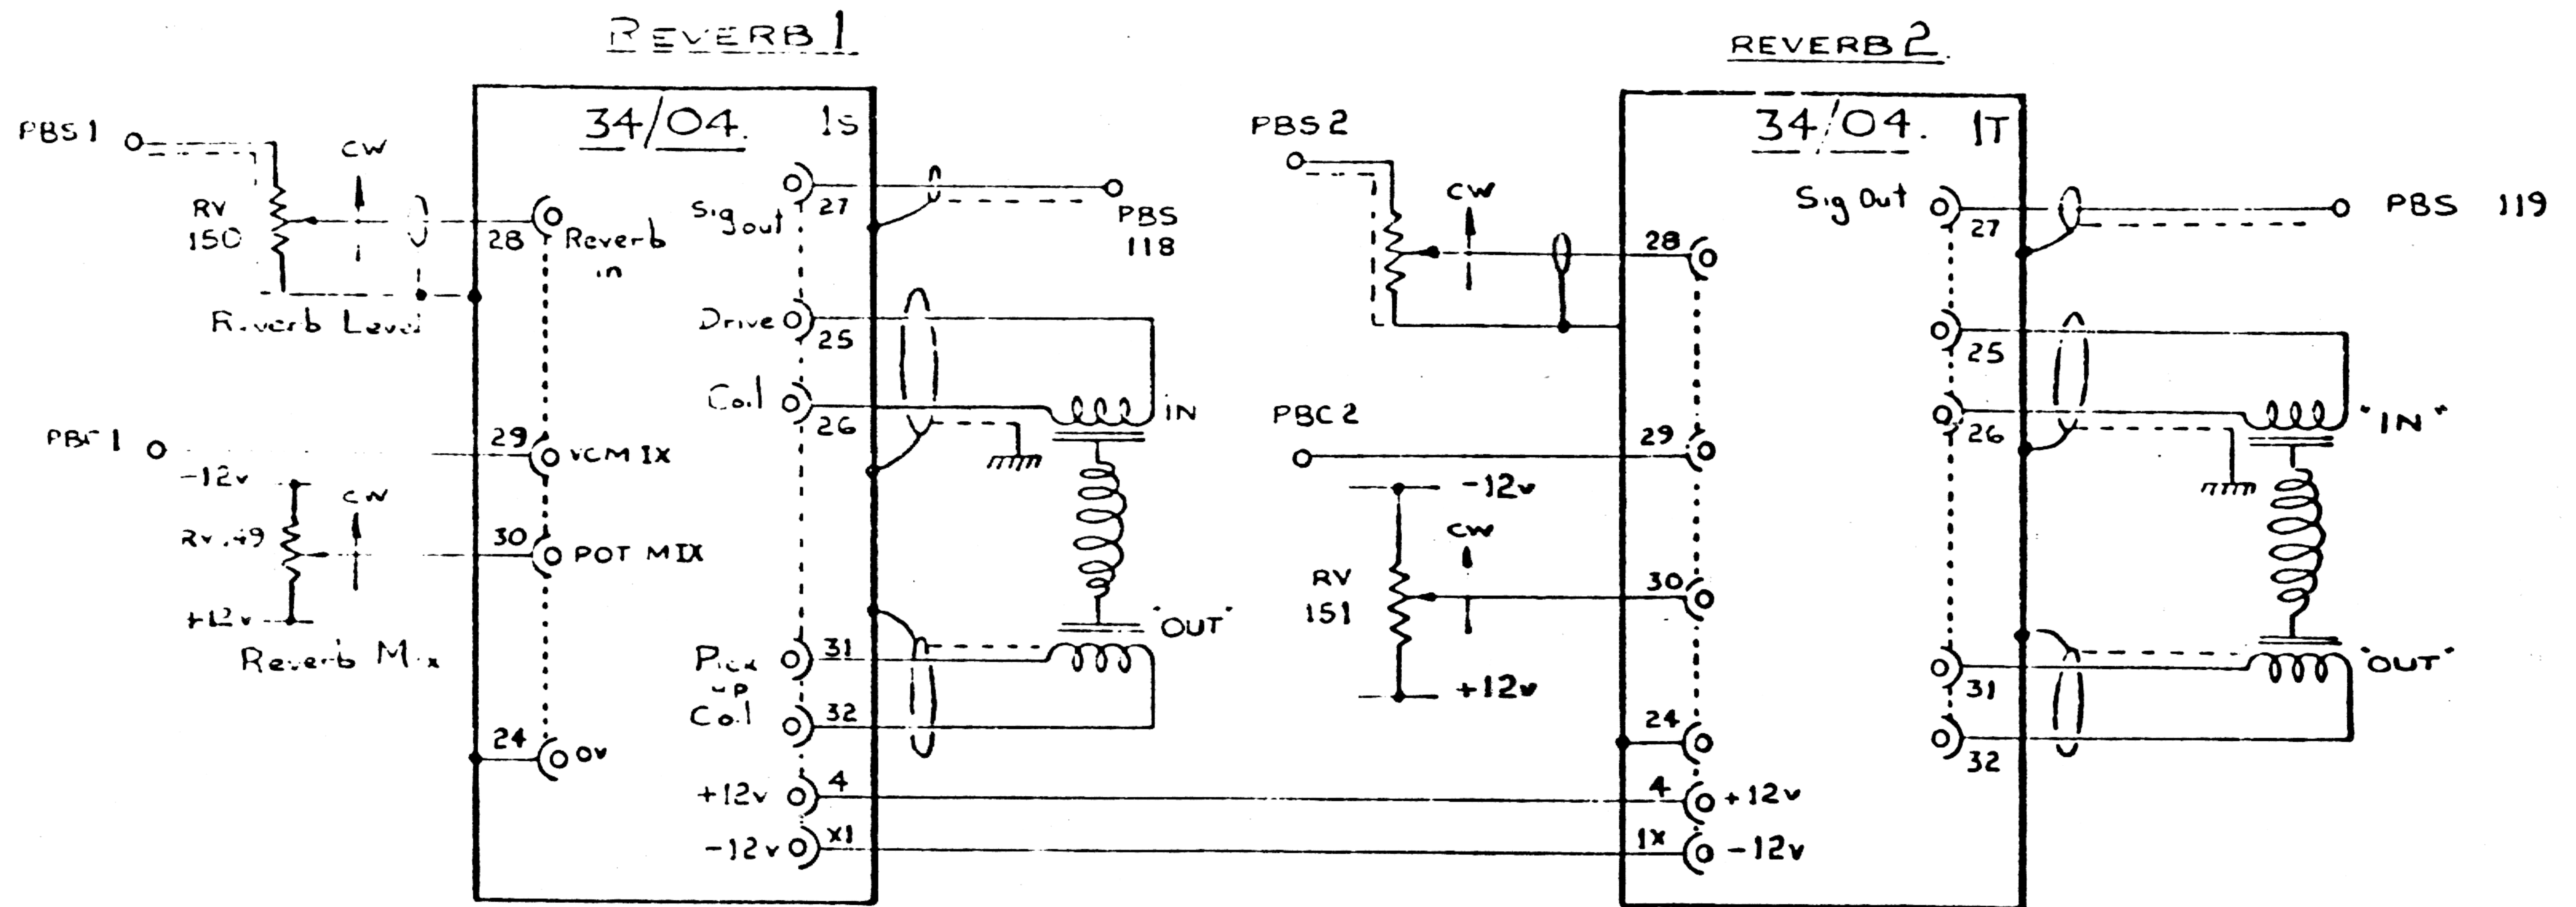


if Reverb chassis is mounted in Electrical Contact with the main chassis. Then neither Drive Coil Screen nor pickup Coil Screen must be connected to Reverb chassis. This is necessary to preserve isolation between circuit ground CV and chassis (mains earth)



ELECTRONIC MUSIC STUDIOS (Bournemouth) Ltd		issue
MATERIAL	TITLE <u>MODULE WIRING</u>	Drg NO
FINISH	<u>REVERB DRIVE 1 & 2</u>	<u>31/12</u>
NO.	USED ON <u>SYNTHI 100</u>	DATE
SCALE	DATE	DATE

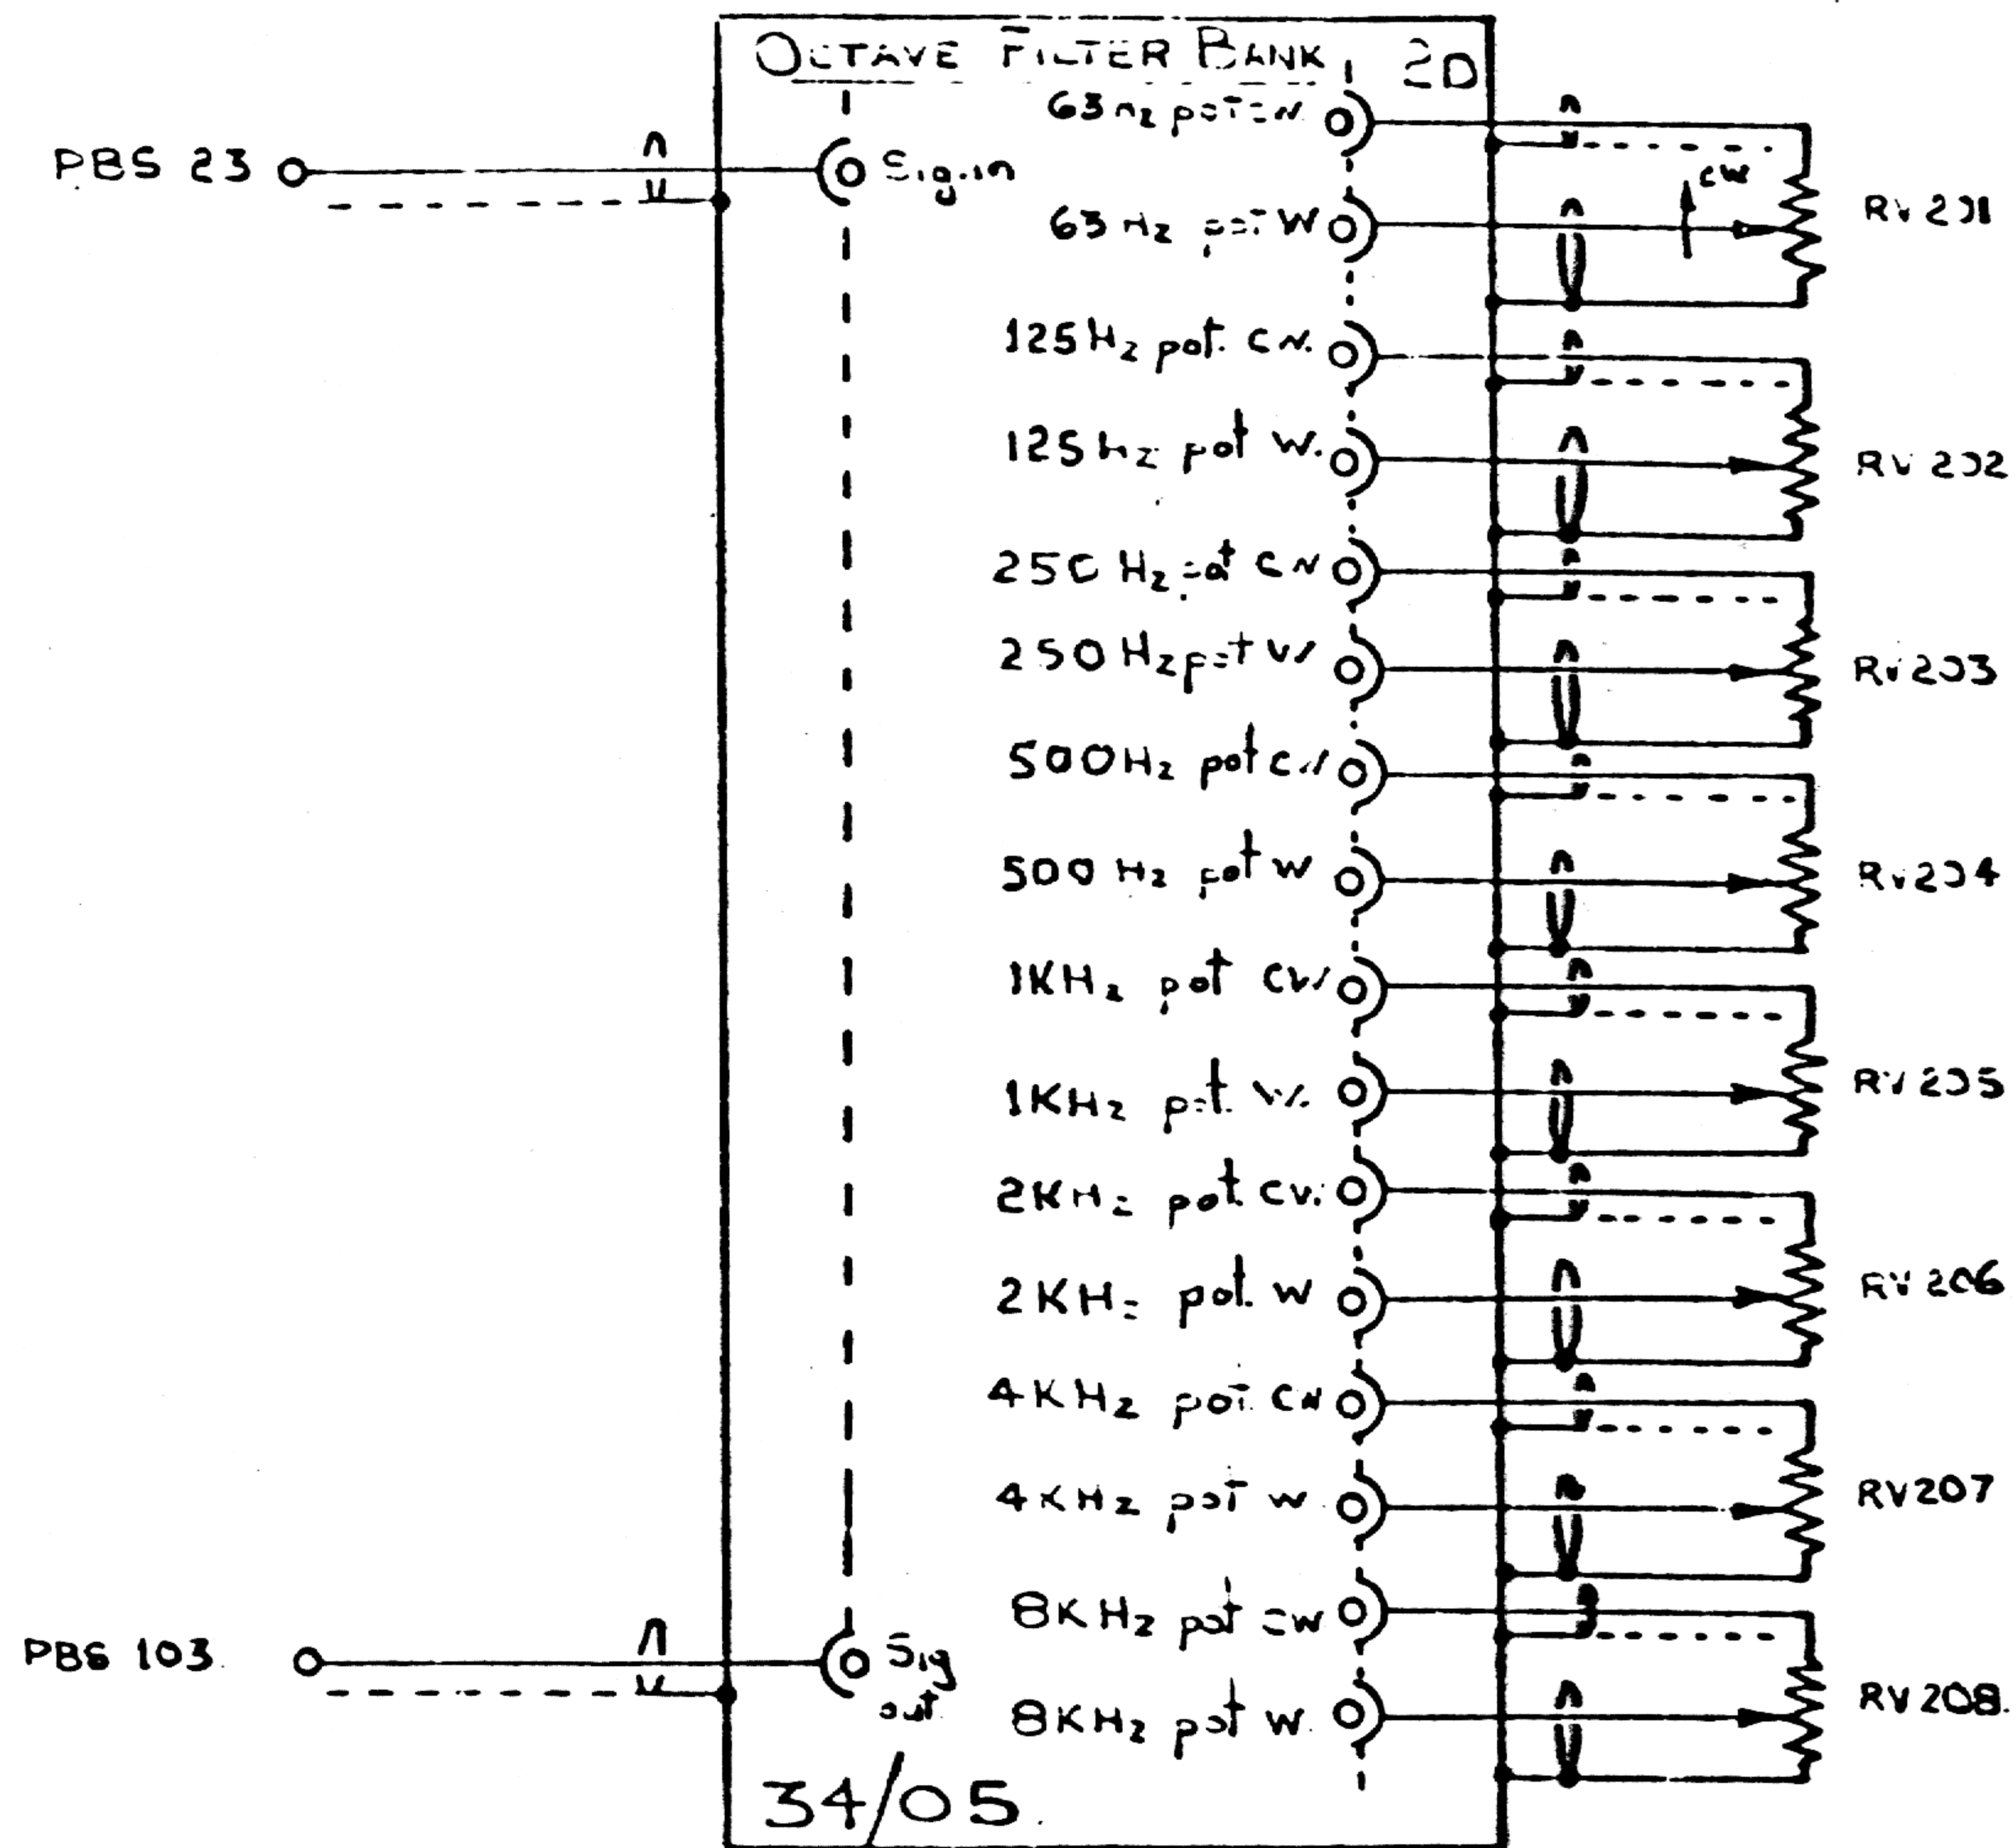

ELECTRONIC MUSIC STUDIOS (Bournemouth) Ltd			issue A
MATL	TITLE <u>MODULE WIRING OCTAVE</u> <u>FILTER BANK</u>	Drg No	
FINISH		31/13	
TOL	SCALE	DATE	DATE 16 6 71

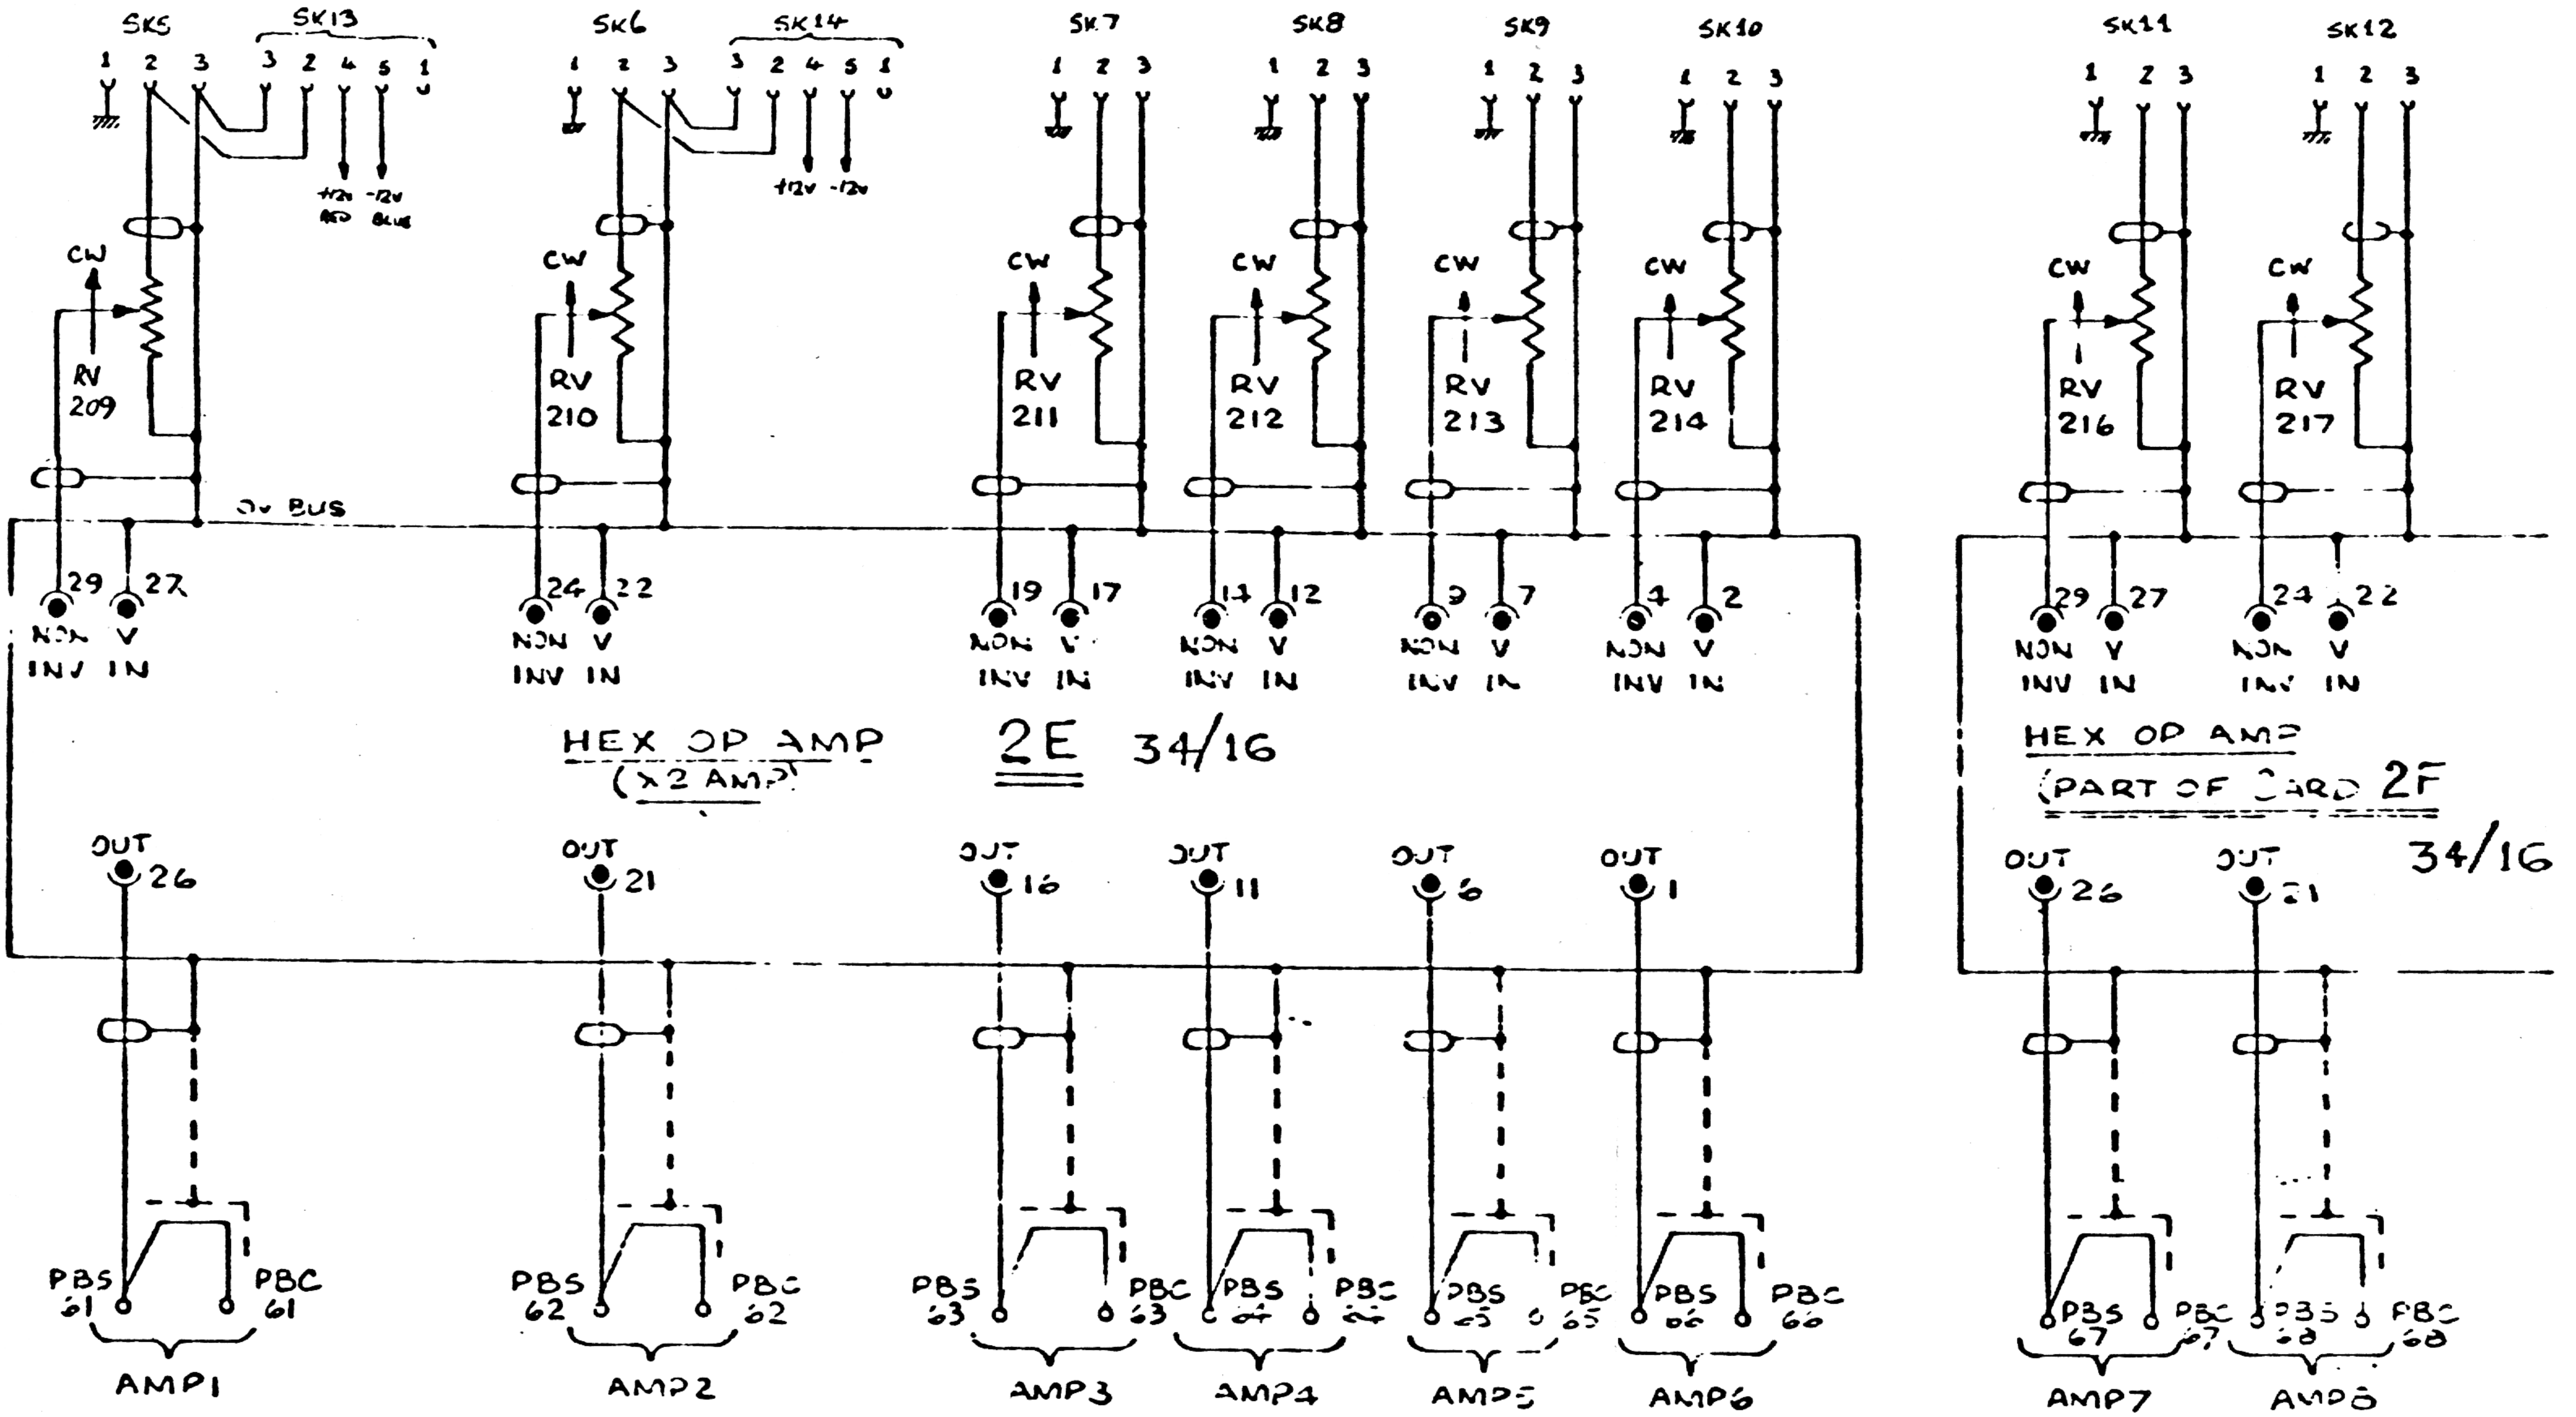


ELECTRONIC MUSIC STUDIOS (Bournemouth) Ltd. Issue		
DATE	INPUT AMPLIFIERS	Draw No.
TIME	U.S. SYNTH. 100	31/14

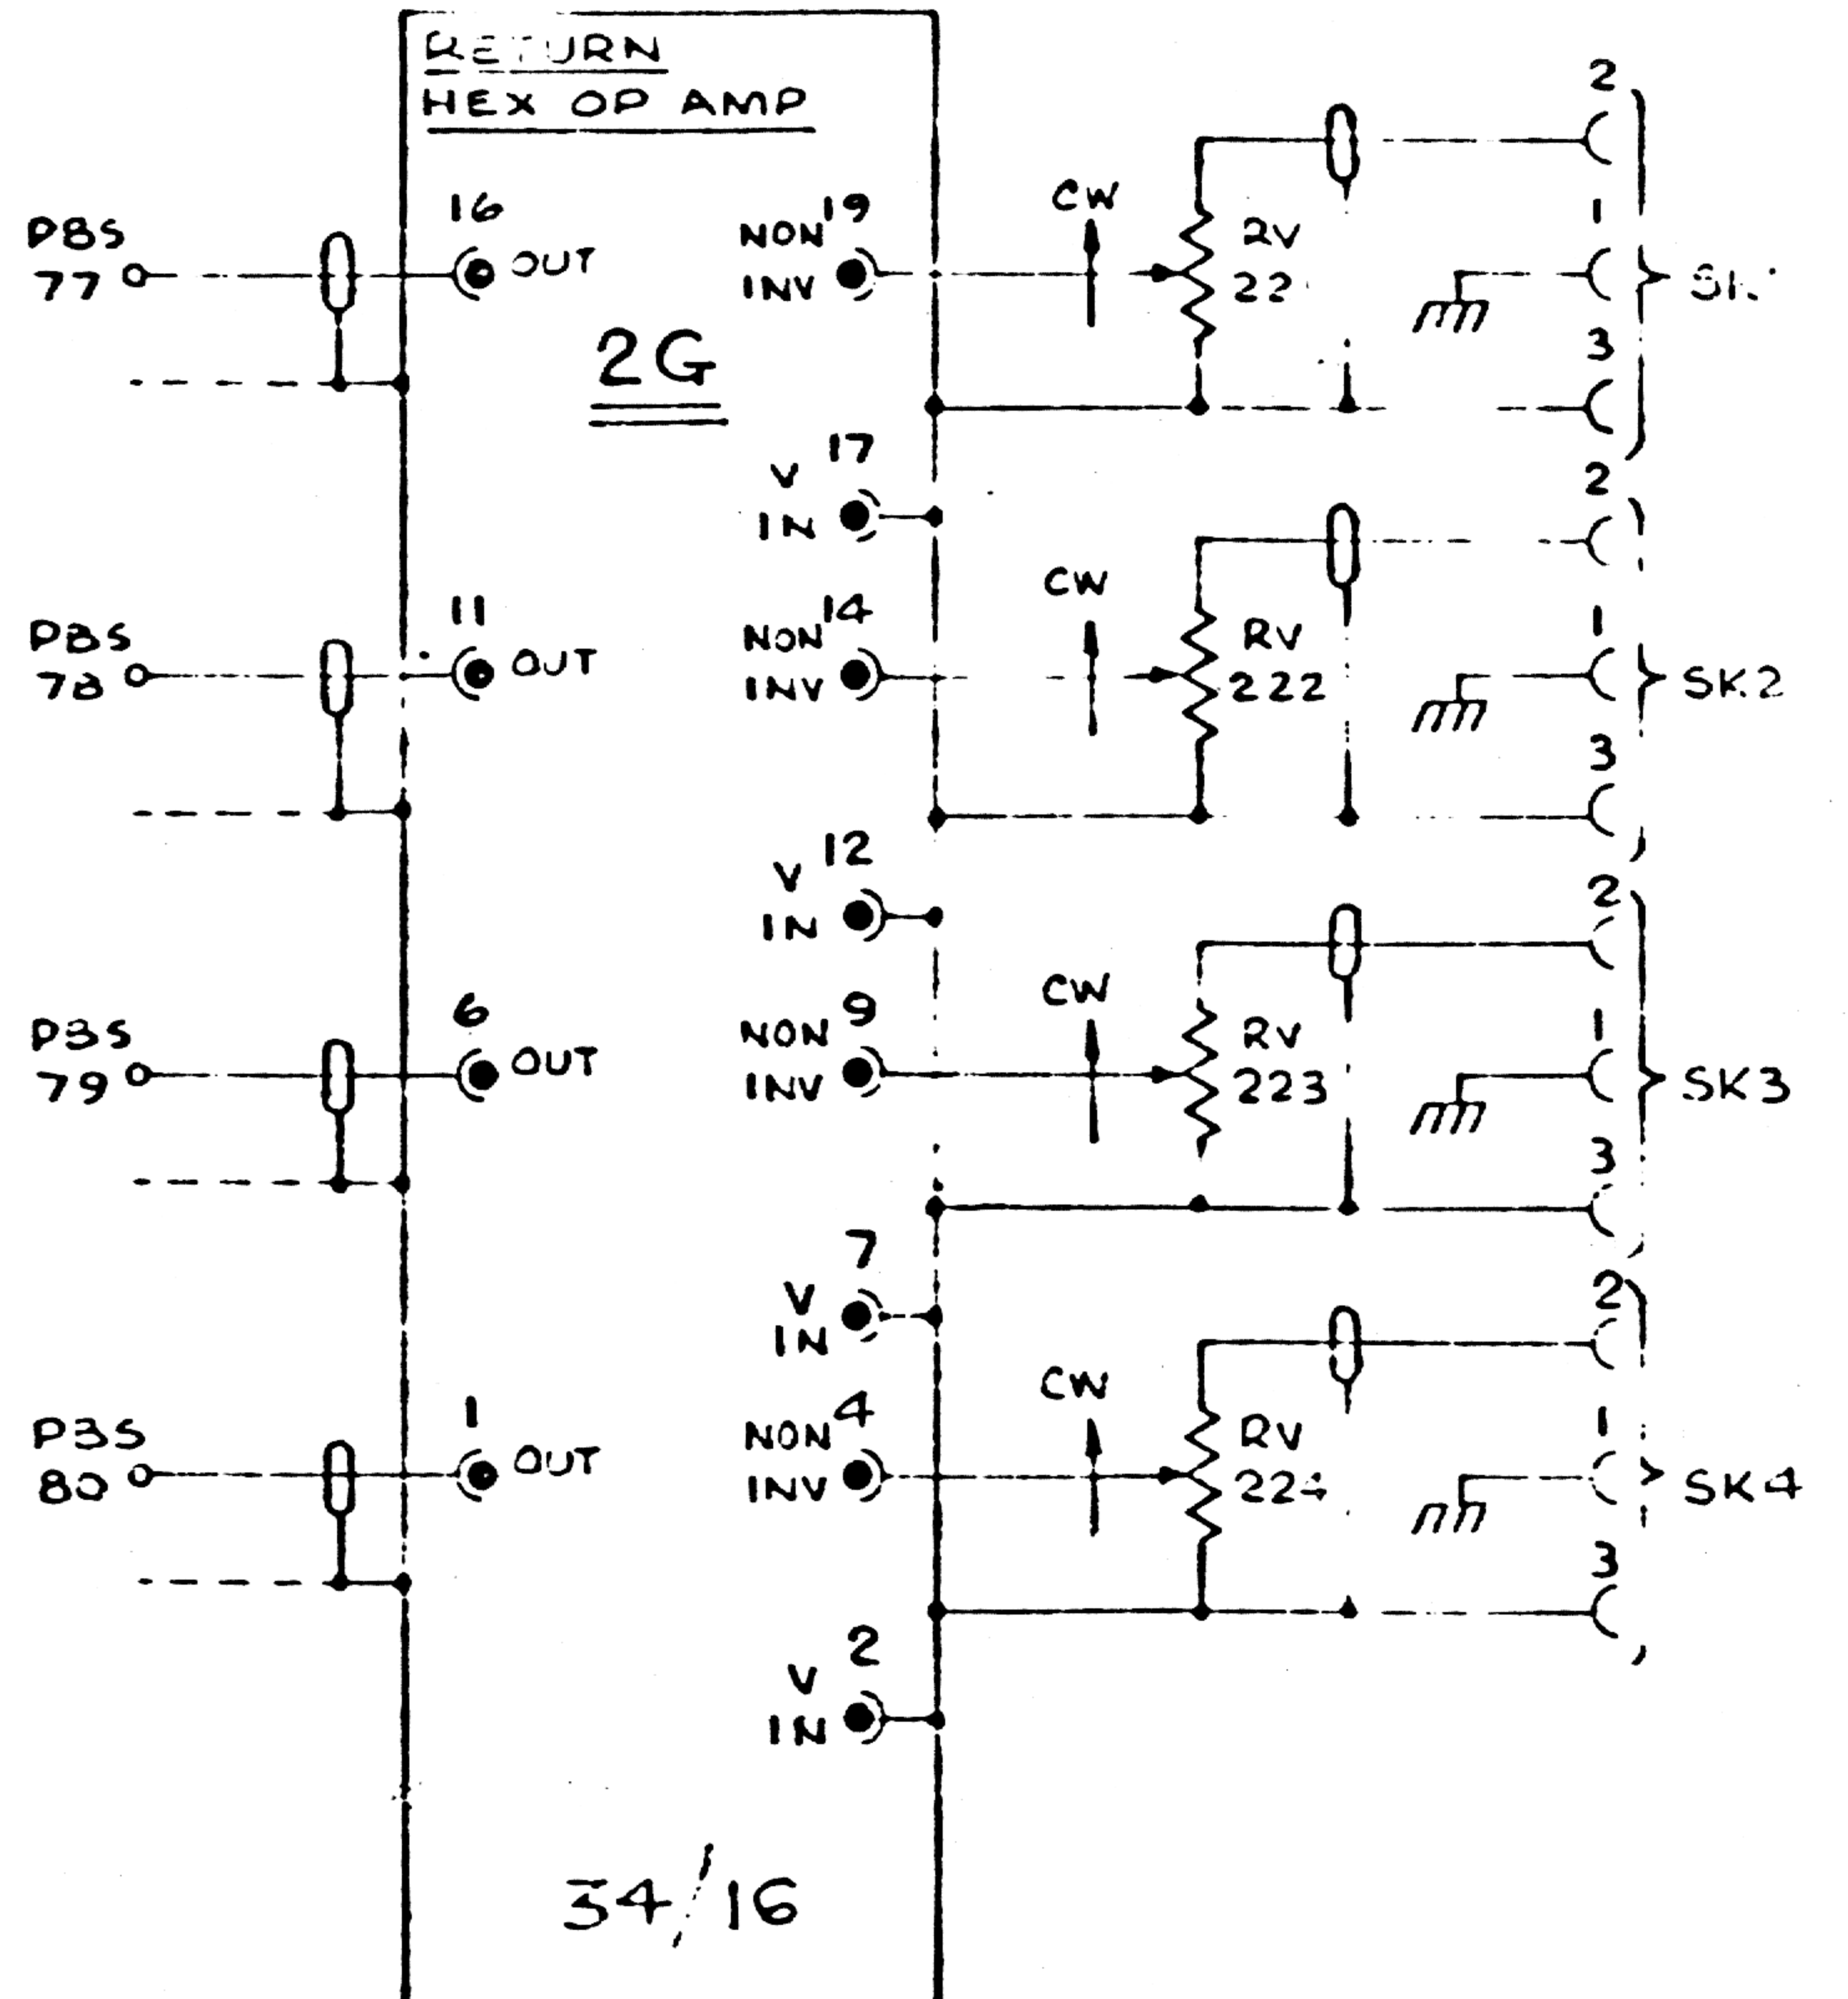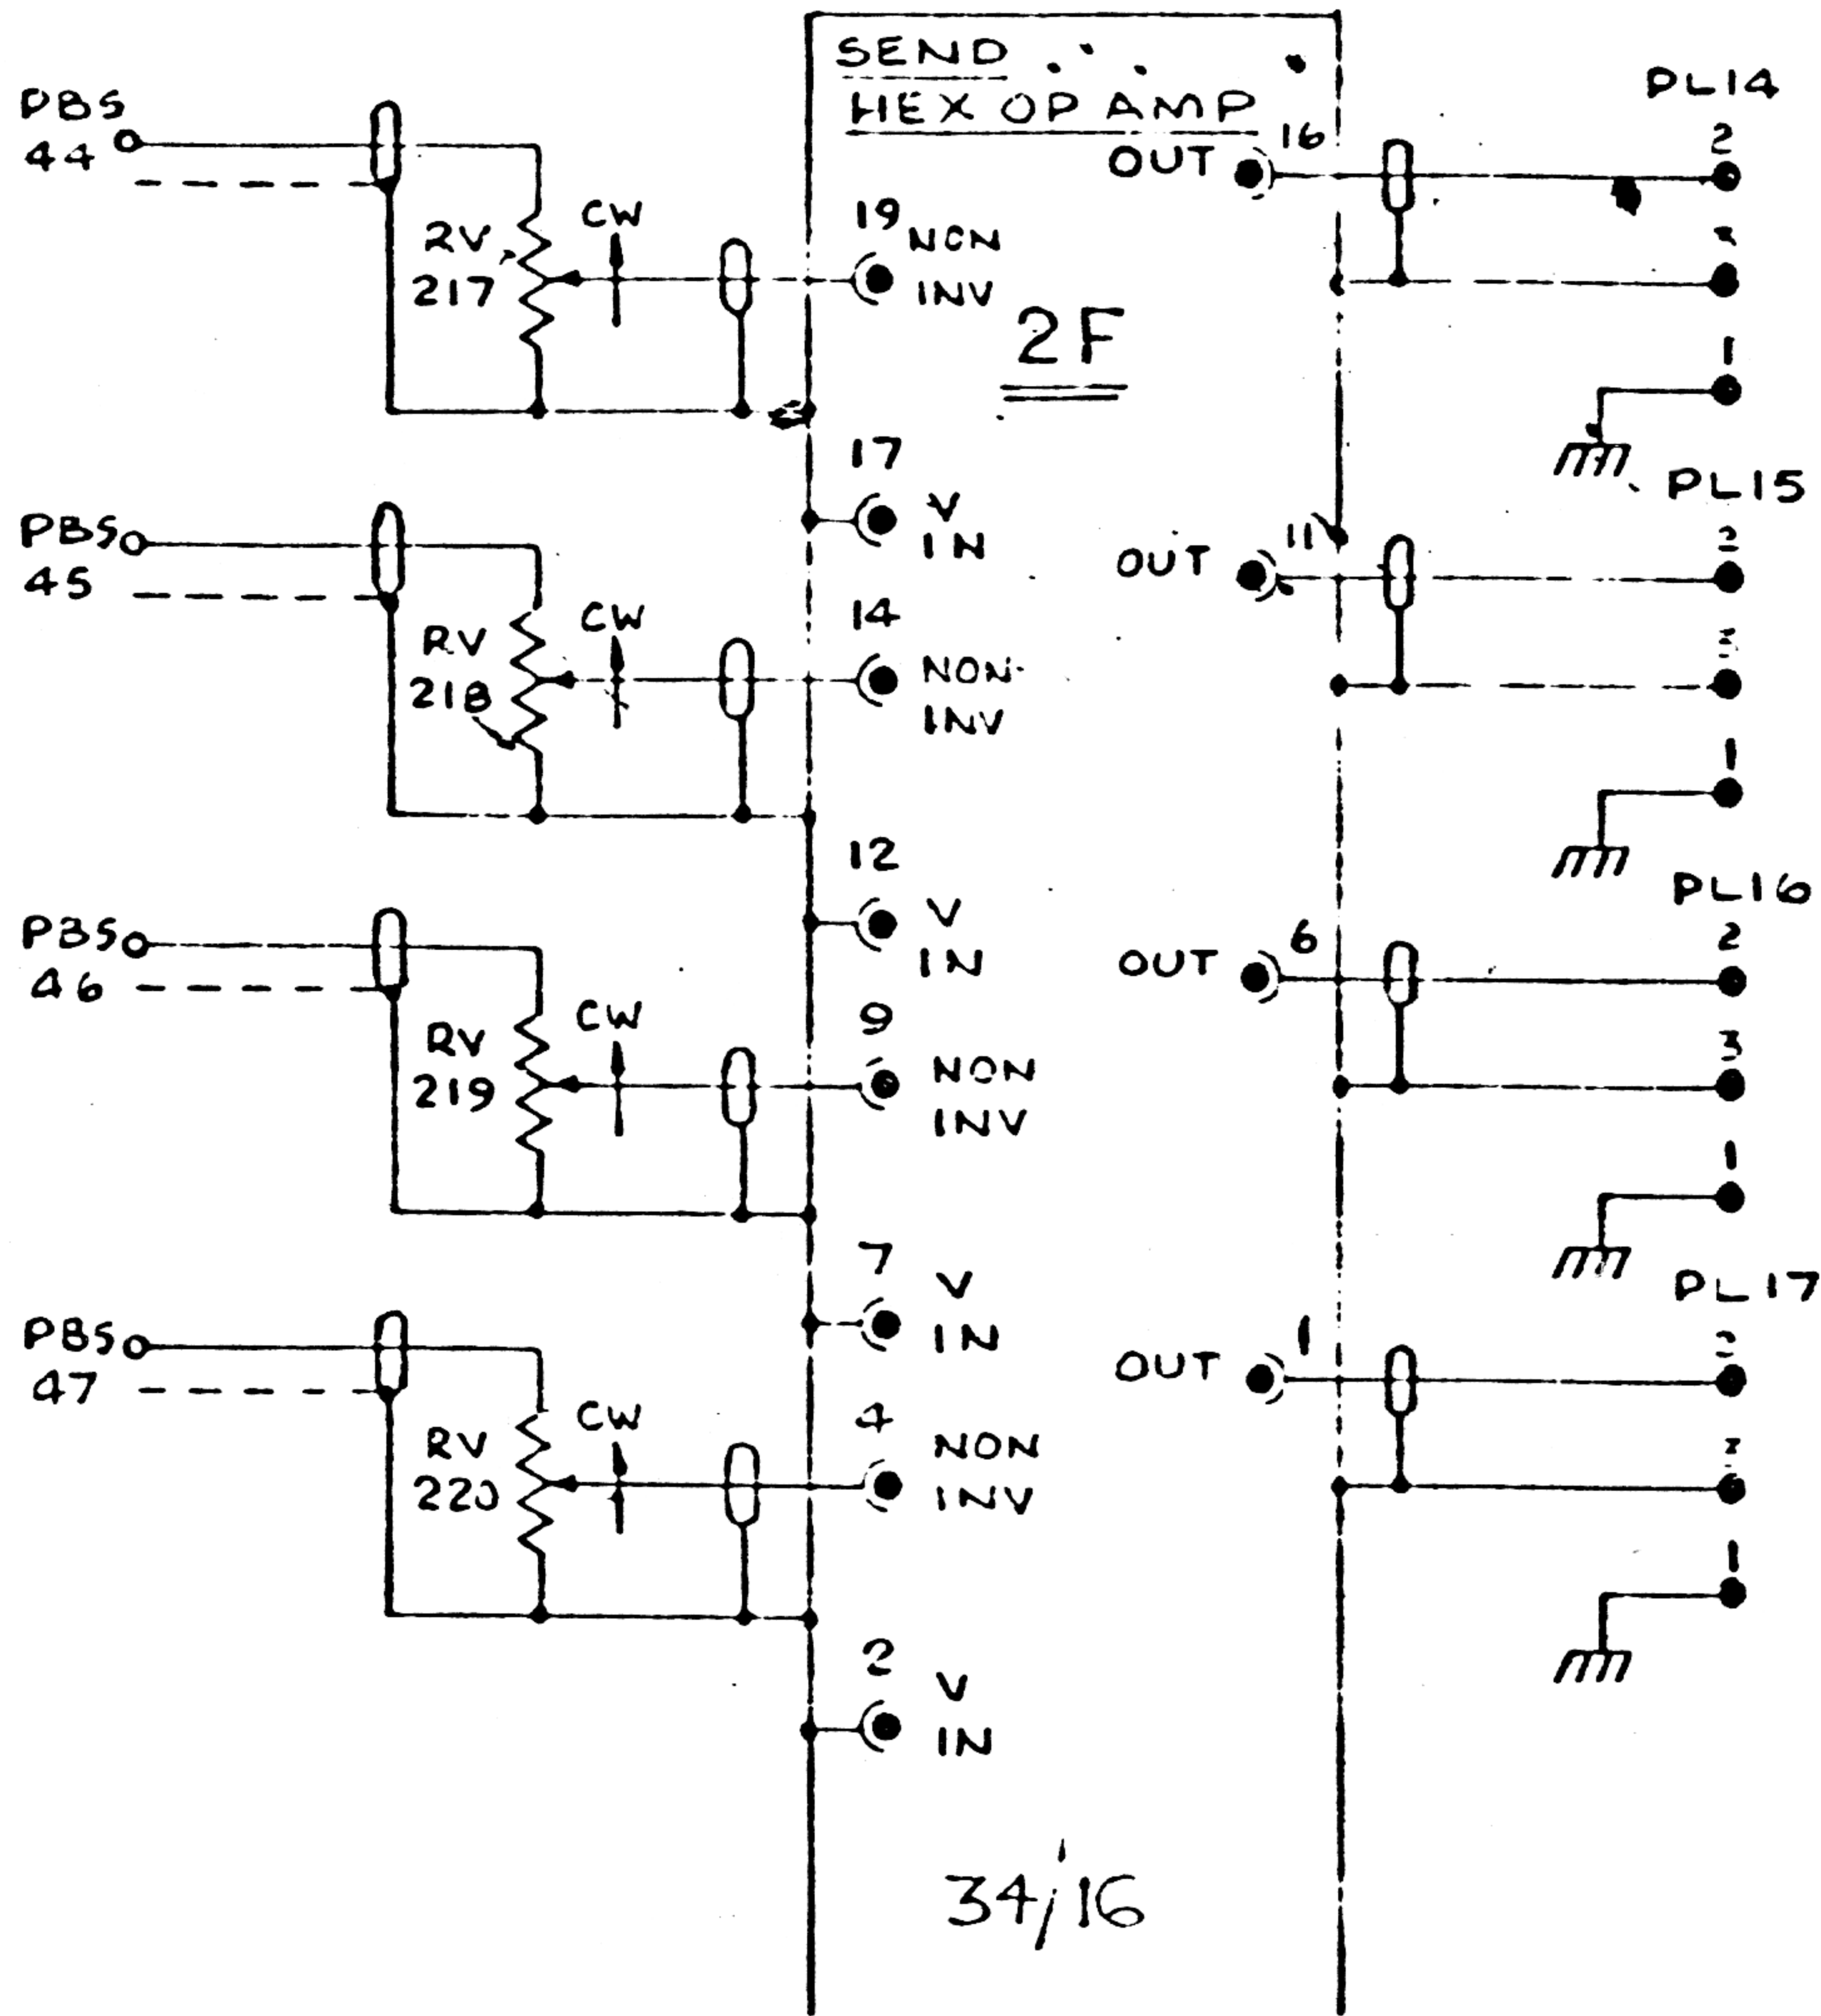


EXTERNAL TREATMENT DEVICE BUFFERS


ELECTRONIC MUSIC STUDIOS (Bournemouth) Ltd		Issue A
EXT. TREATMENT DEVICE BUFFERS		Dist No
SYNTH 100		31/15
DATE	DATE	DATE

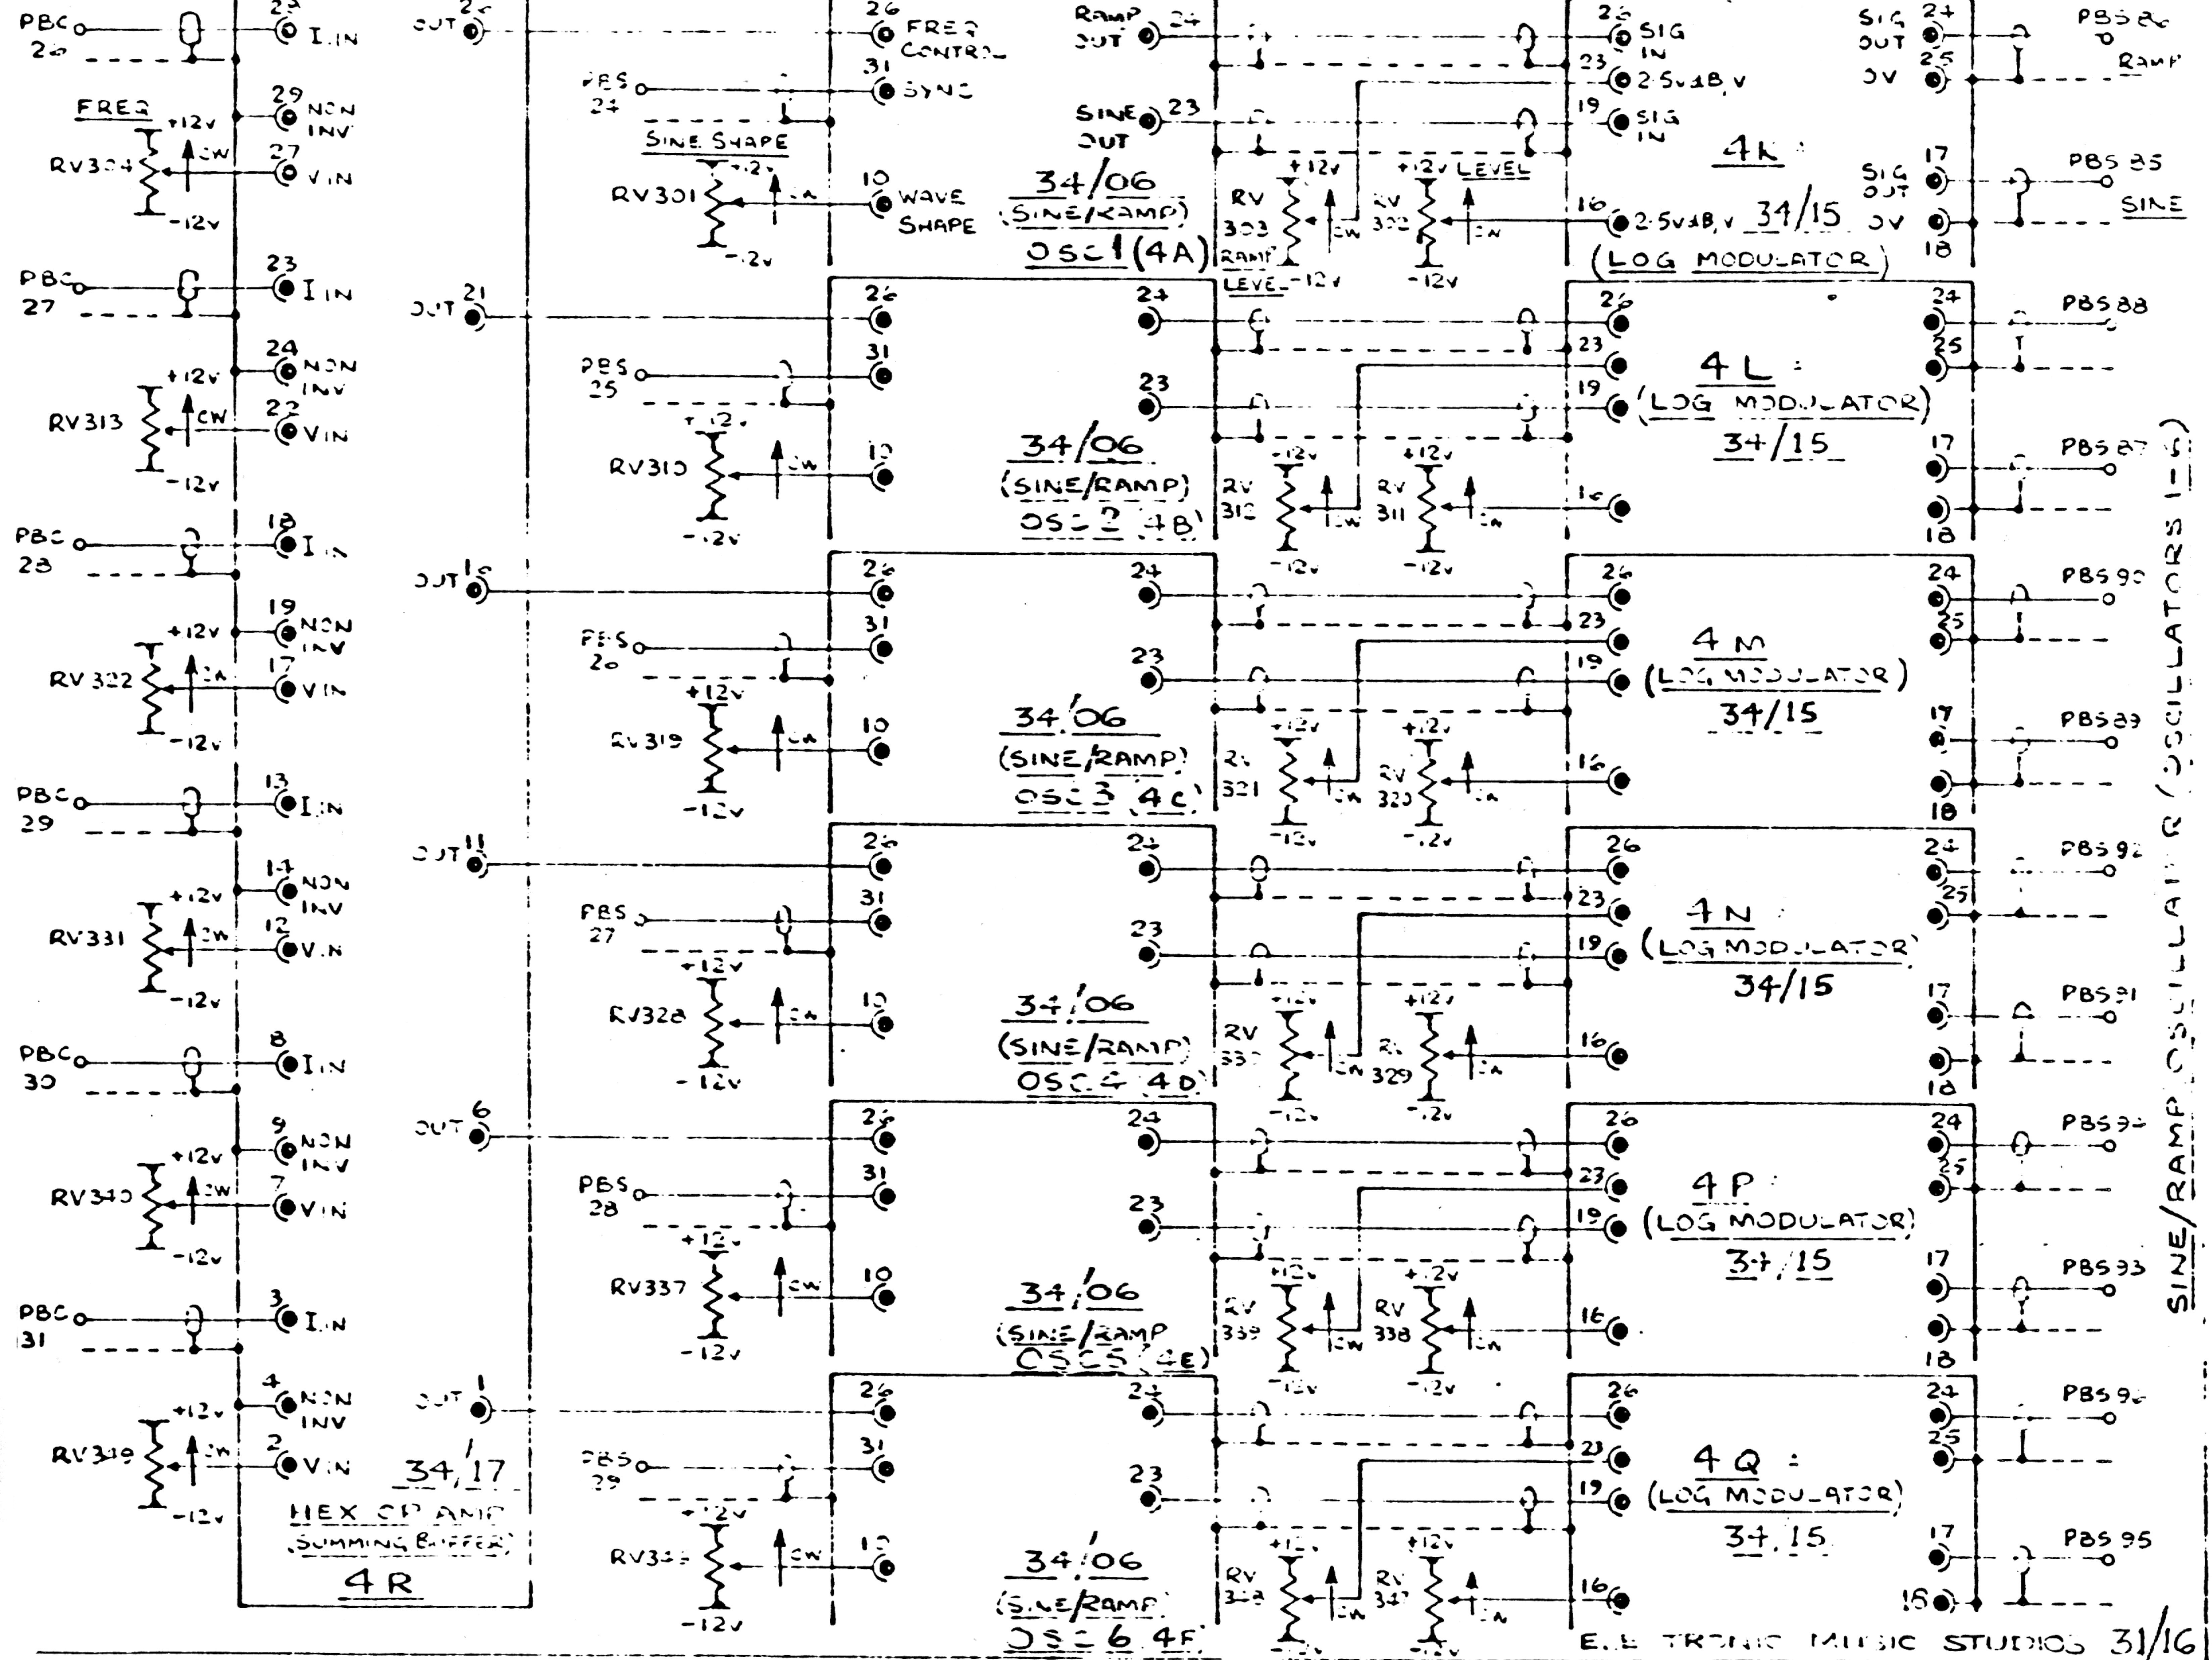


SINE/RAMP OSCILLATOR (OSCILLATORS 1-6)

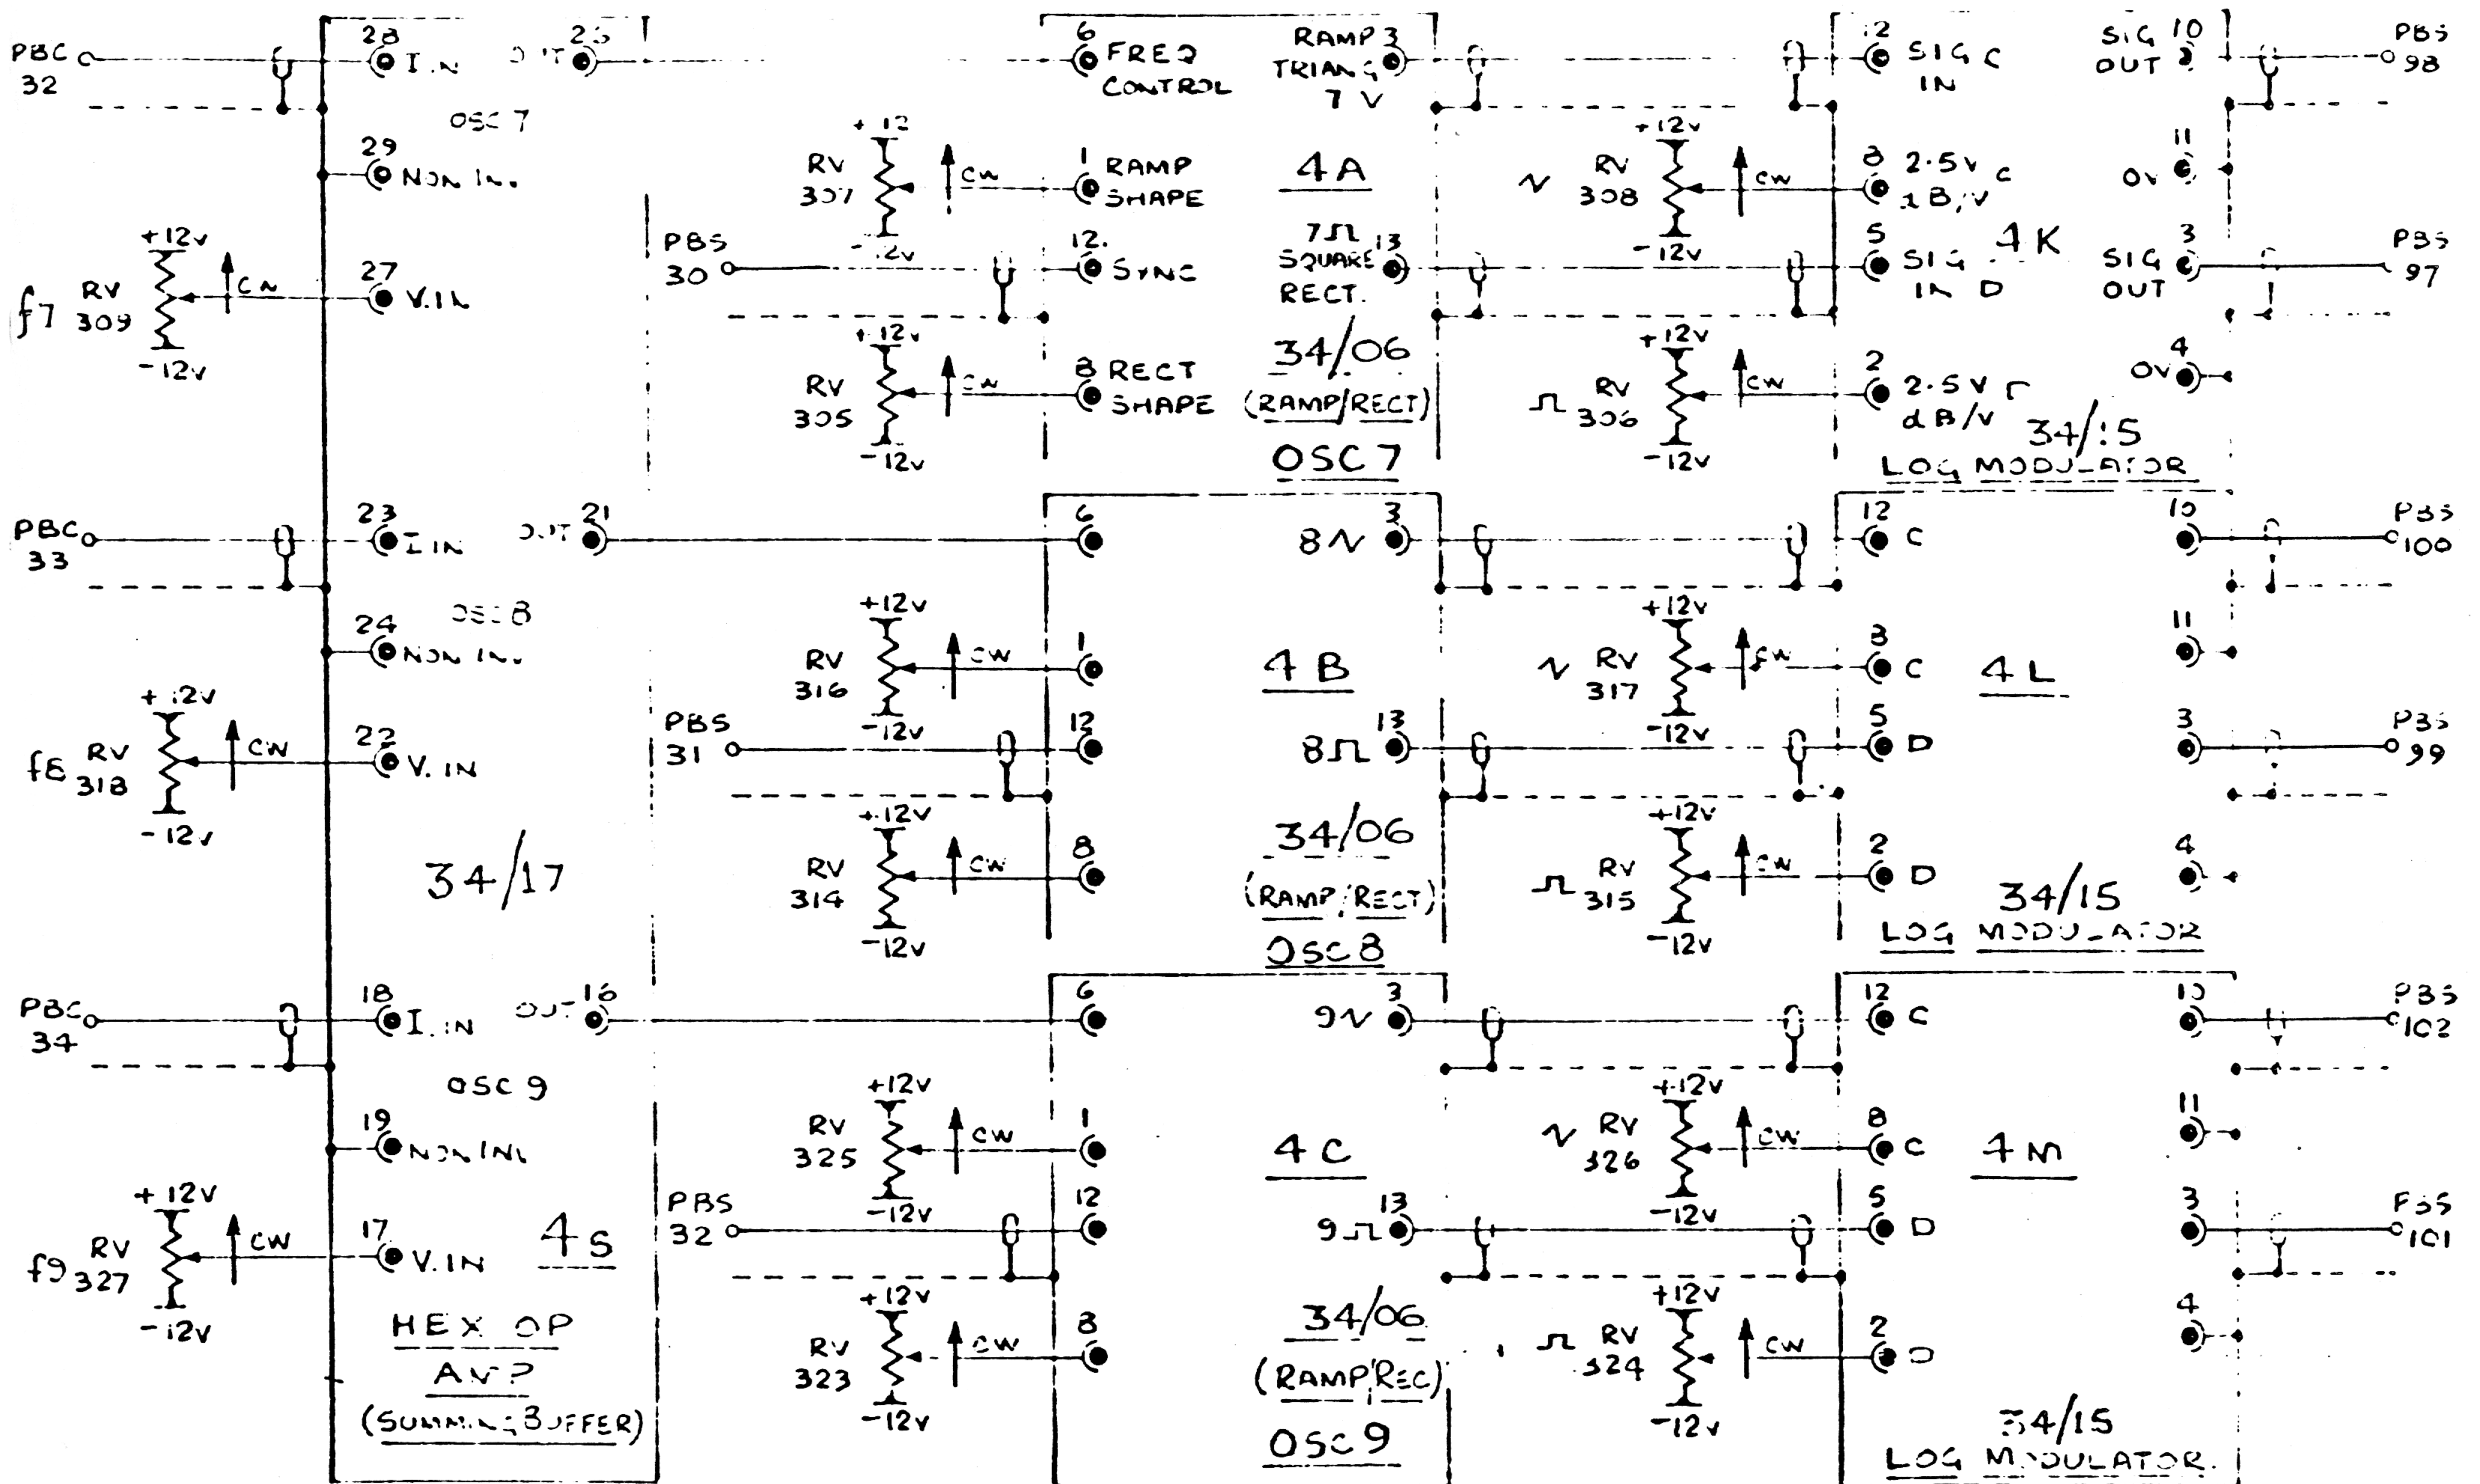


ELECTRONIC MUSIC STUDIOS Bournemouth Ltd		Issue 7
MATL	TITLE RAMP/RECT. OSC. 7849	Orig No.
FINISH	USED ON SYTHI 100	31/17
TO: ...	SCALE	CHKD BY

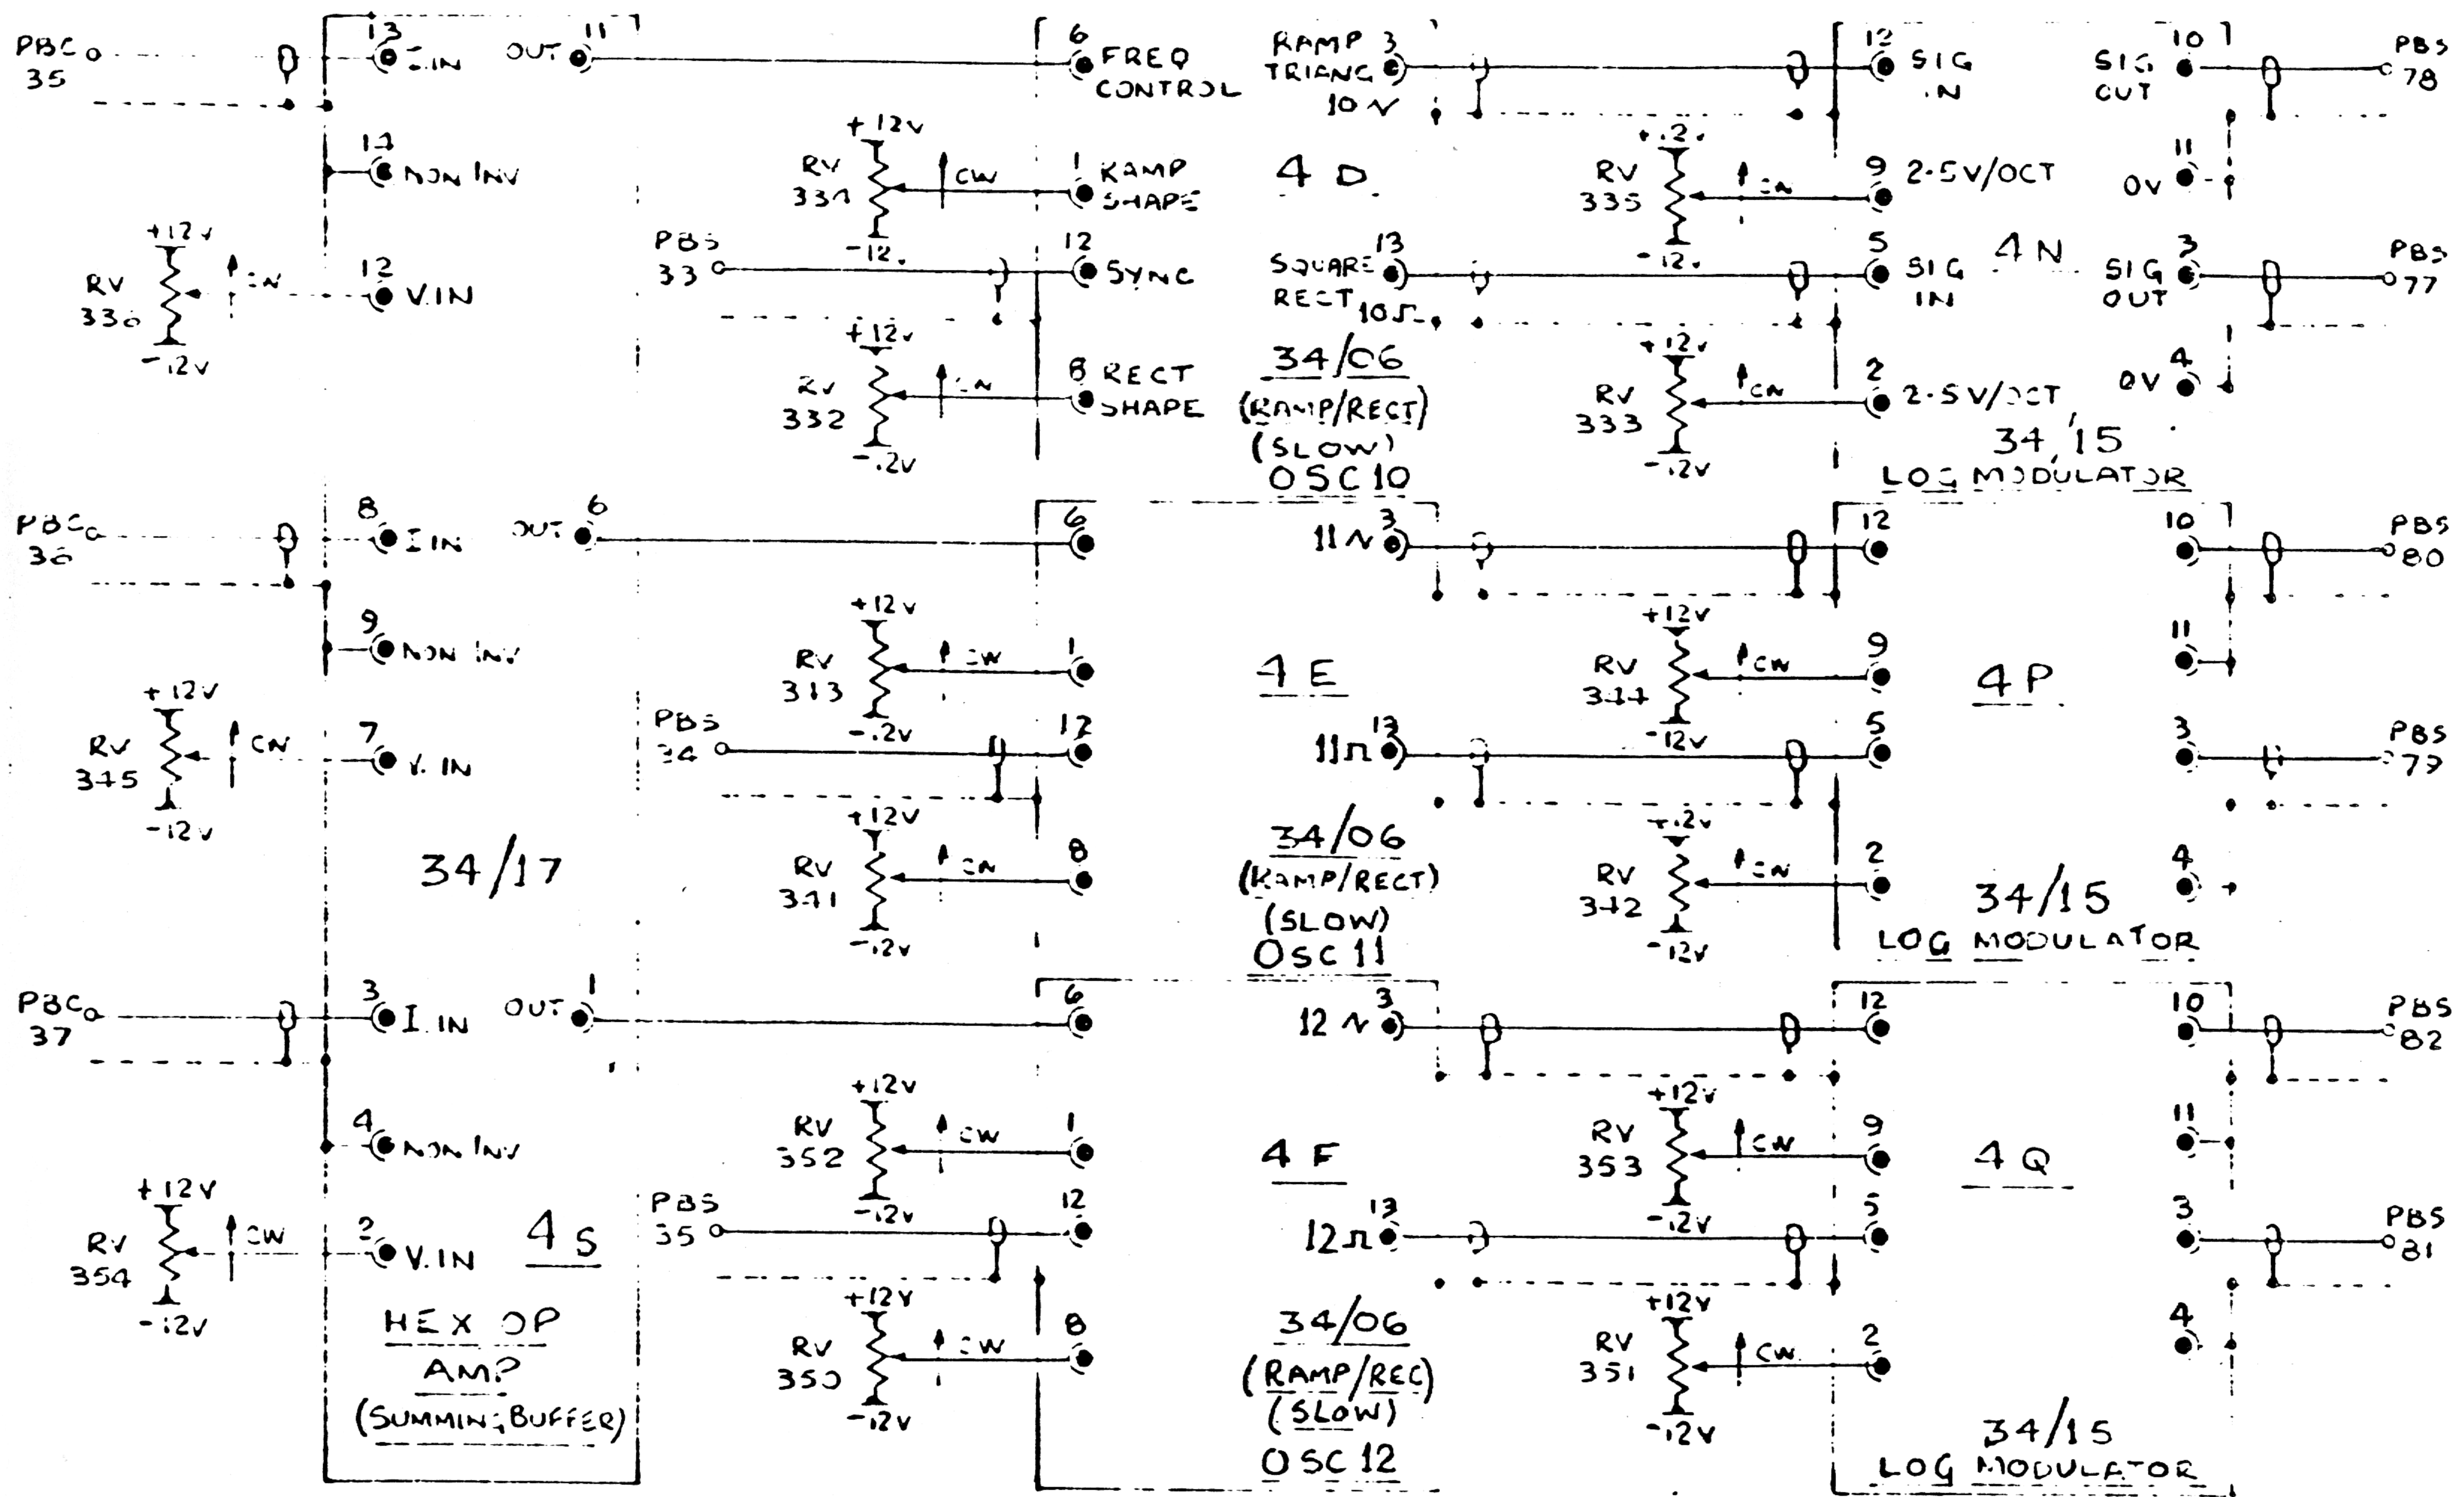

ELECTRONIC MUSIC STUDIOS (Bournemouth) Ltd		Issue A
RAMP, RECT, OSC (1, 2, 3, 4, 5, 6)		Orig No
IN SYNTH. 100		31/18
DATE	DATE	DATE

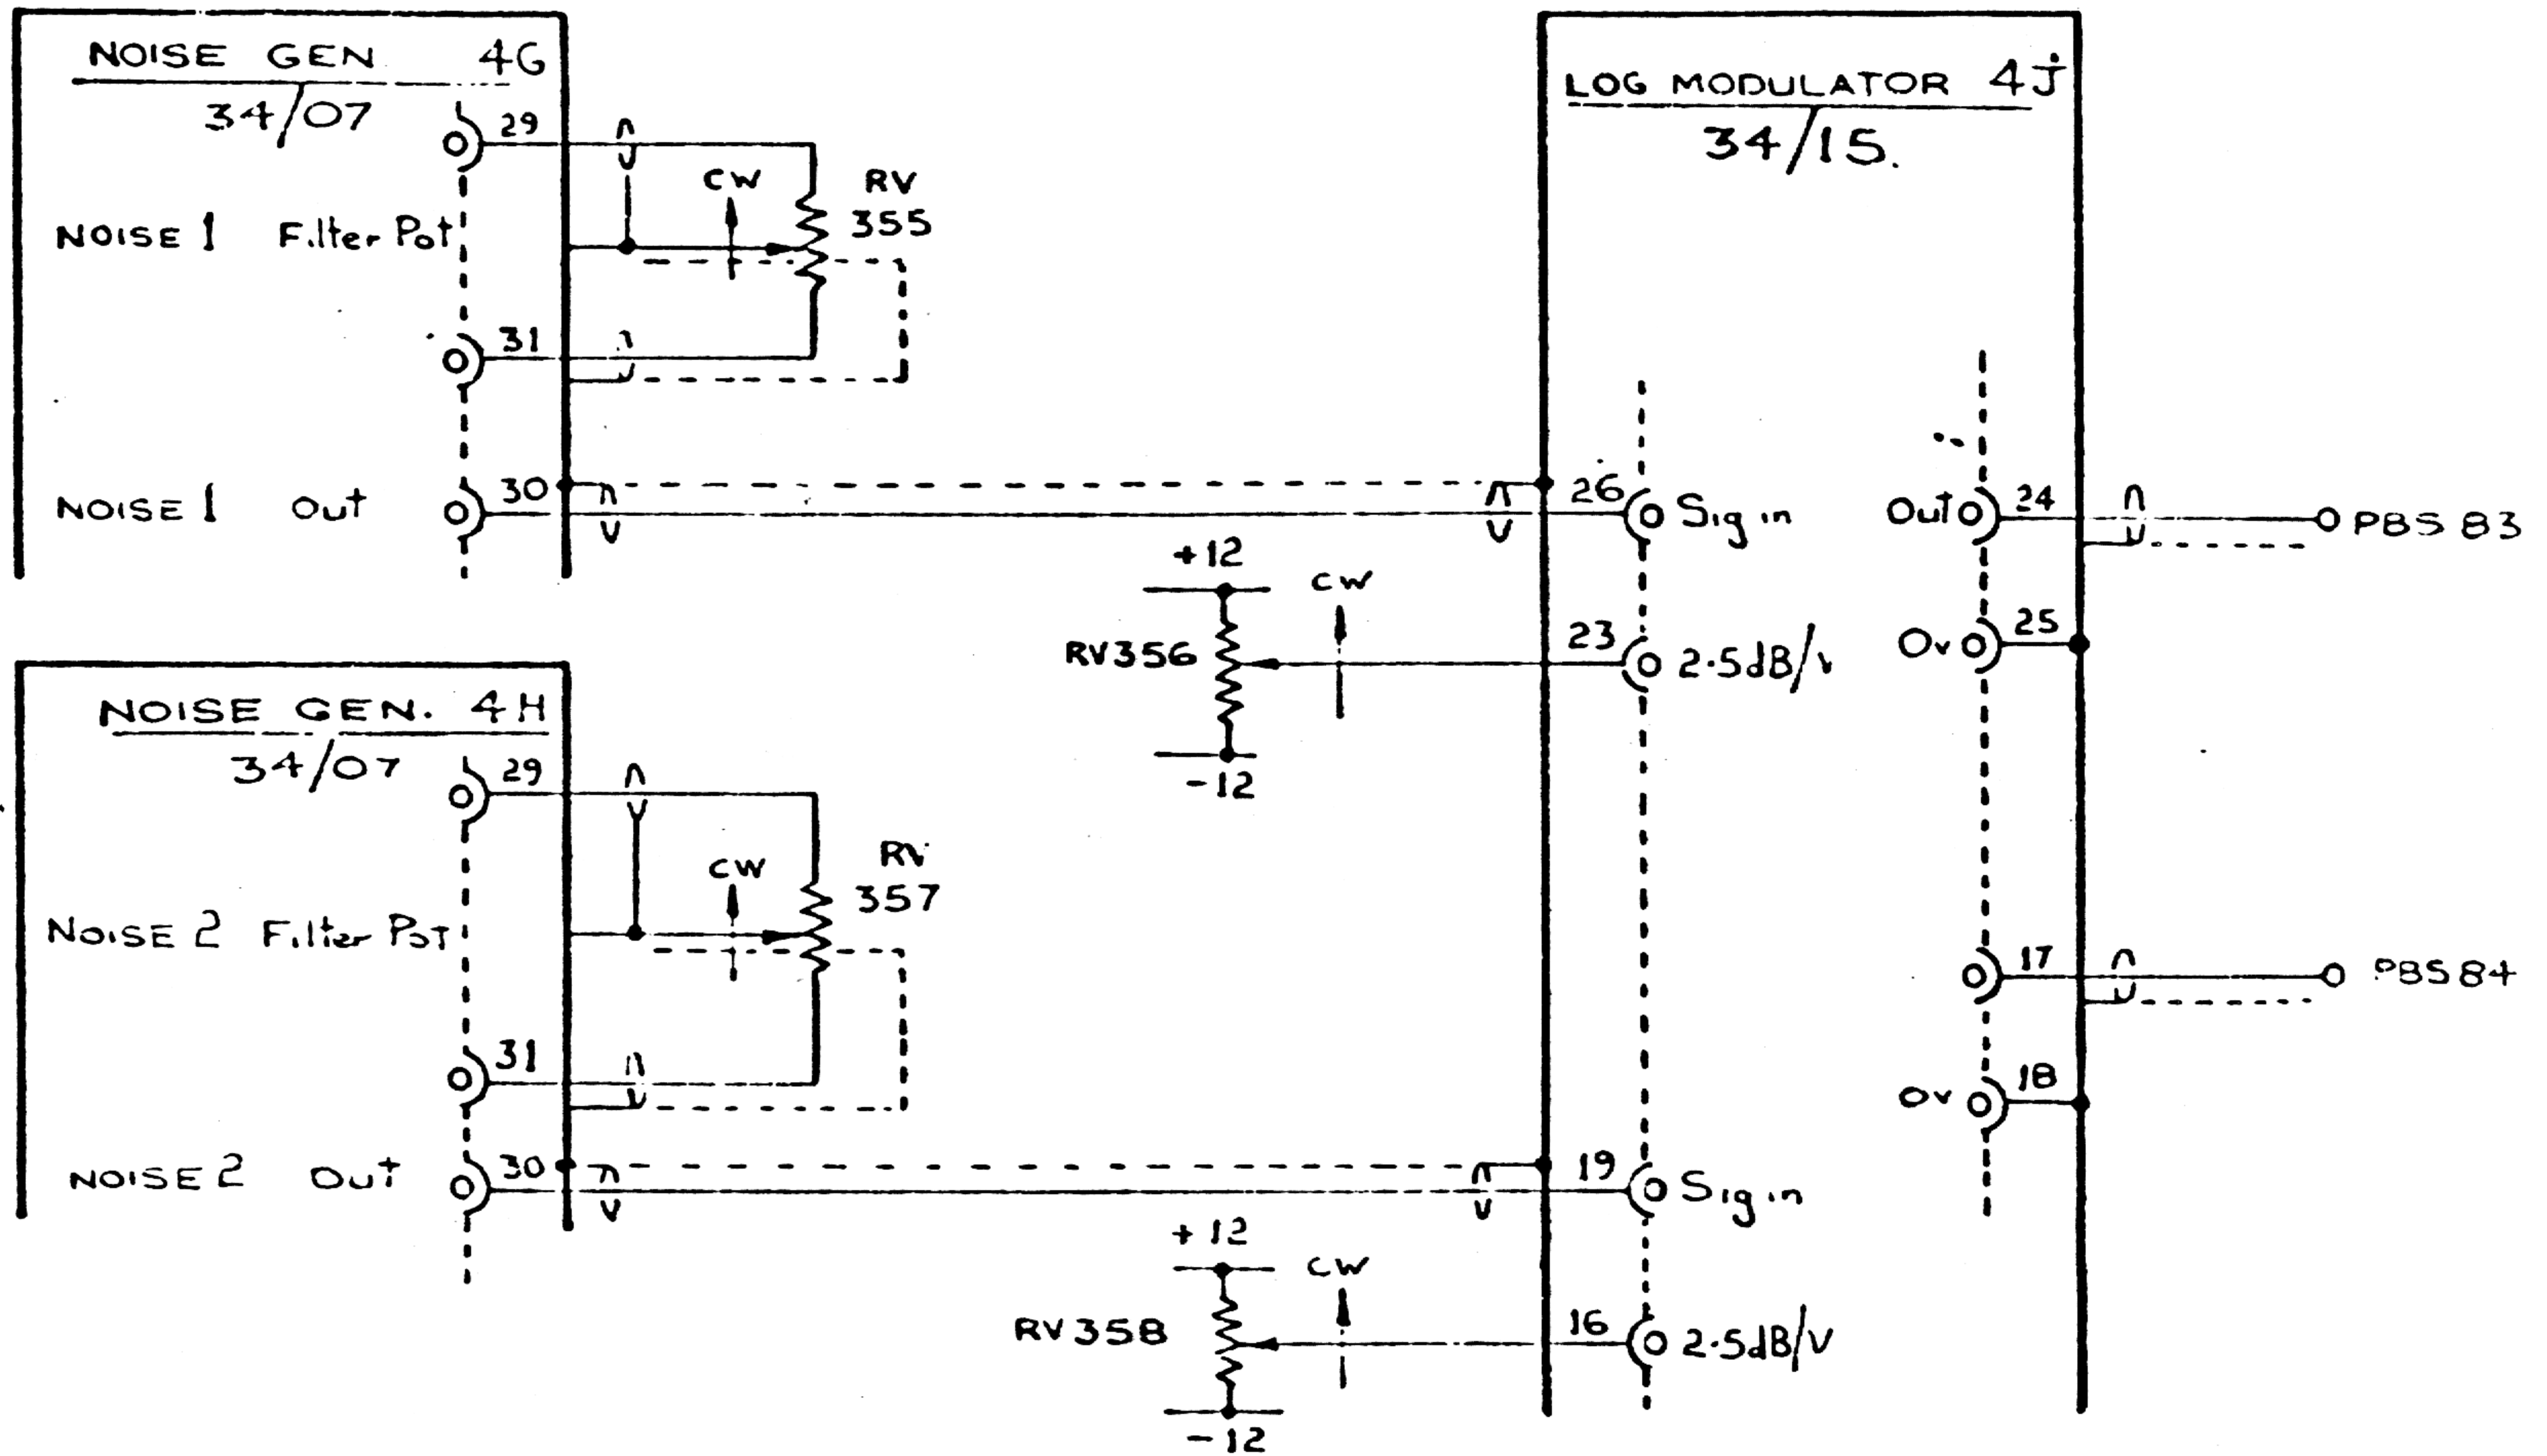


ELECTRONIC MUSIC STUDIOS (Bournemouth) Ltd		issue A
MATL	TITLE <u>MODULE WIRING</u> <u>NOISE GEN 1 & 2</u>	Drg NO
FINISH	USED ON <u>SYNTH 100</u>	<u>31/19</u>
DATE	SCALE	CHKD
16/6/71		DATE 16/6/71

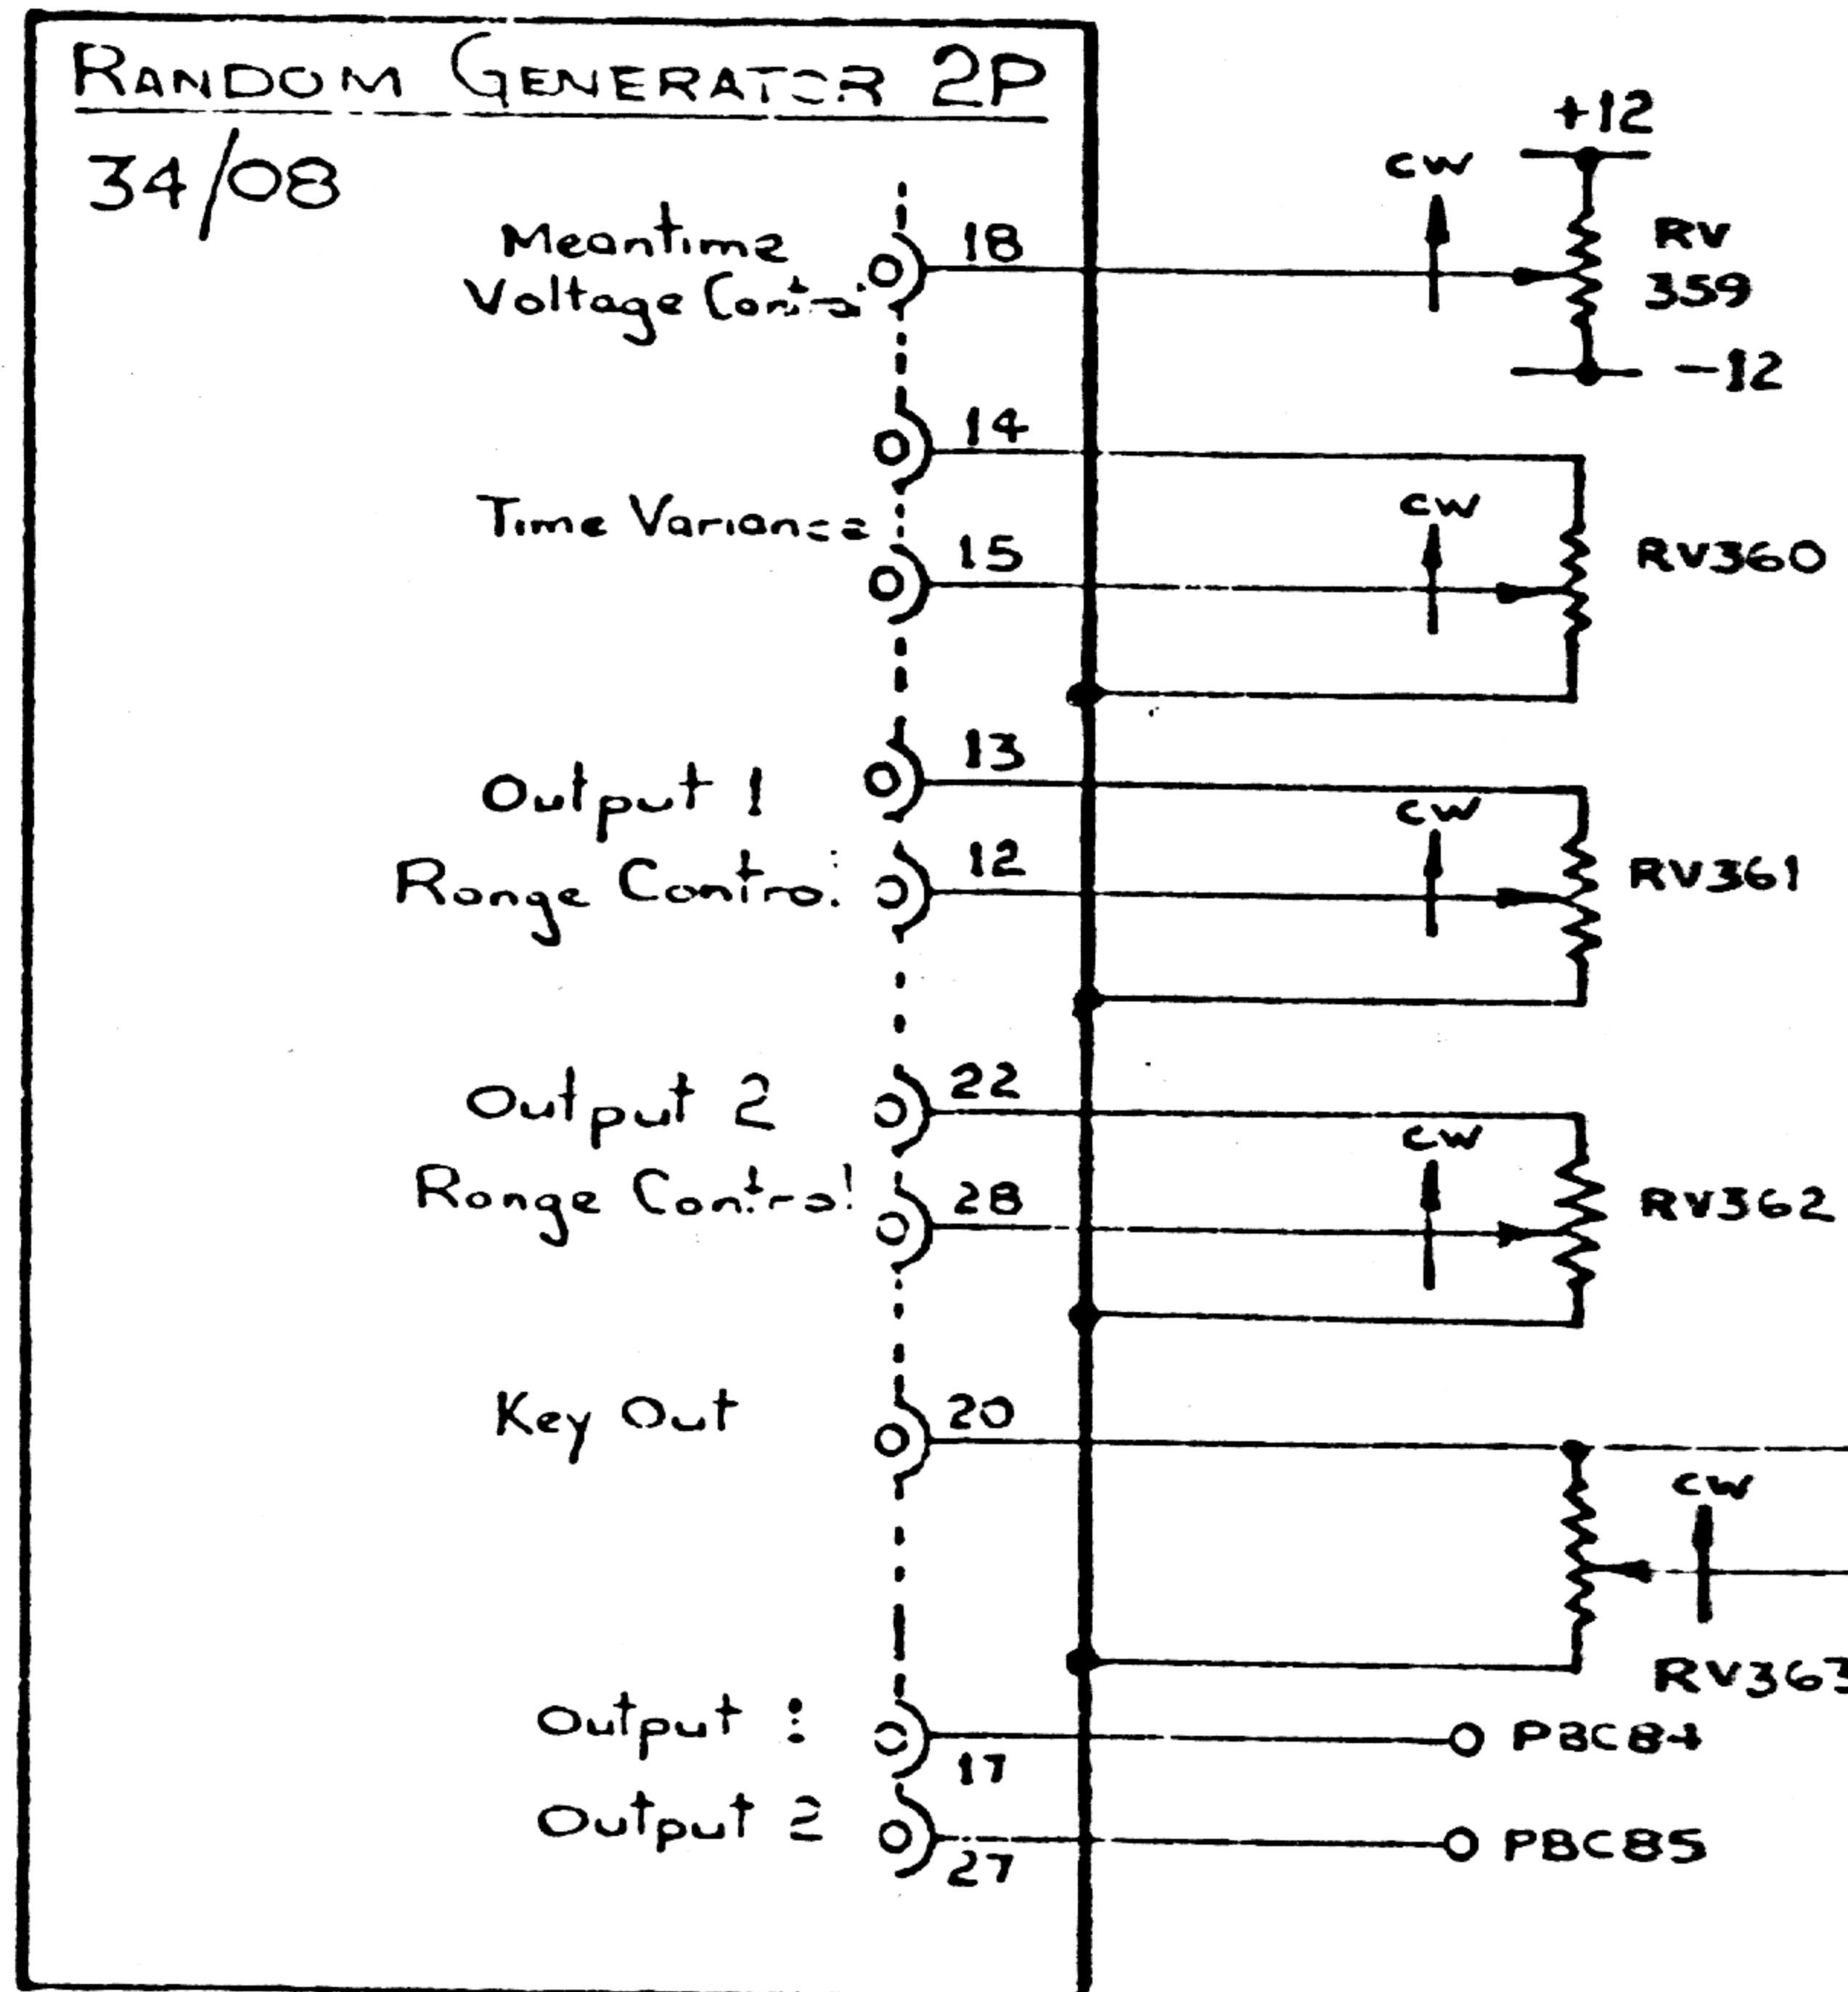


NOTE Resistors must be added to existing Random Generator module to produce bipolar Key Voltage.

ELECTRONIC MUSIC STUDIOS (Bournemouth) Ltd				Issue: A
MATL	TITLE MODULE WIRING RANDOM GENE.		Drg NO 31/20	
FINISH	USED ON SYNTHI 100			
TOL	Fr. / Dec	Angies	SCALE	CHKD DATE
DHN				DATE 16.6.71

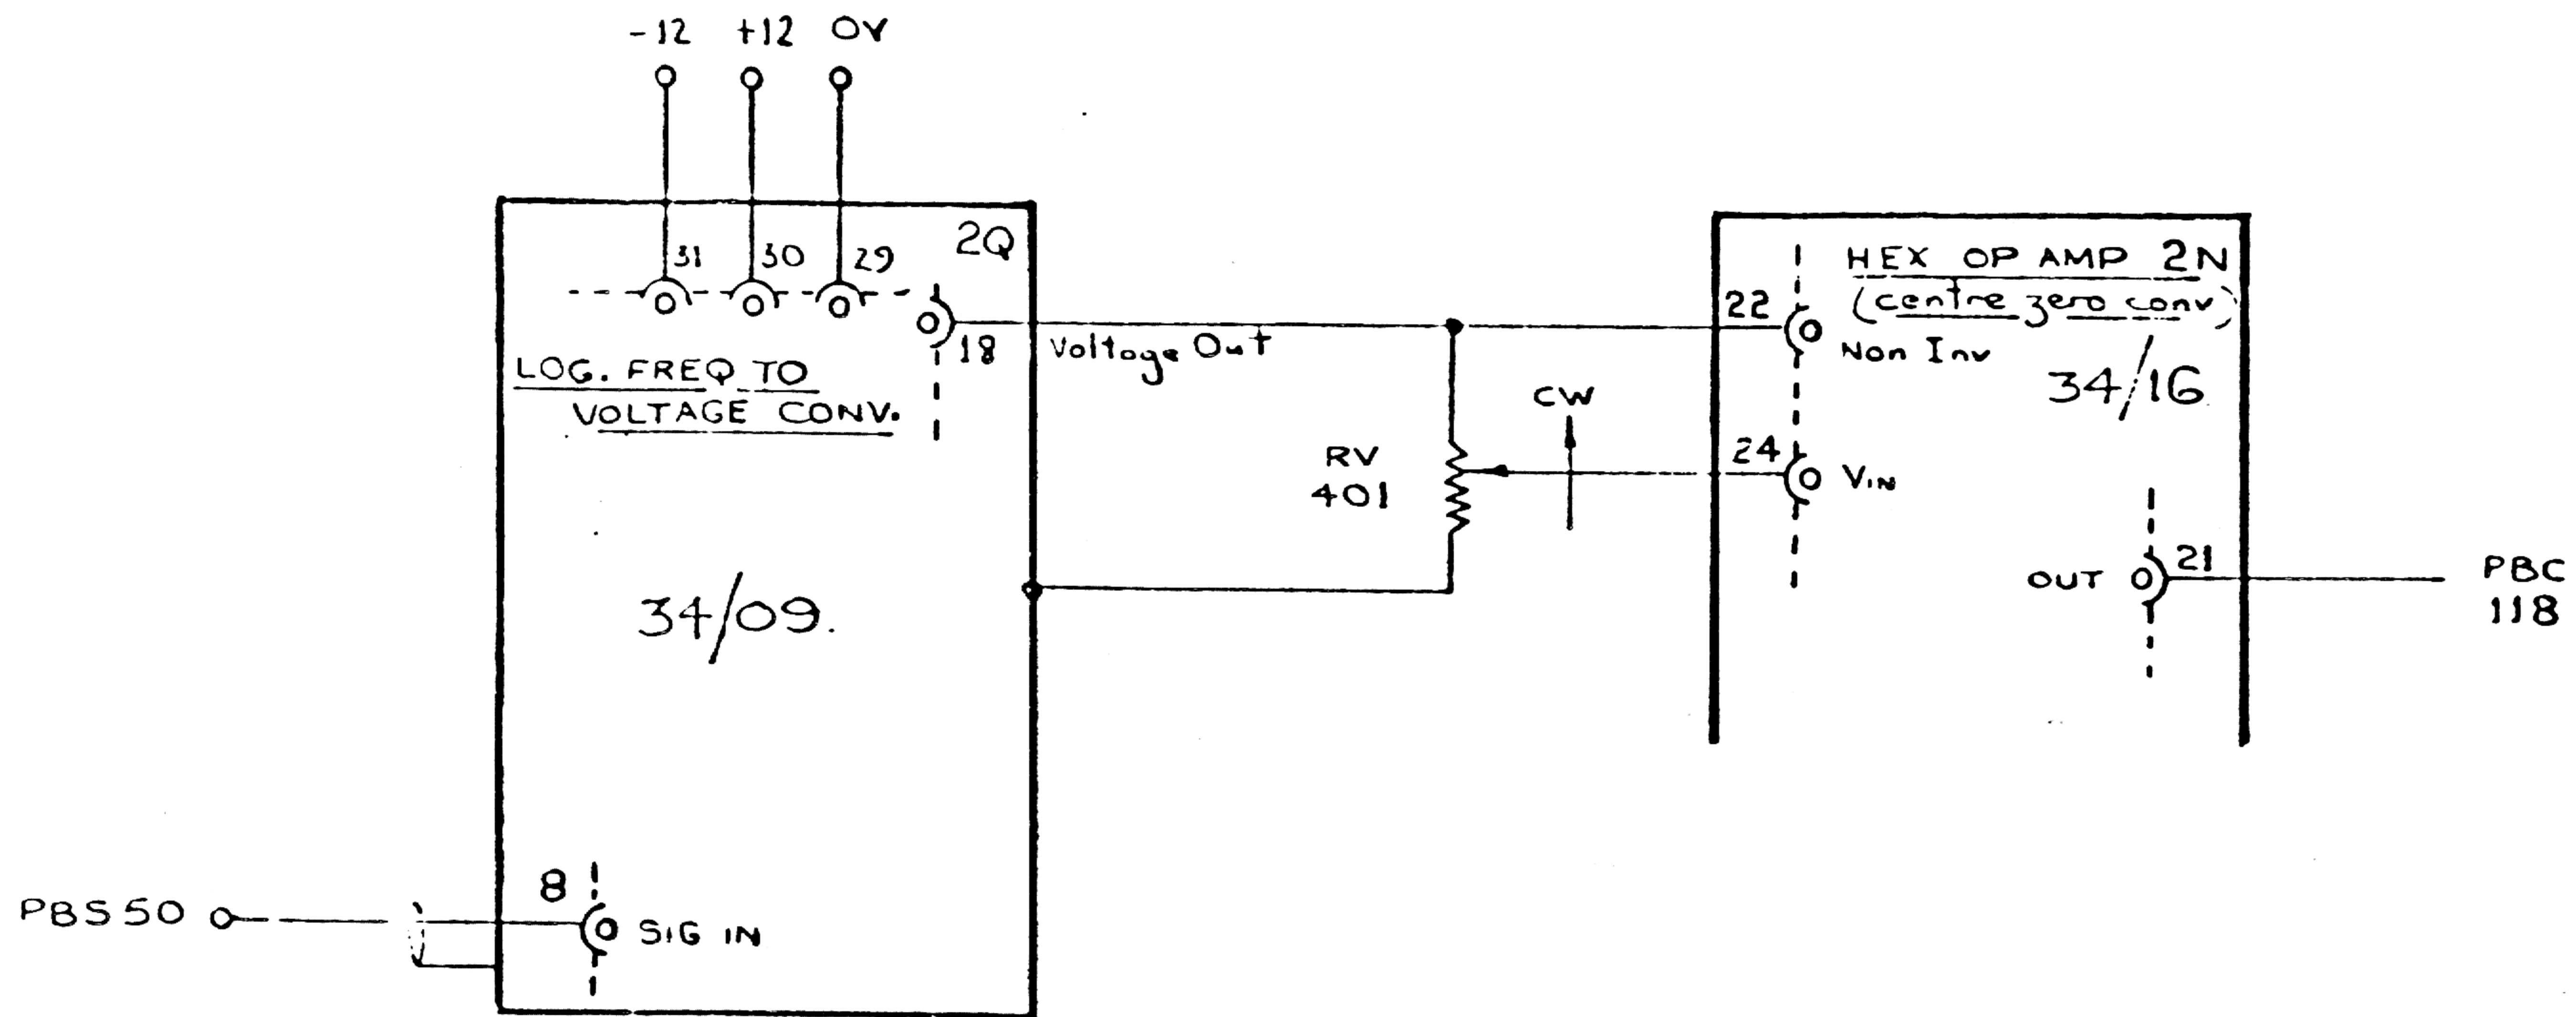

B N^os 24 & 22
 rev.
 MA 5.8.71


ELECTRONIC MUSIC STUDIOS (Bournemouth) Ltd		issue A
MATL ✓	TITLE <u>MODULE WIRING</u> <u>PITCH TO VOLT. CONV.</u>	Drg N ^o 31/21
FINISH ✓	USED ON <u>SYNTHI 100.</u>	
TOL Frac Dec Angles	SCALE	CHKD DATE
		DRN DATE 16.6.71

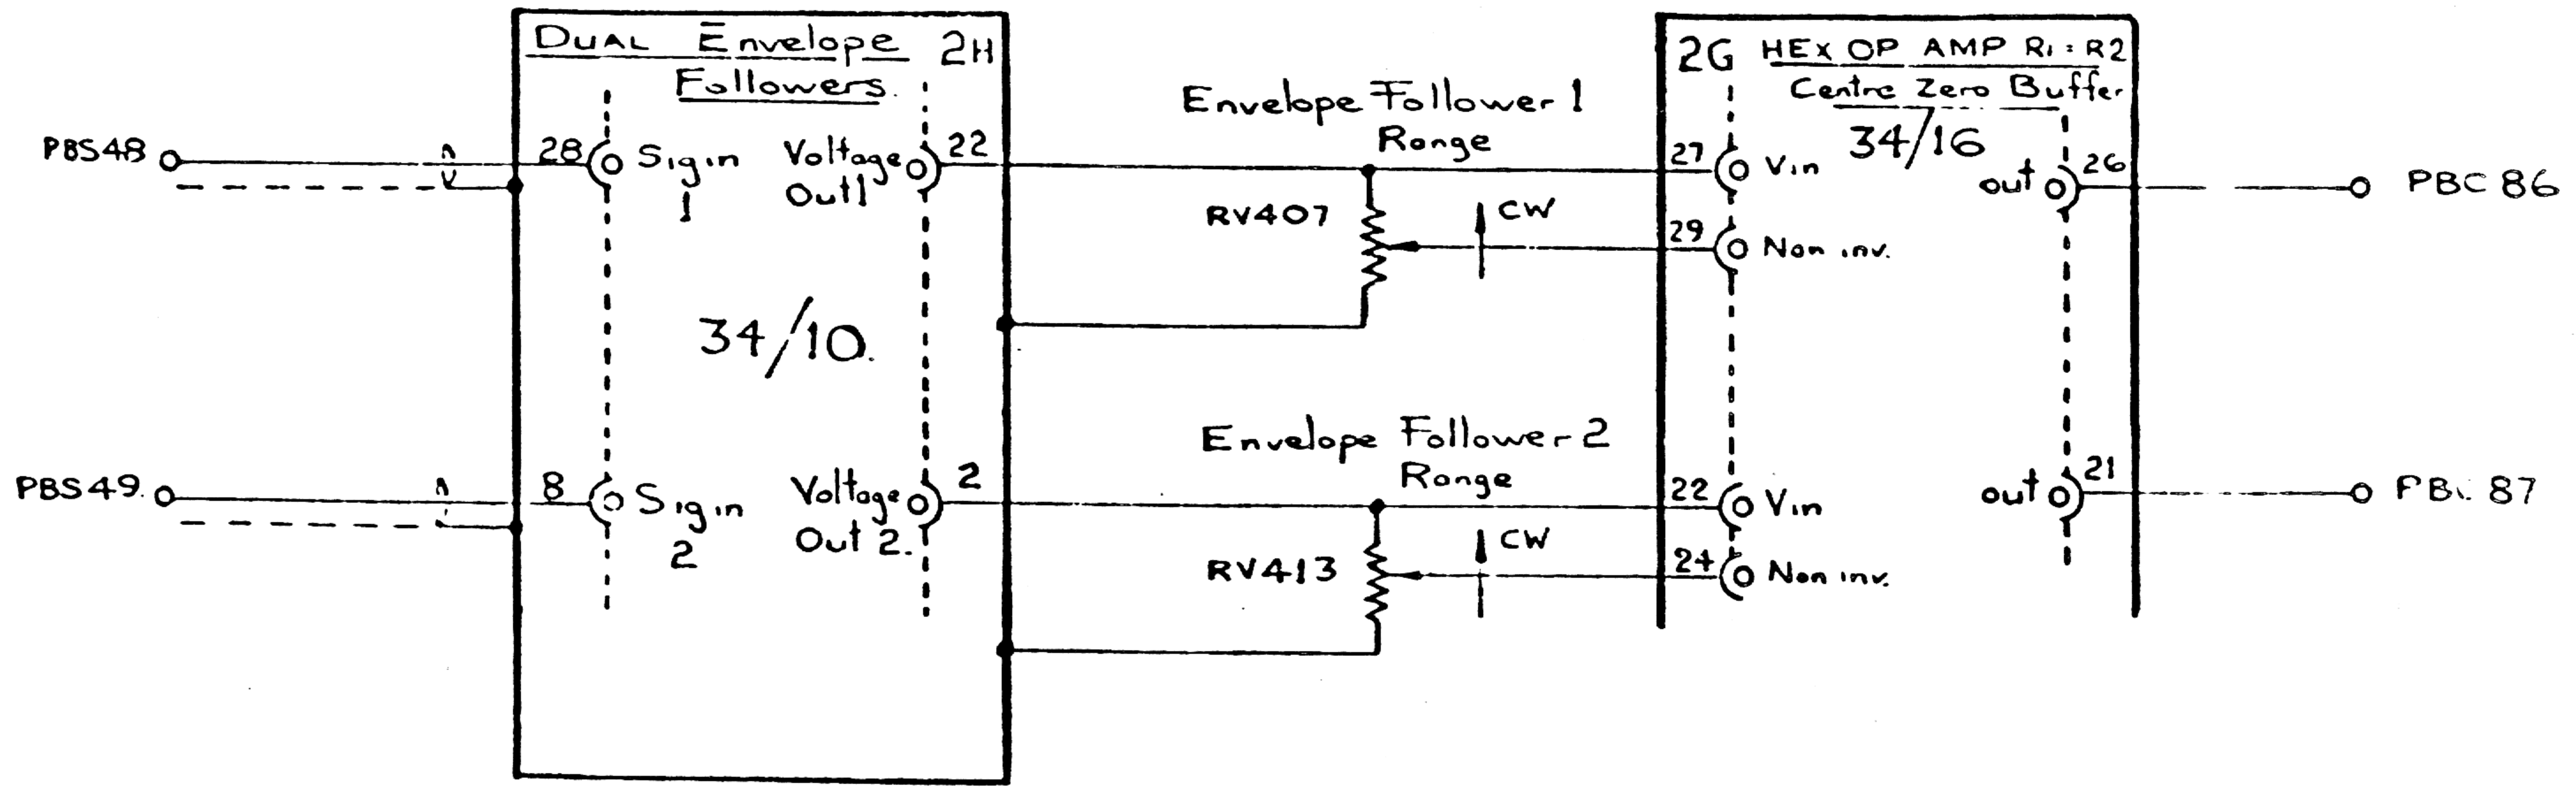

ELECTRONIC MUSIC STUDIOS (Bournemouth) Ltd		Issue A
MATE	TITLE <u>MODULE WIRING</u>	Drg NO
FINISH	<u>ENVELOPE FOLLOWERS</u>	<u>31/22</u>
	USED ON <u>SYNTHI 100</u>	
TOL	DATE	DATE 16.11

DOUBLE KEYBOARD

MAIN CONSOLE

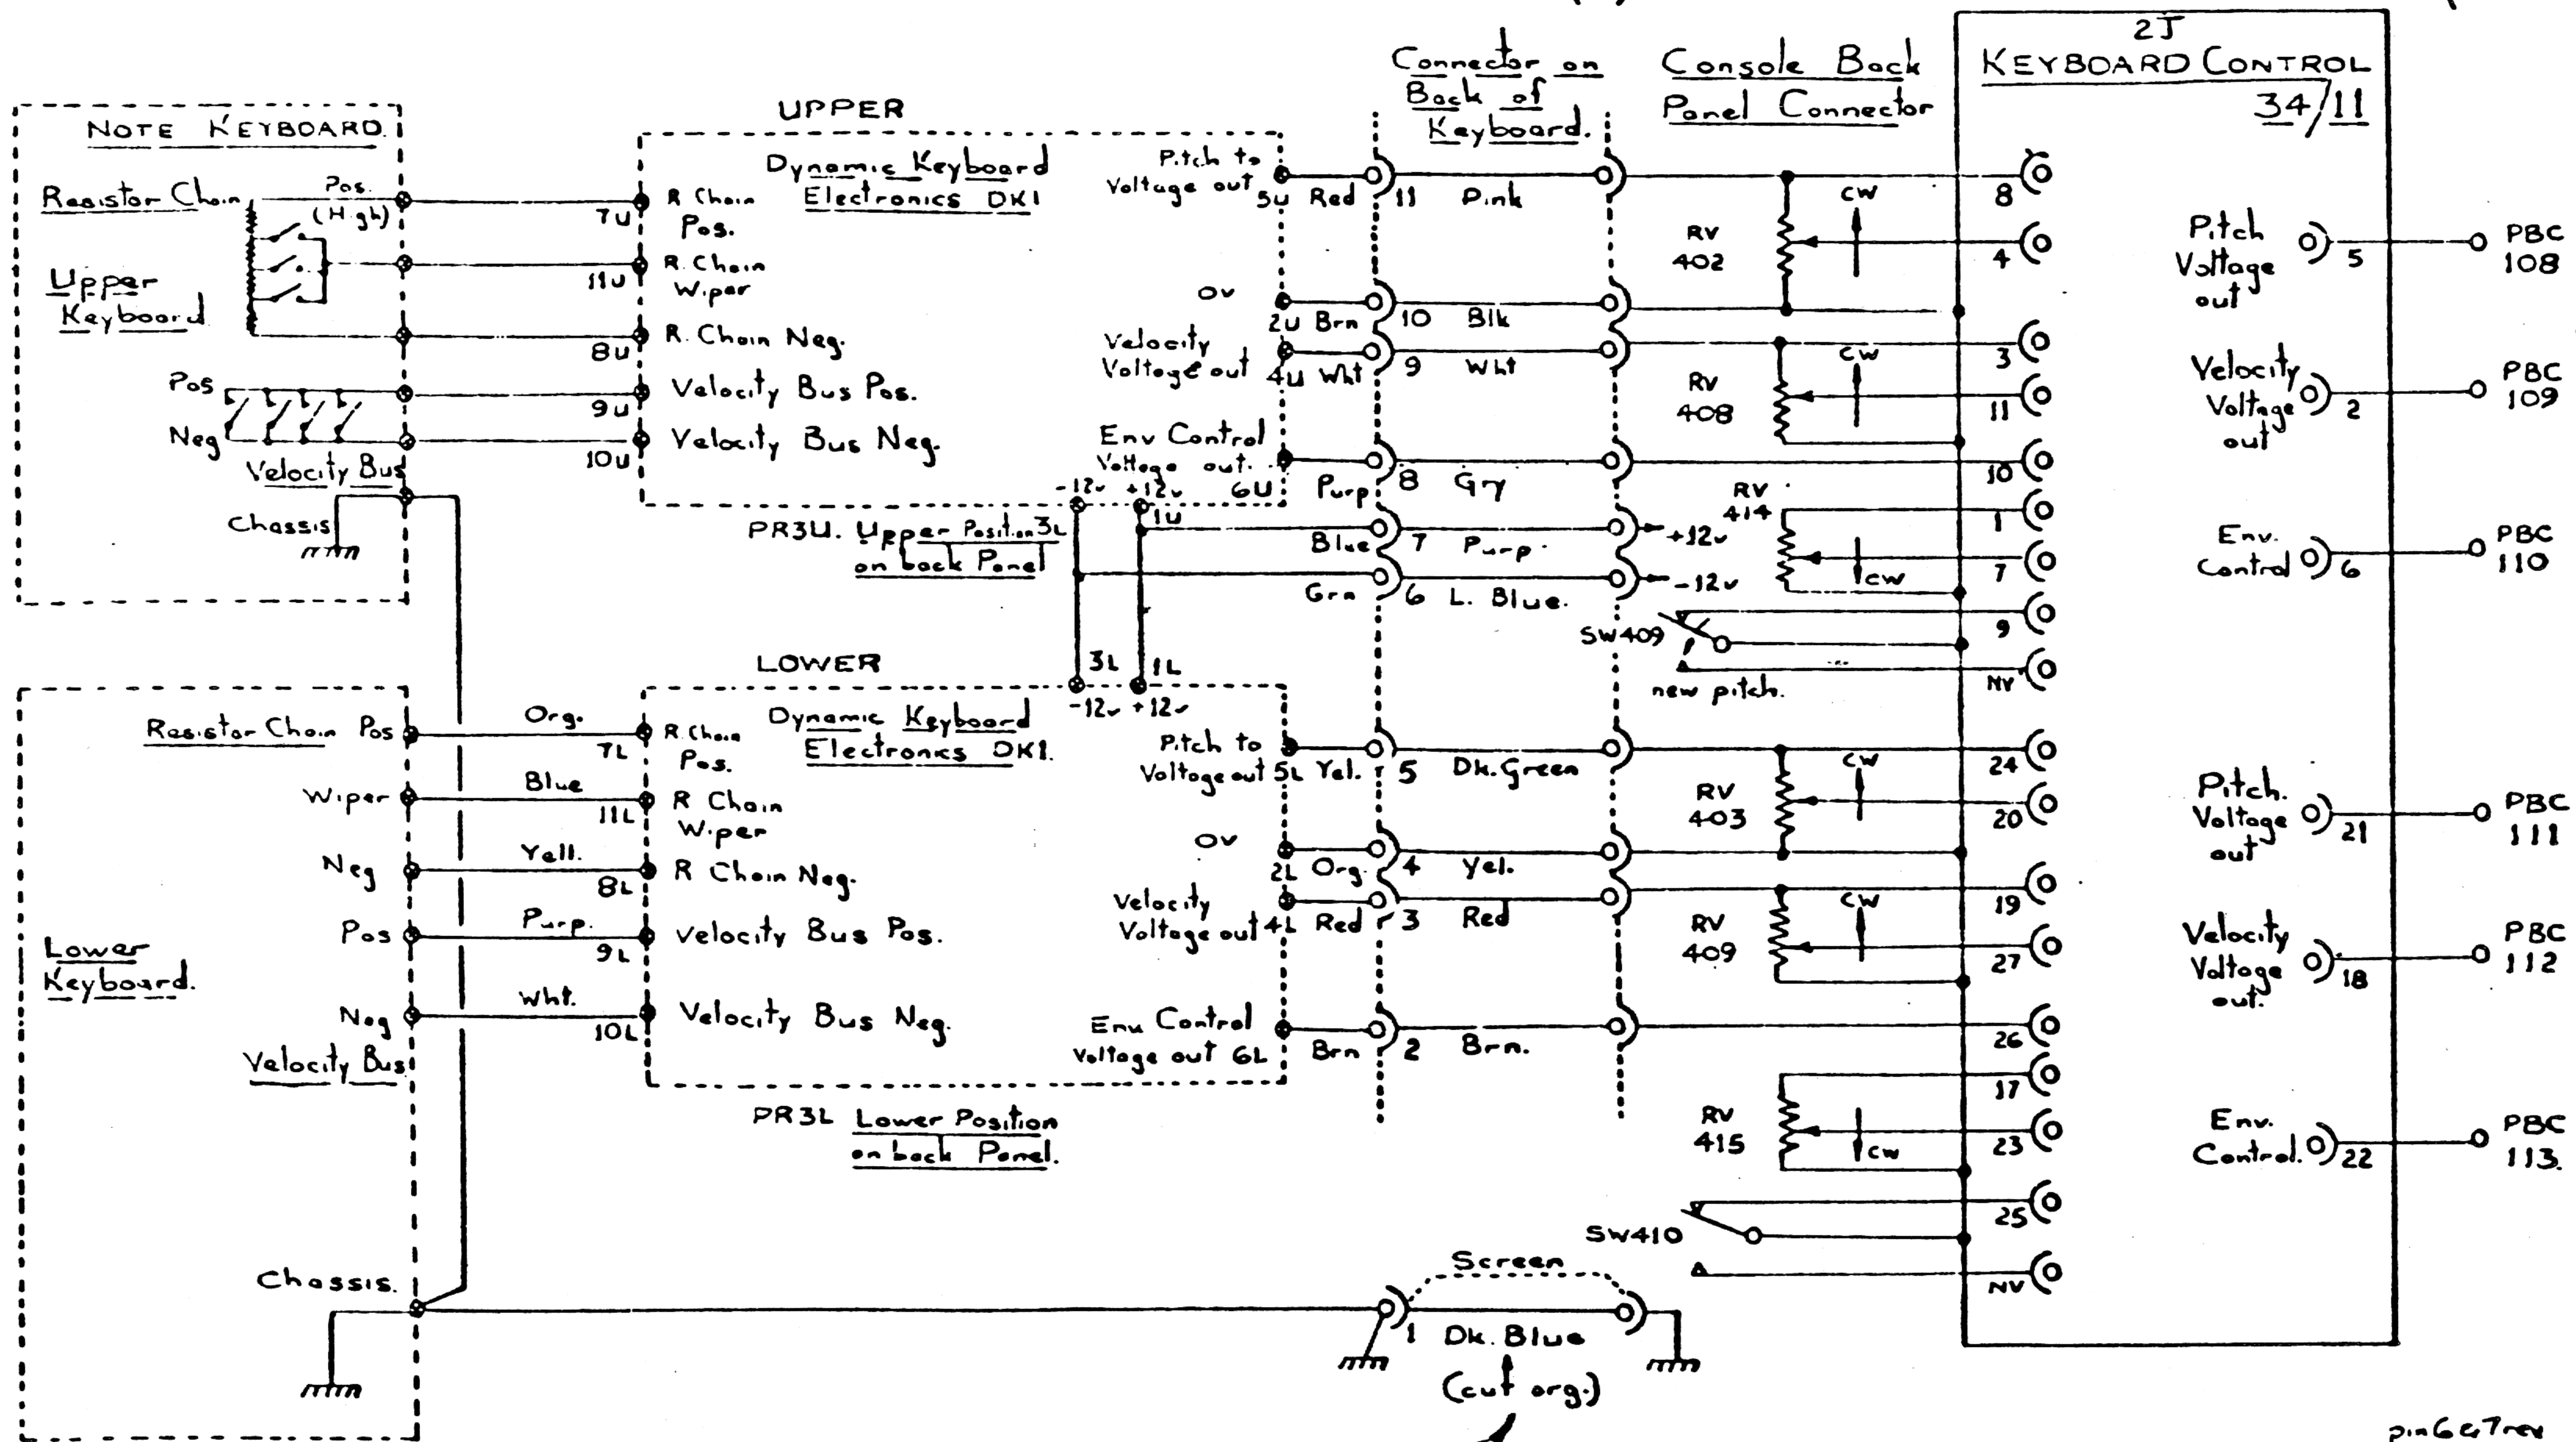


UMBILICAL CONNECTION.

- | | |
|--------------|---------|
| 1 L. Green. | 7 Purp. |
| 2 Brn. | 8 Gray |
| 3 Red | 9 Wht. |
| 4 Yel. | 10 Blk |
| 5 Dk. Green. | 11 Pink |
| 6 Blue | 12 Org |

12-17 Connected @ plug (kbd) to floating leads pin 18 floating

pin 6 & 7 rev
8 70/23.8.71.


ELECTRONIC MUSIC STUDIOS (Bournemouth) Ltd		issue A
MATL	TITLE <u>KEYBOARD CONTROL</u>	Drg No
FINISH	USED ON <u>SYNTHI 100 KEYBOARD</u>	<u>31/23.</u>
TOL	Frac	Dr
Ang's	SCALE	CHKD
DATE	DATE	DATE

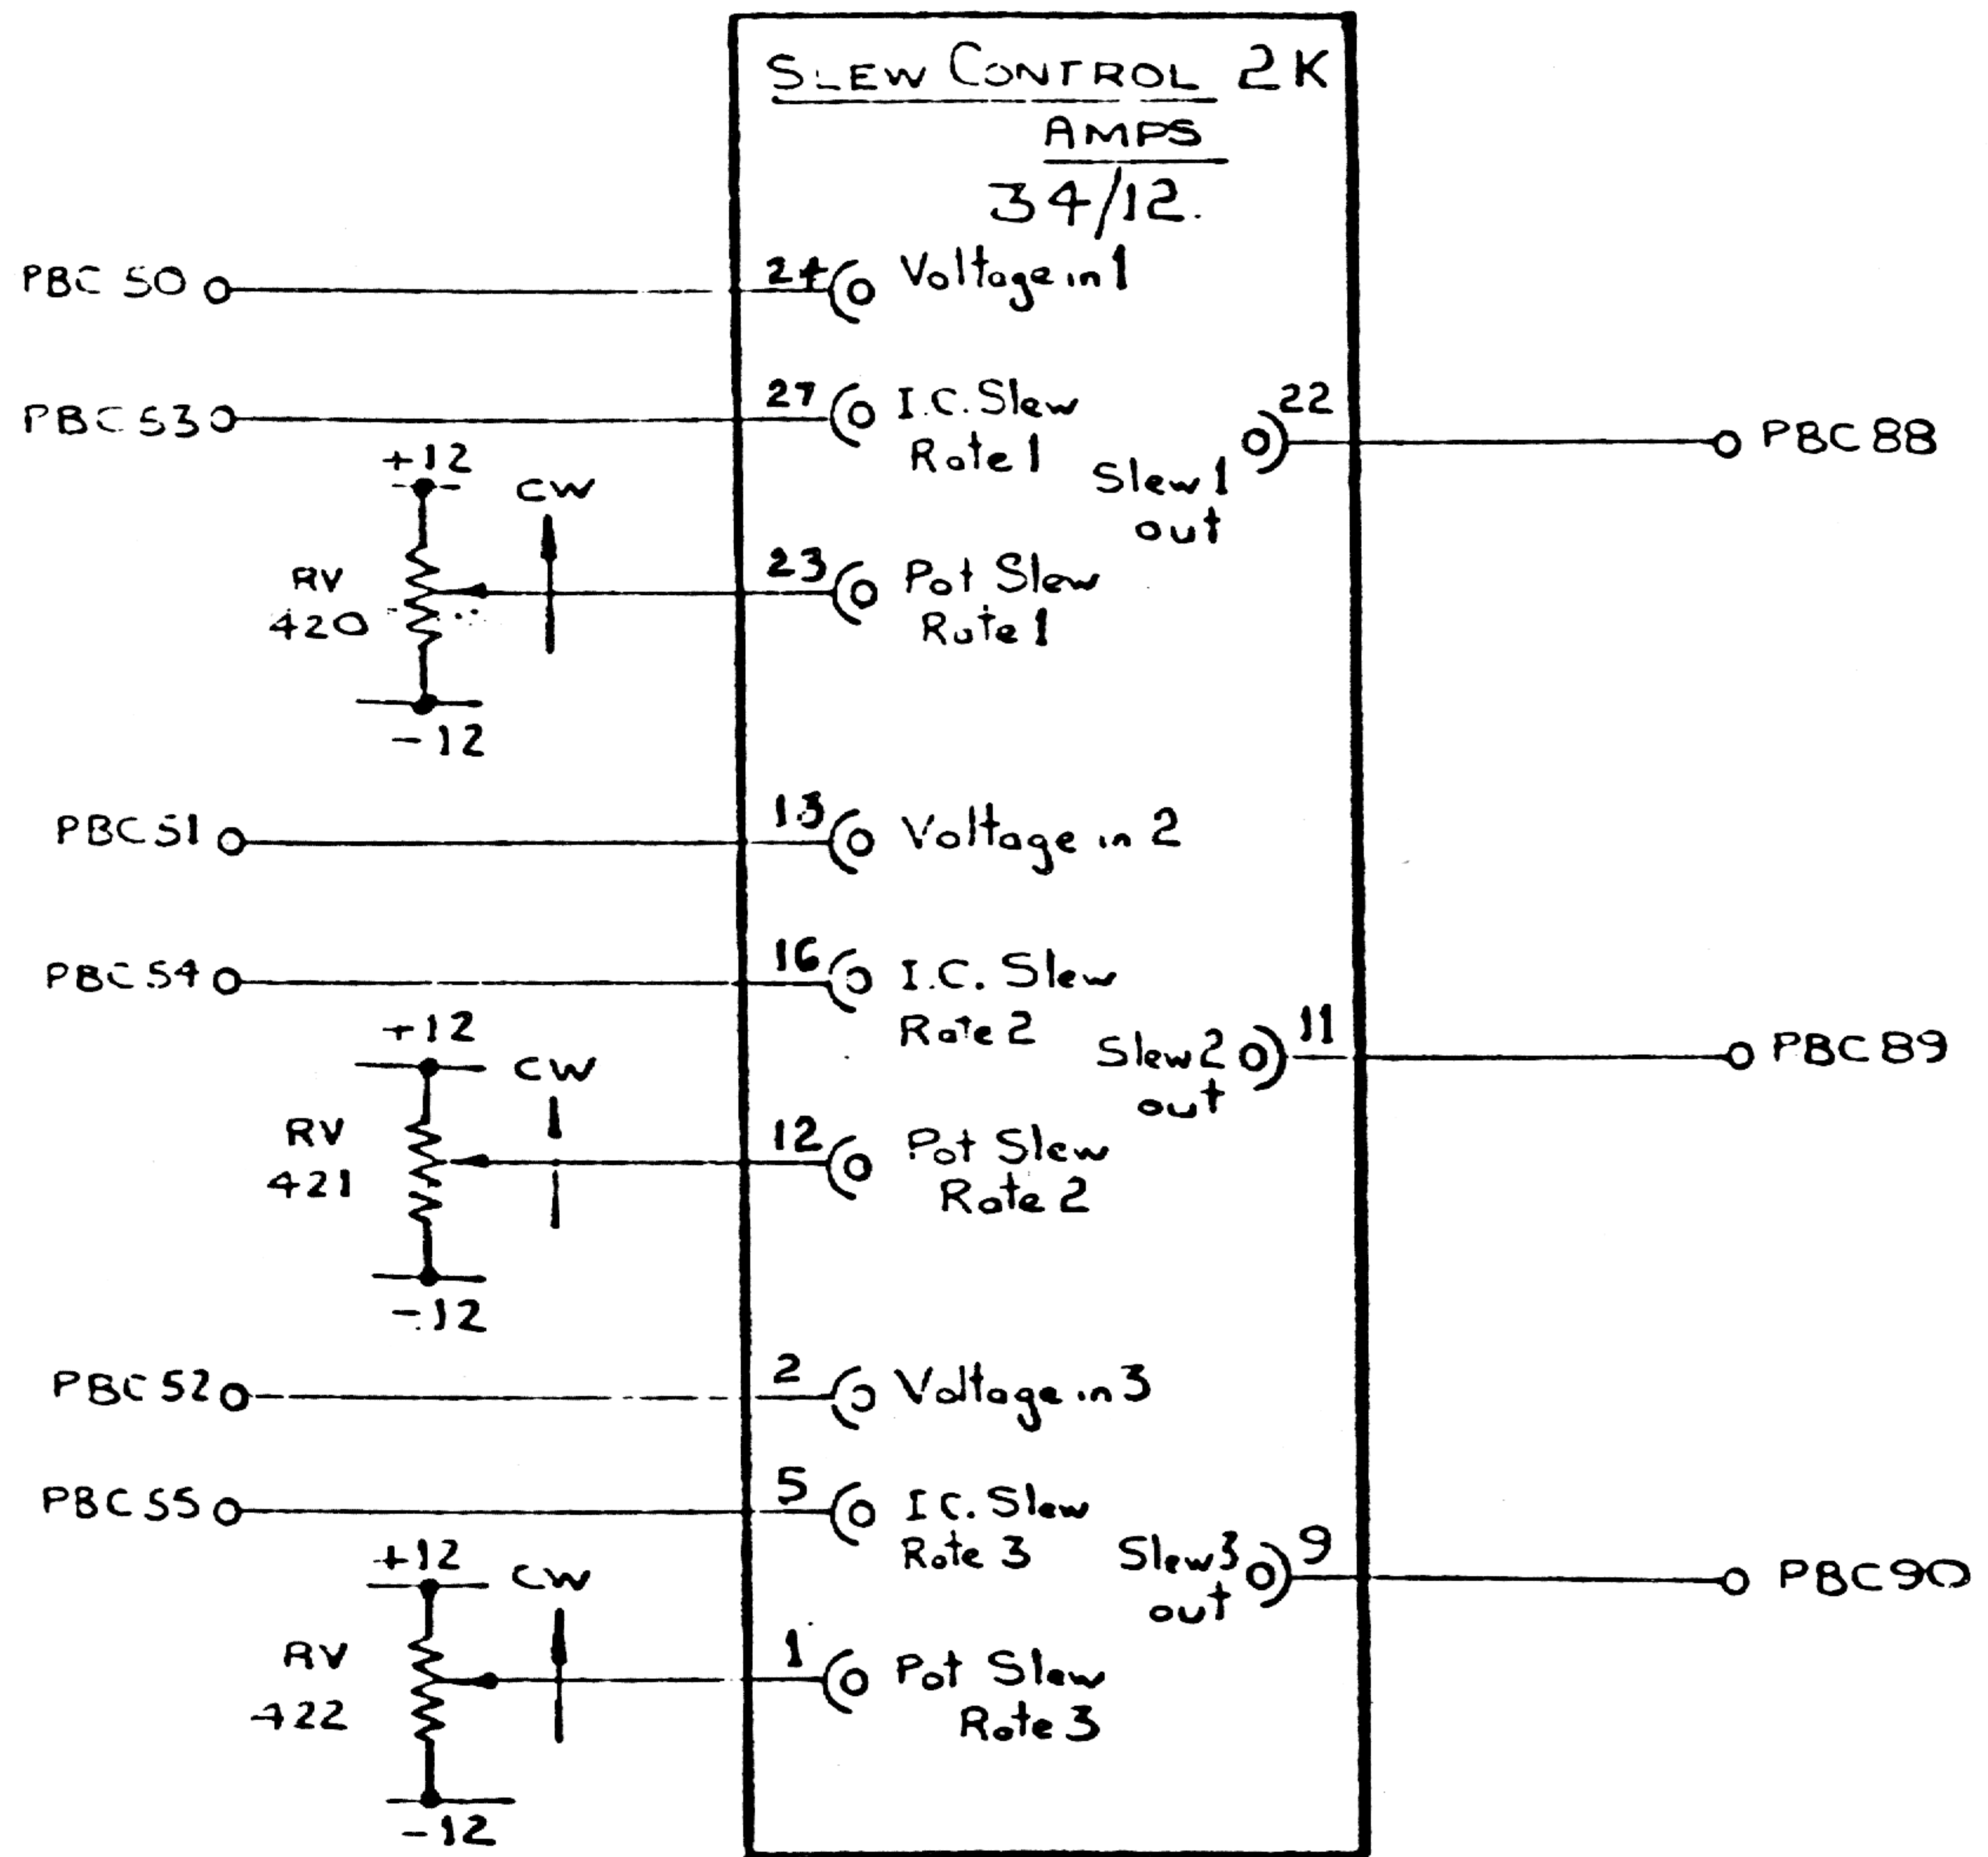

ELECTRONIC MUSIC STUDIOS (Bournemouth) Ltd		issue A
MATL	TITLE <u>MODULE WIRING</u> <u>SLEW LIMITERS 1,2,3</u>	Drg NO <u>31/24.</u>
FINISH	USED ON <u>SYNTHI 100.</u>	
TOL	Frac / Div	Angles
SCALE	CHND	DATE
		DWN <u>7/11</u> DATE <u>16.6.71</u>


PL3 d.d read PL2
 PL2 " " PL3
 26 7 71
 C NOs Added
 21 11 72
 RV517

ELECTRONIC MUSIC STUDIOS LTD.
 OUTPUT CHANNELS 1 TO 4.
 DRN # 9. 7. 71. ISSUE A. B. 31/25.




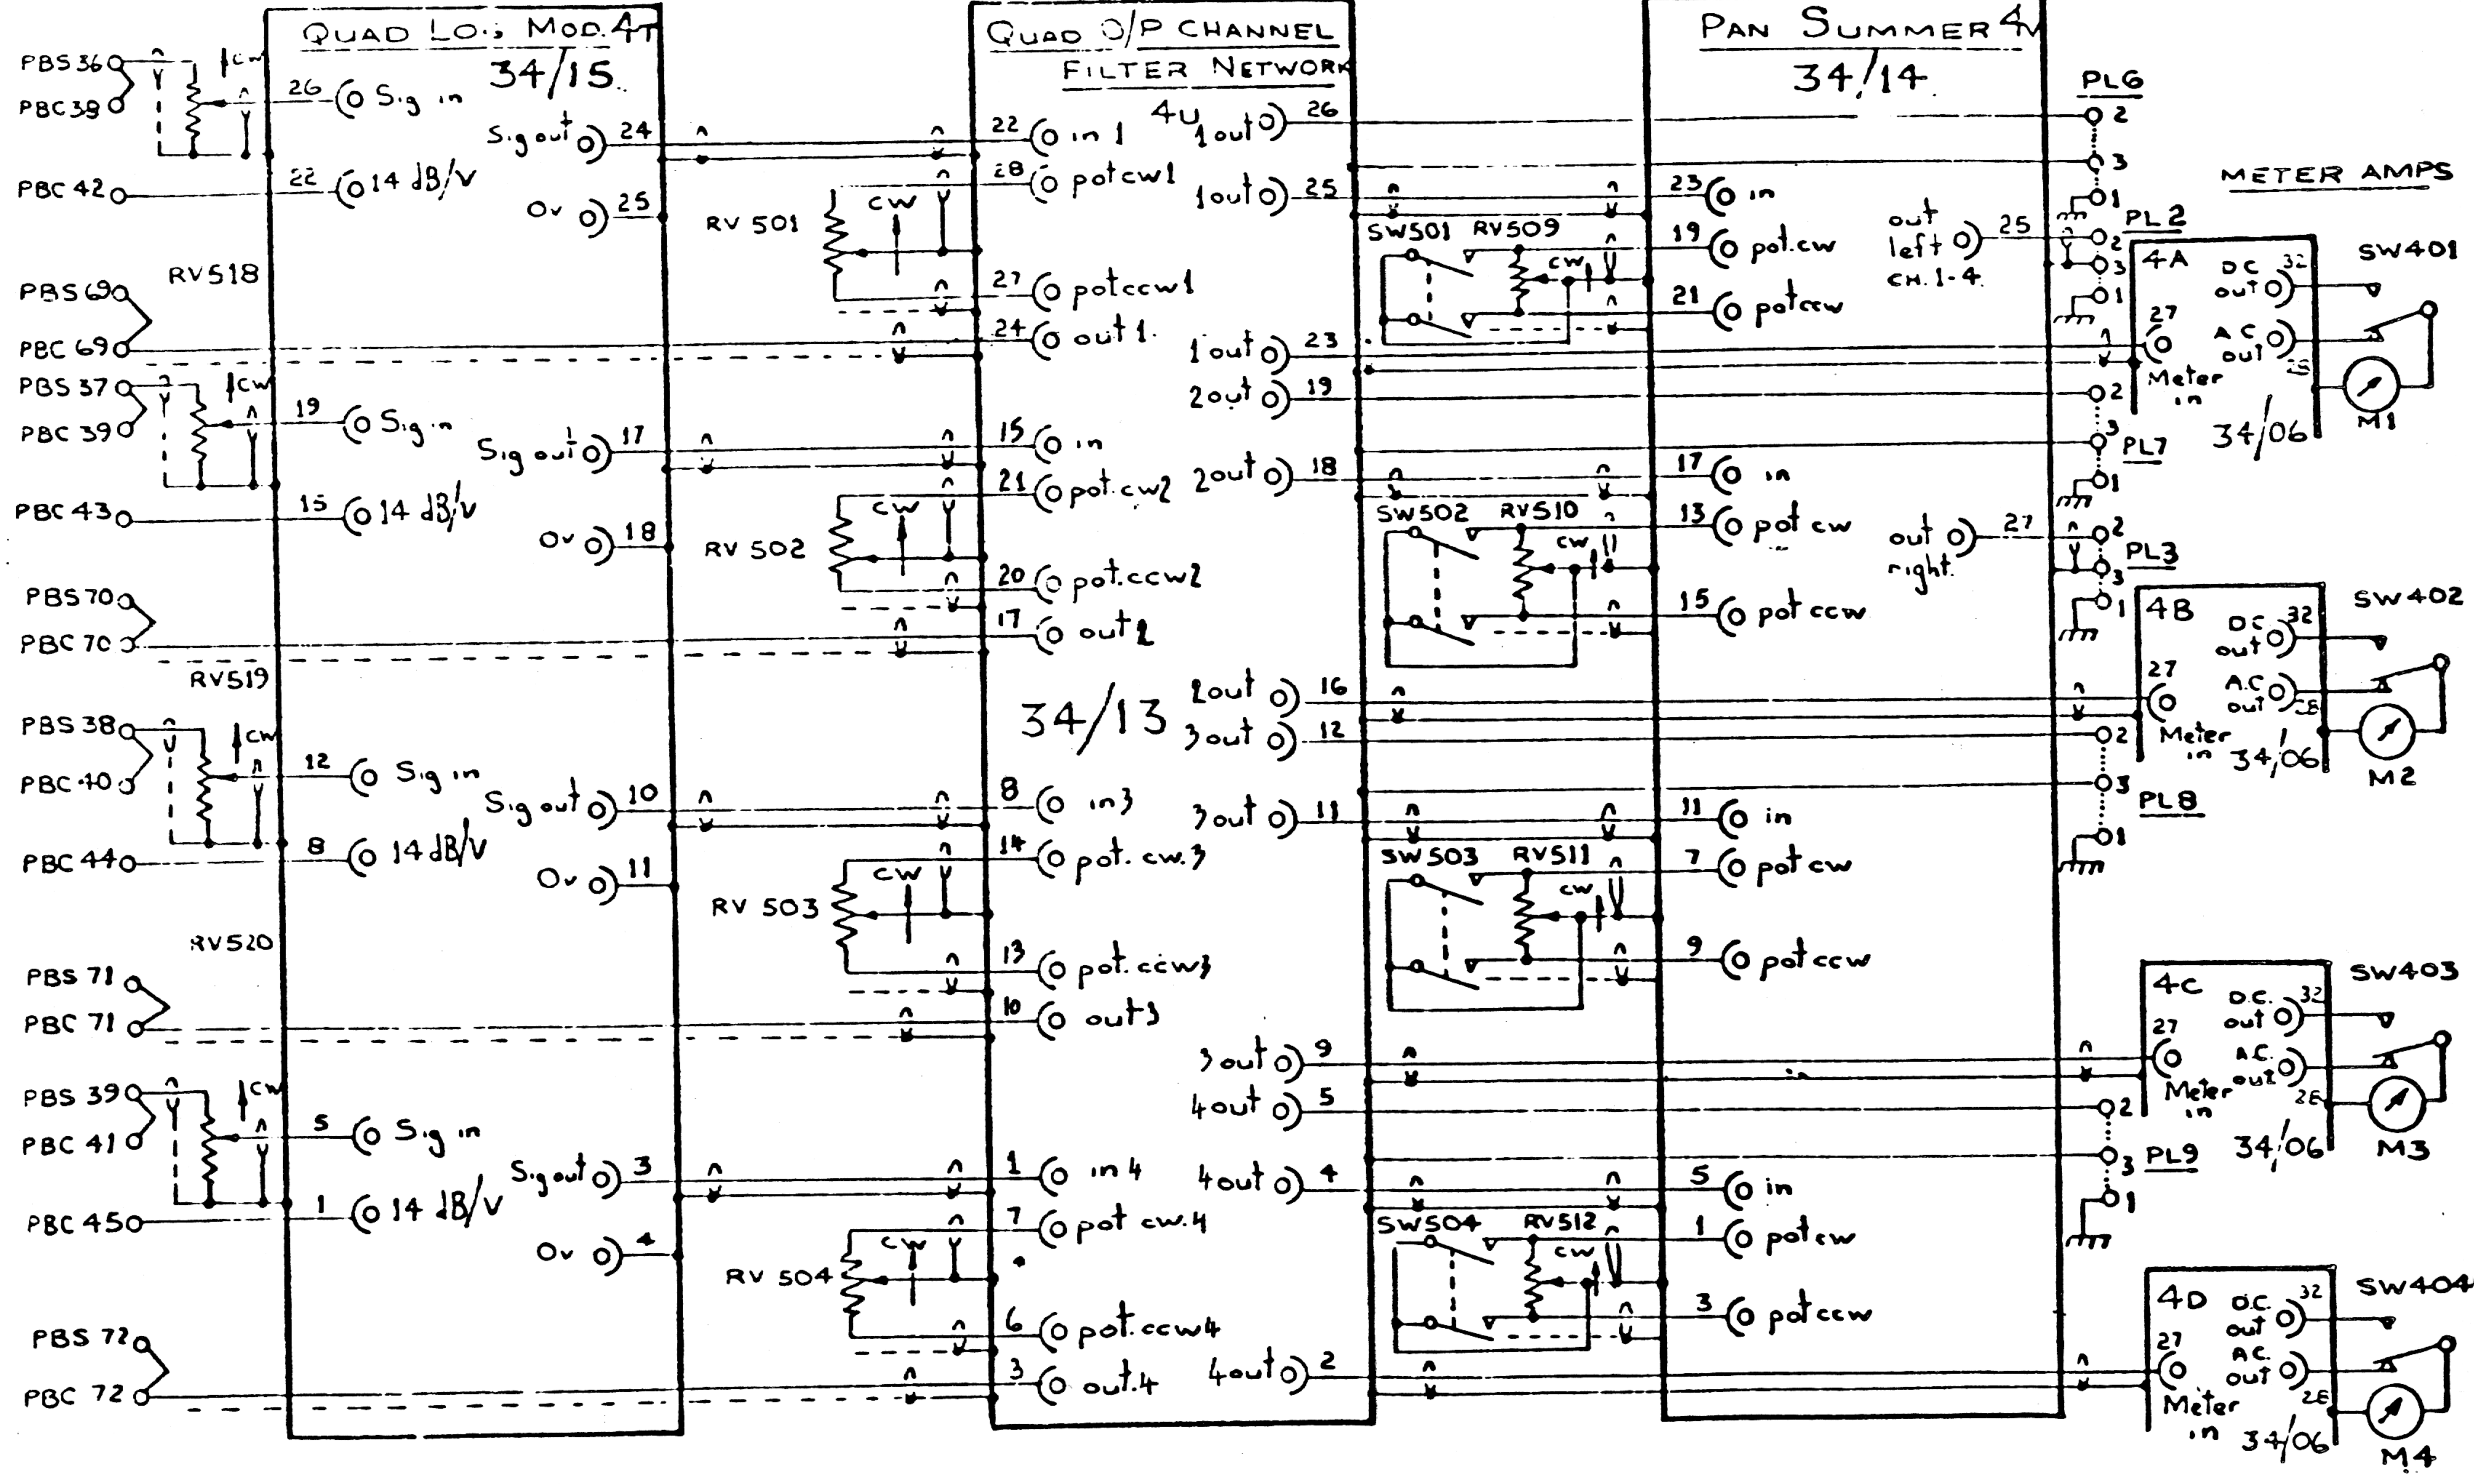


B PLS did read PL4
 PL4 " " PL5
 26.7.71.
 P.C.B No change
 21.11.72.
 RVS21


ELECTRONIC MUSIC STUDIOS LTD
 OUTPUT CHANNEL 5-8
 DRN 9.7.71. ISSUE 31/26

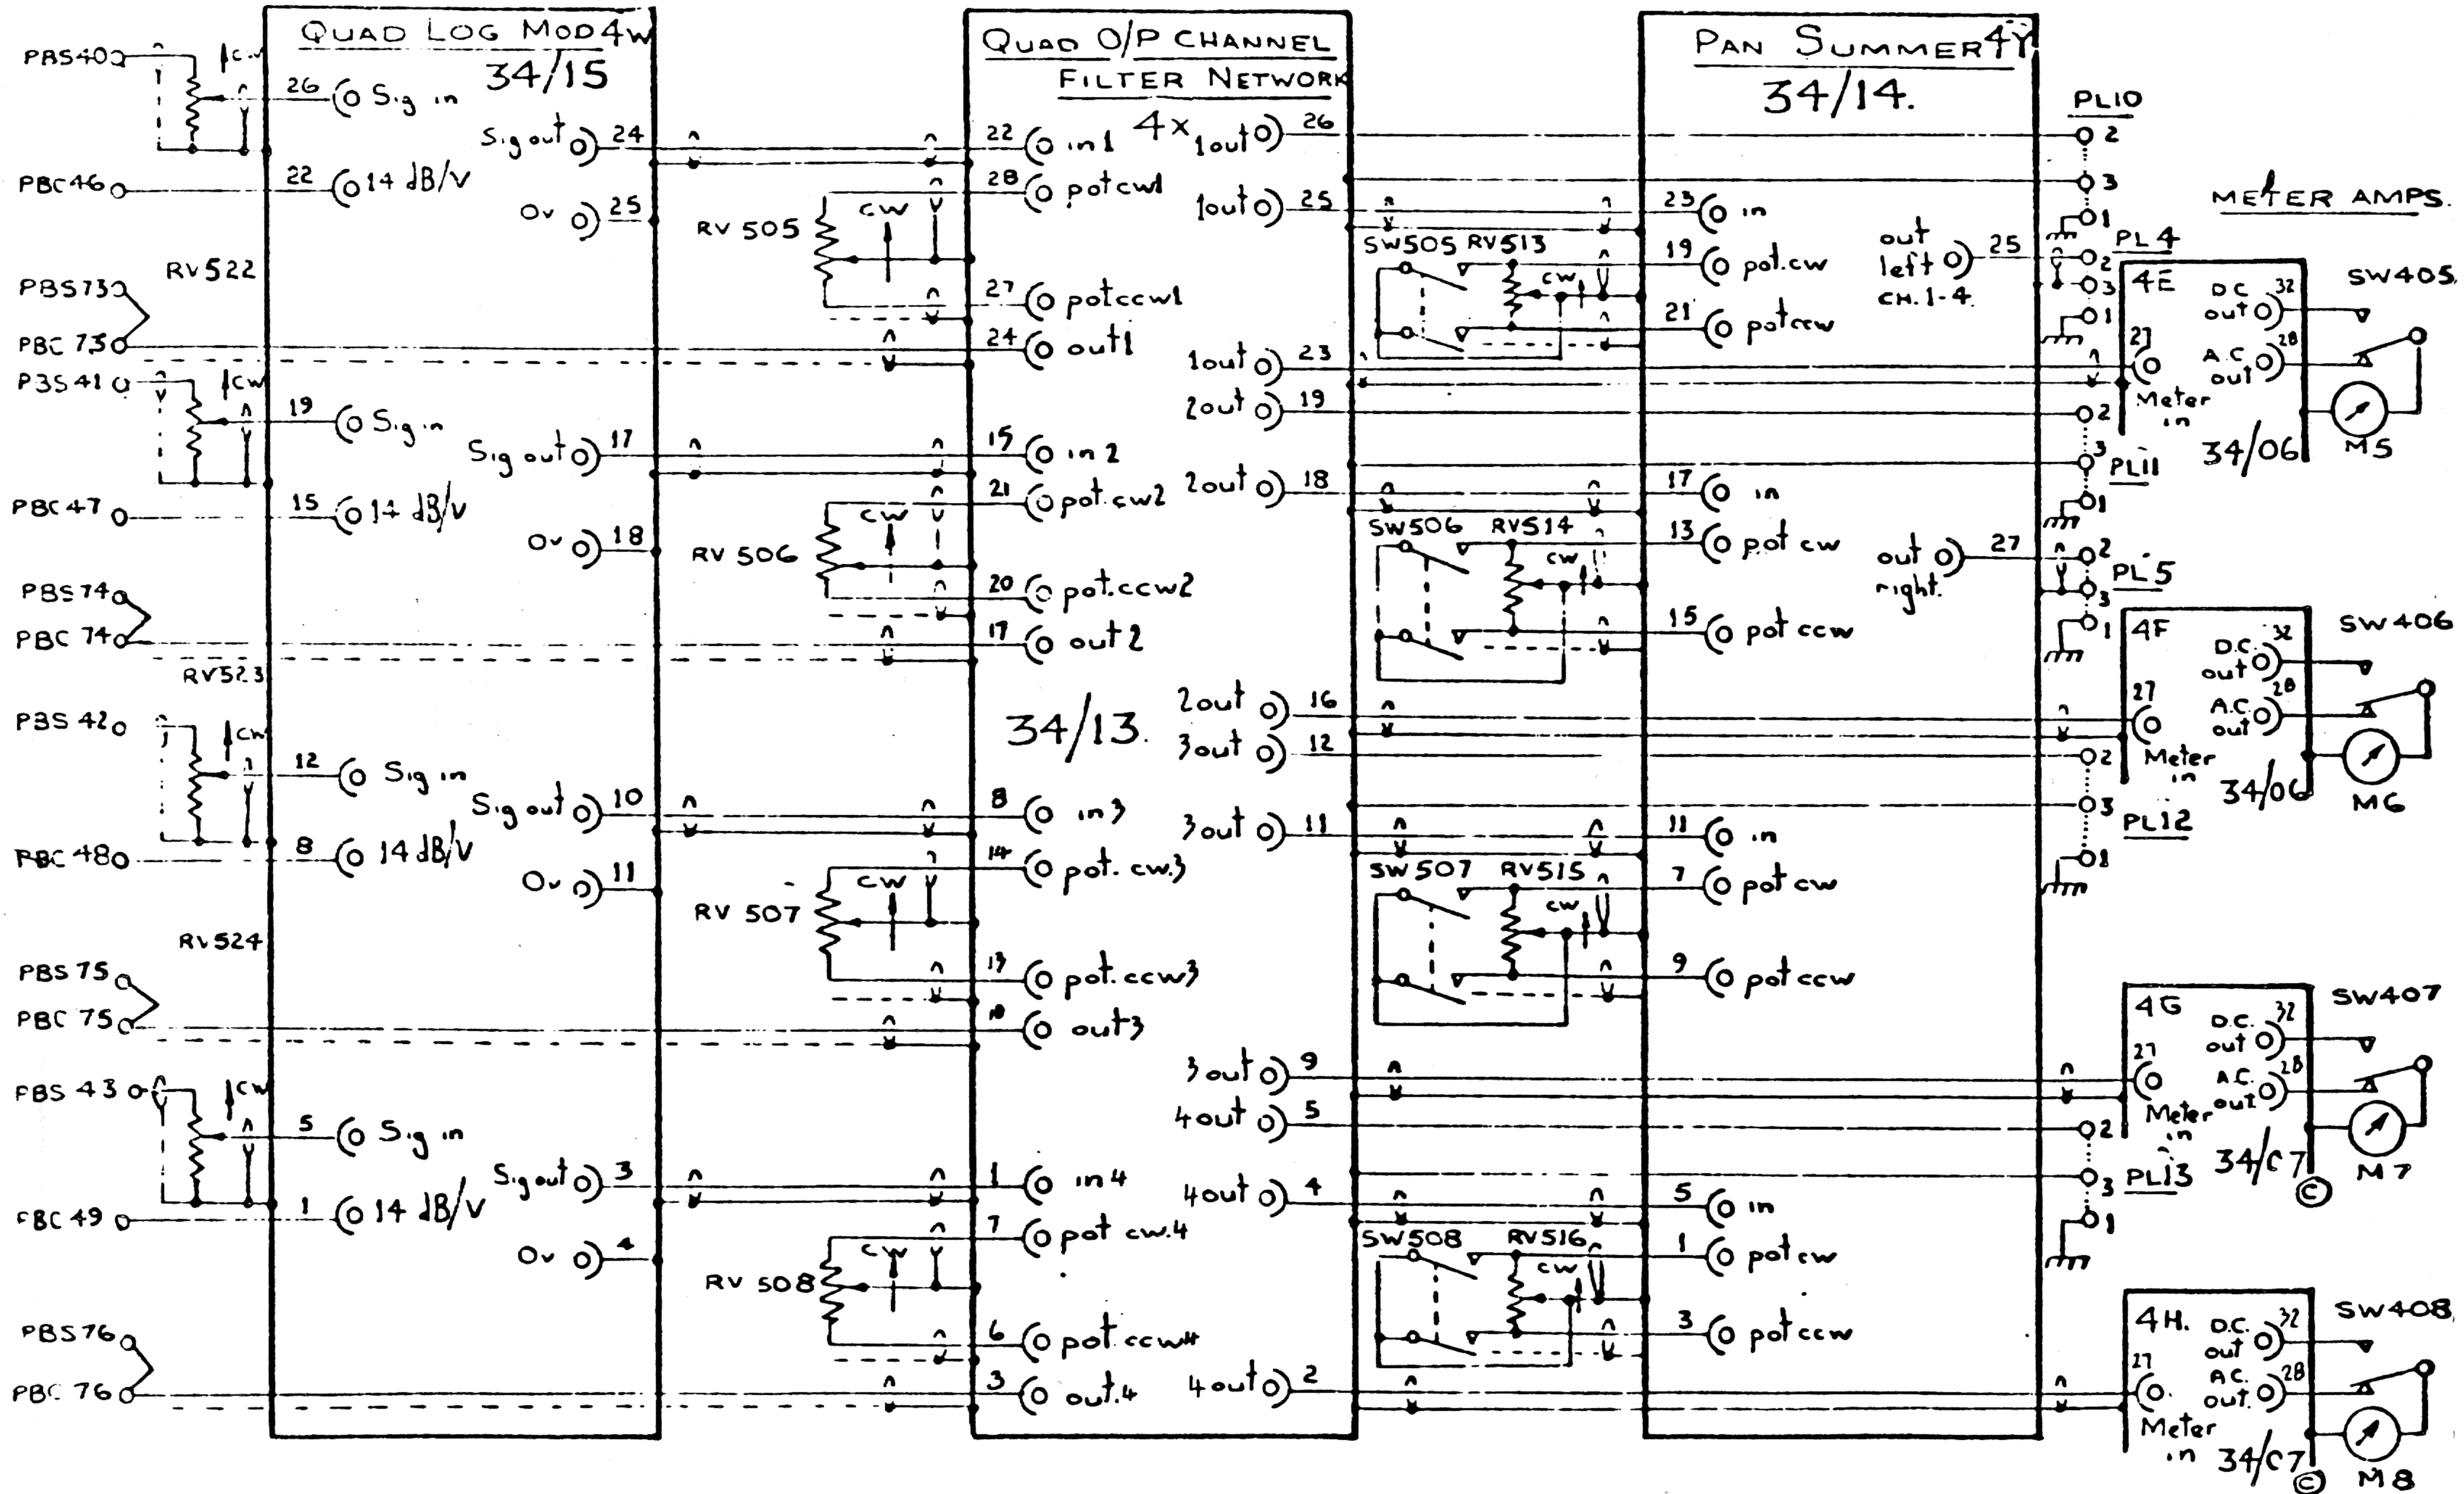

Sequencer Digital
C.D. 3

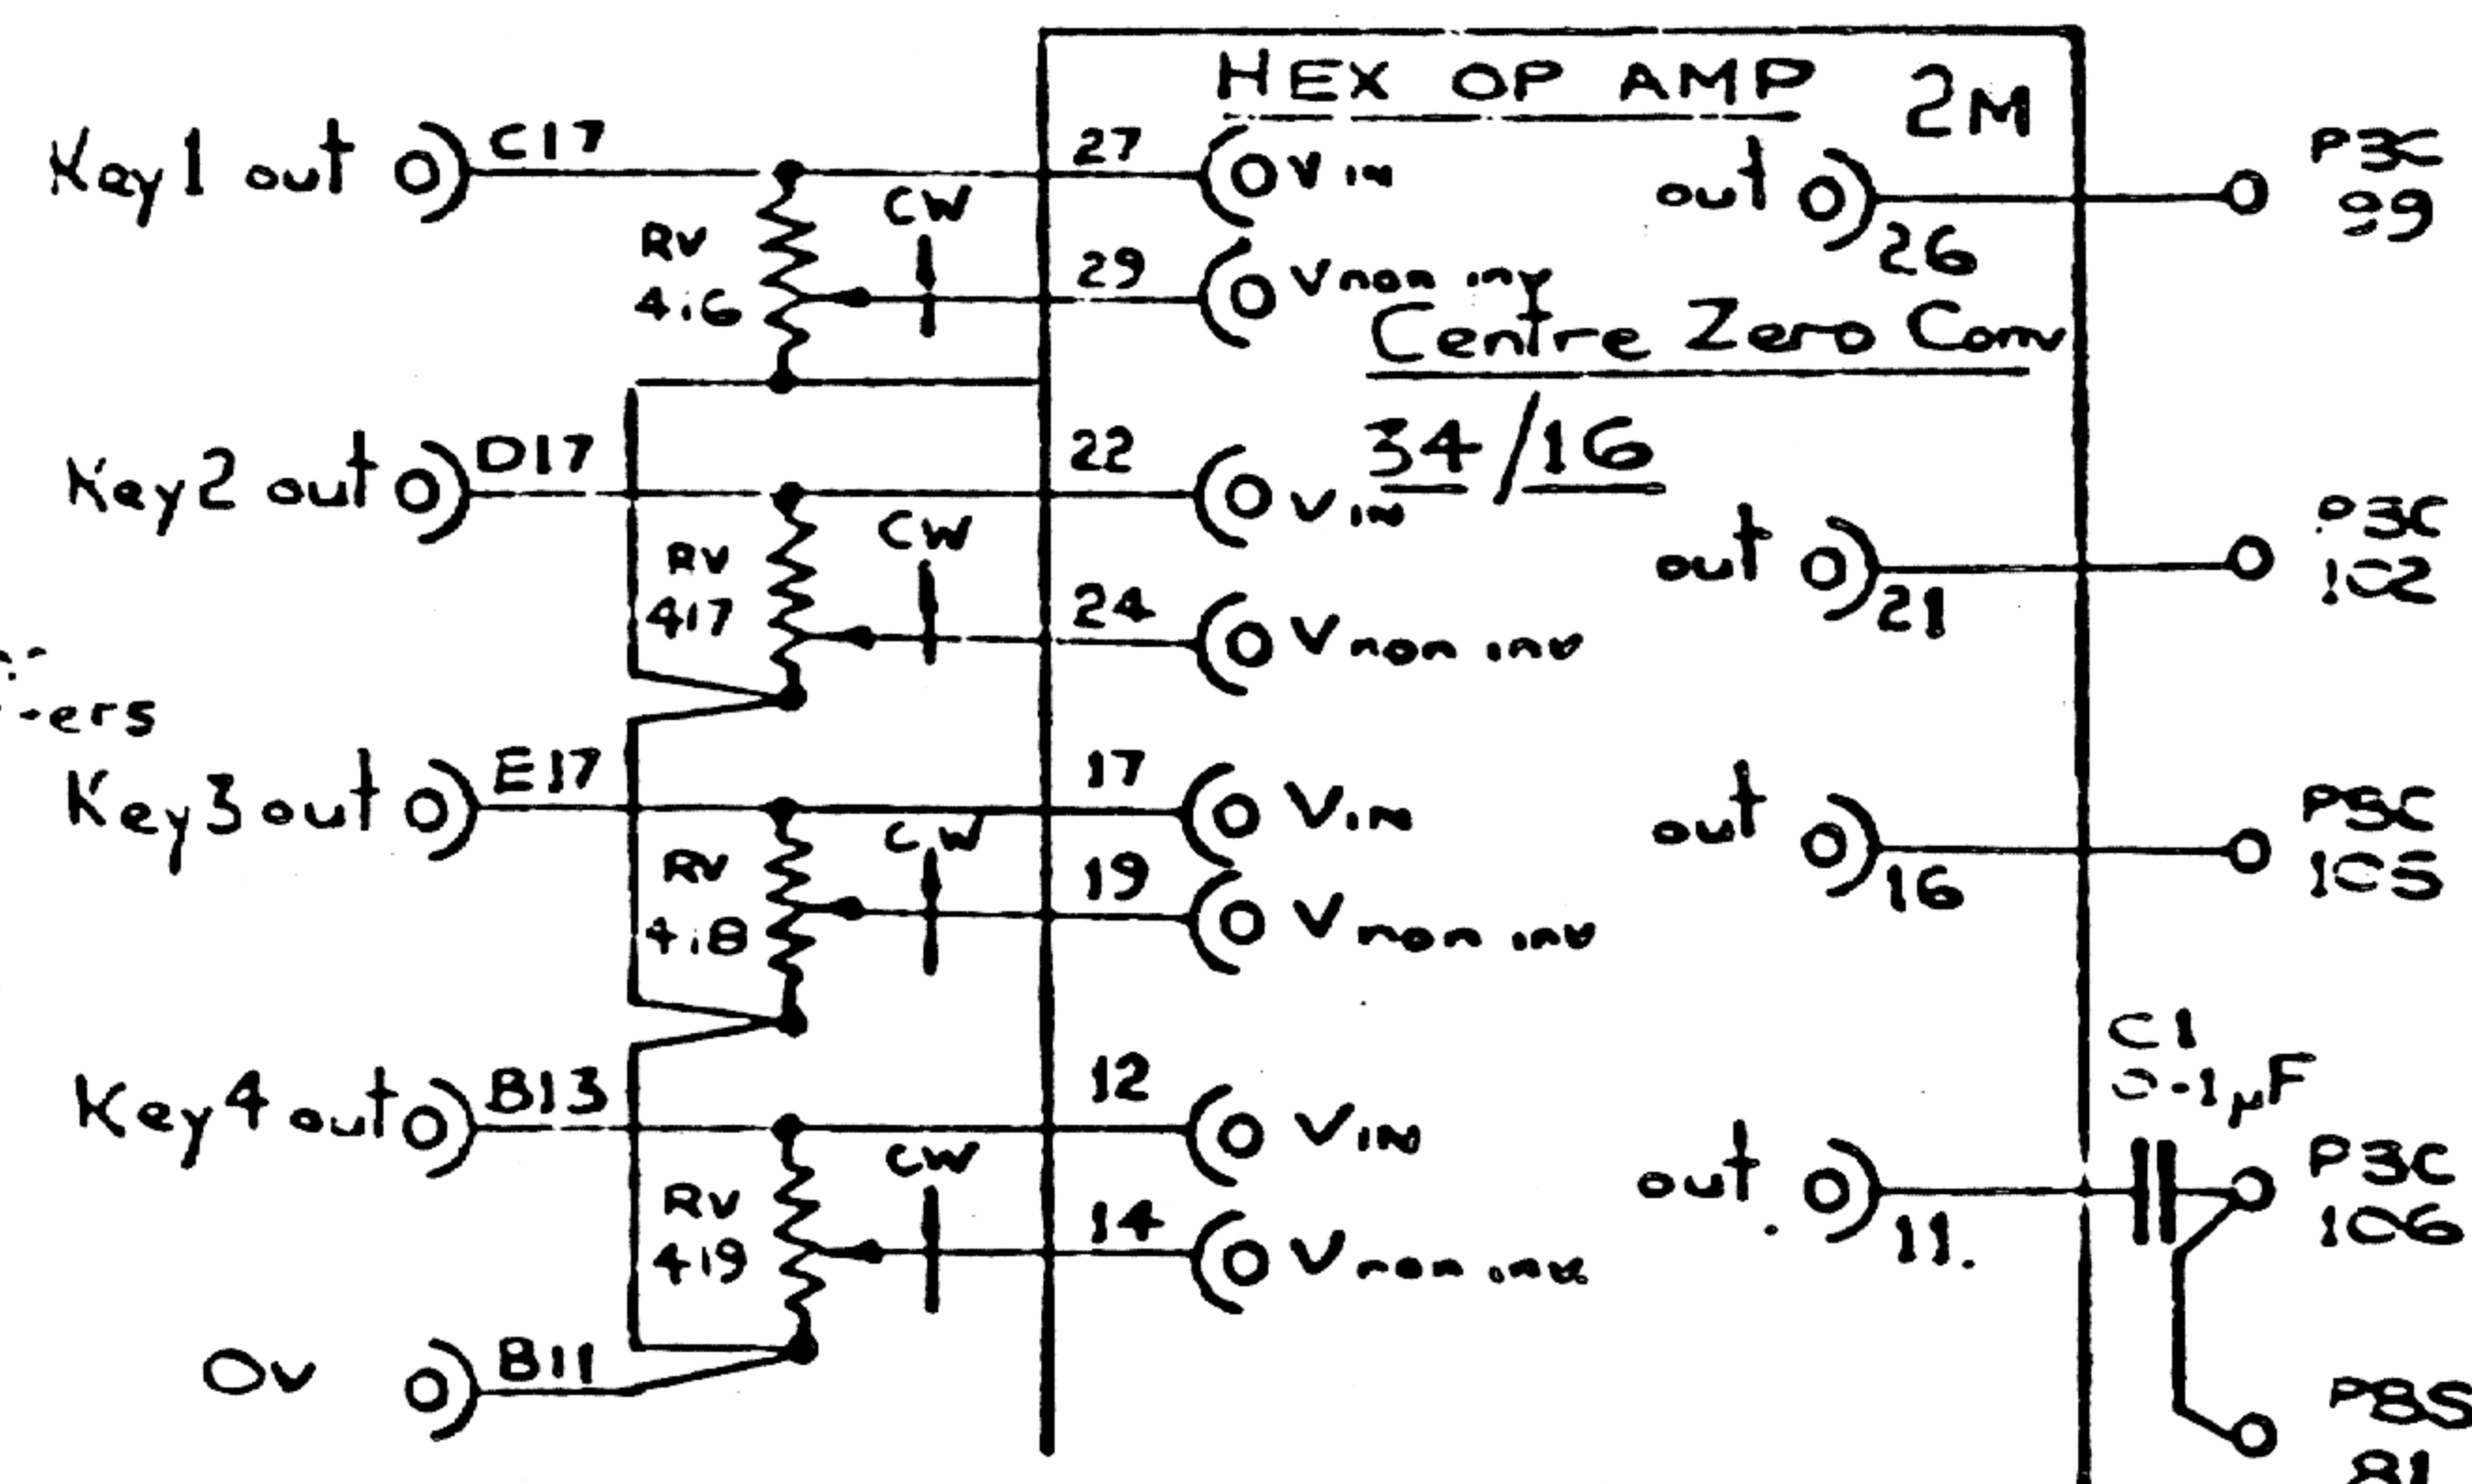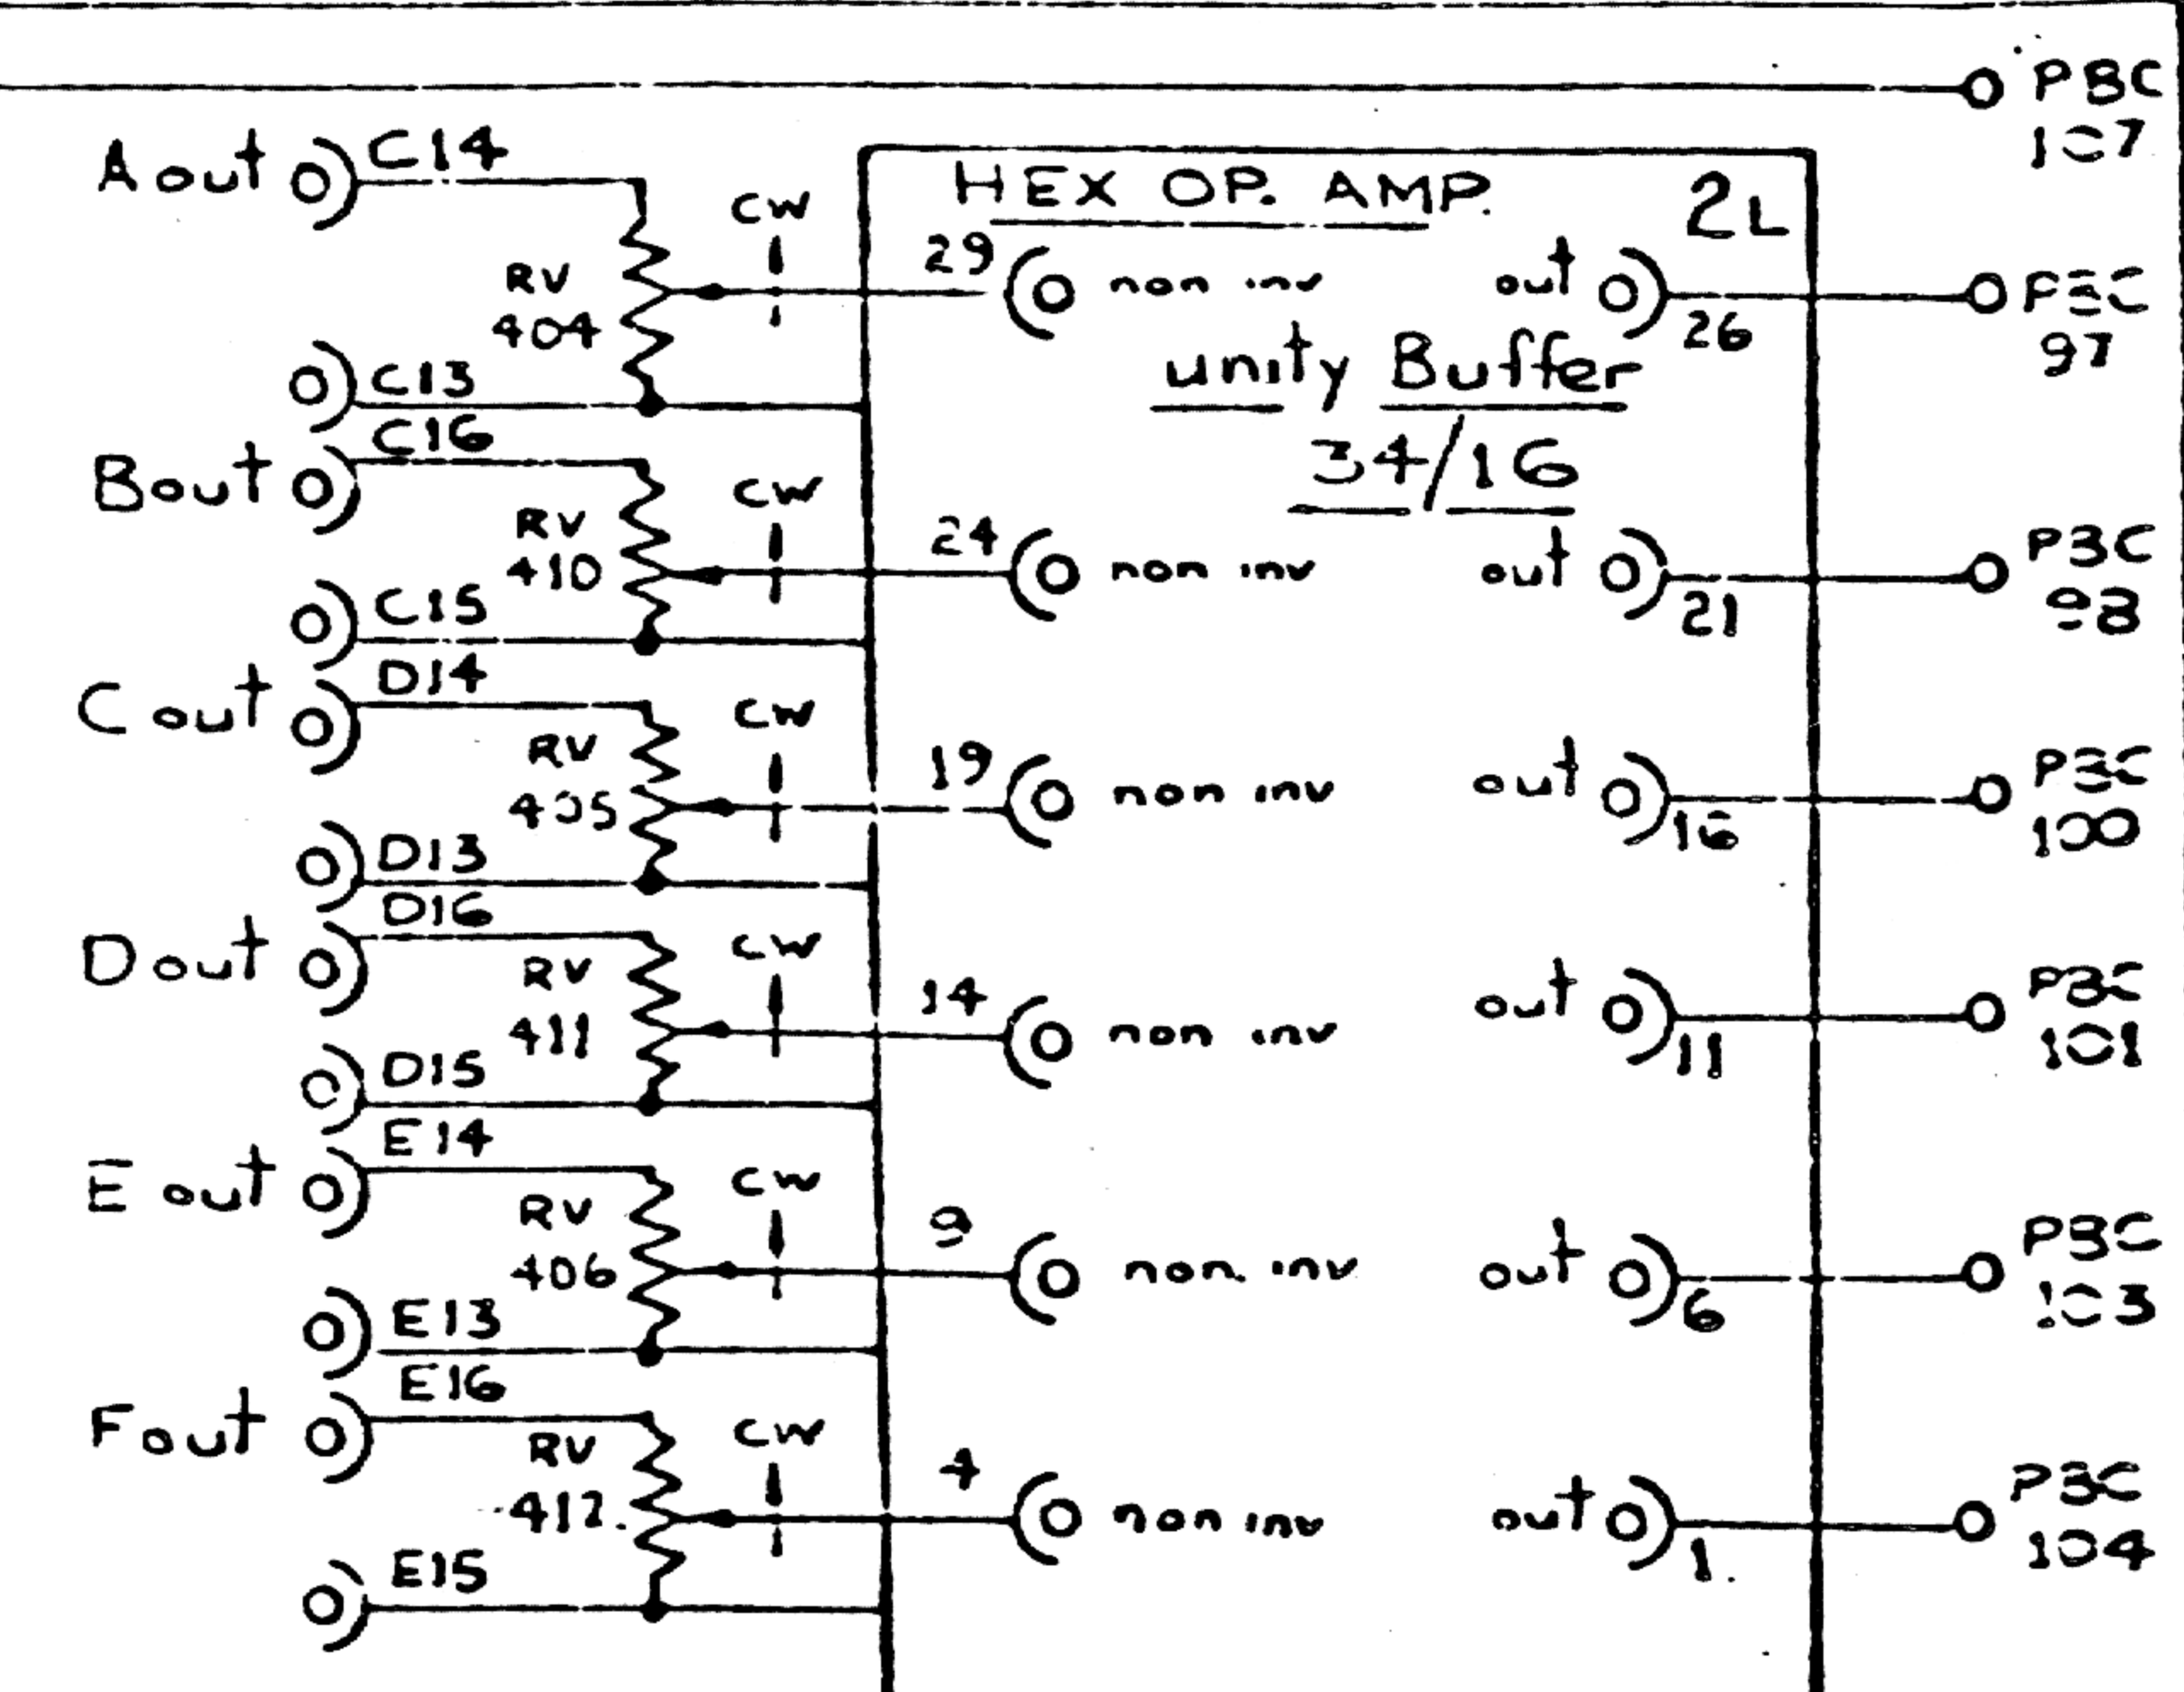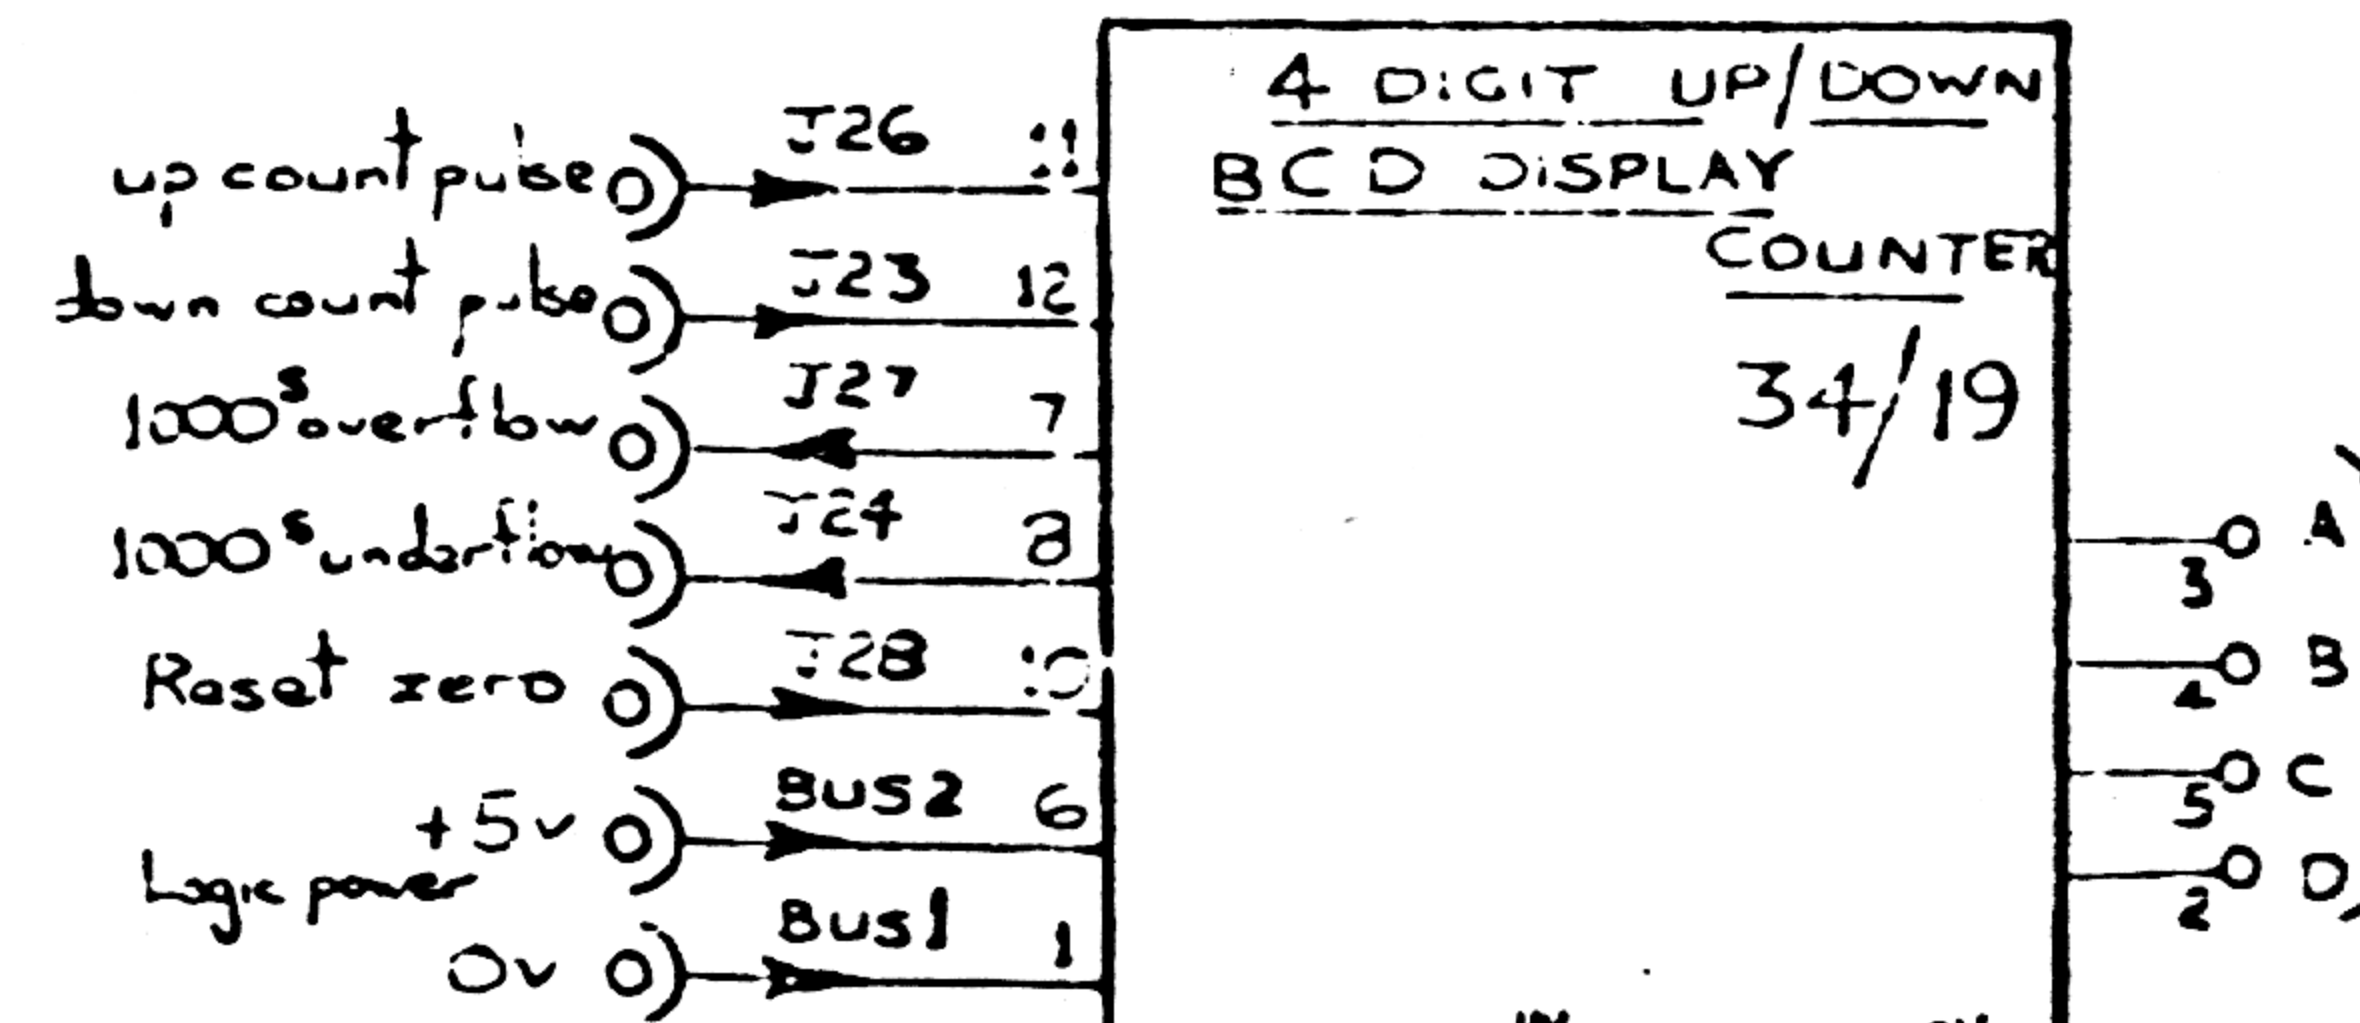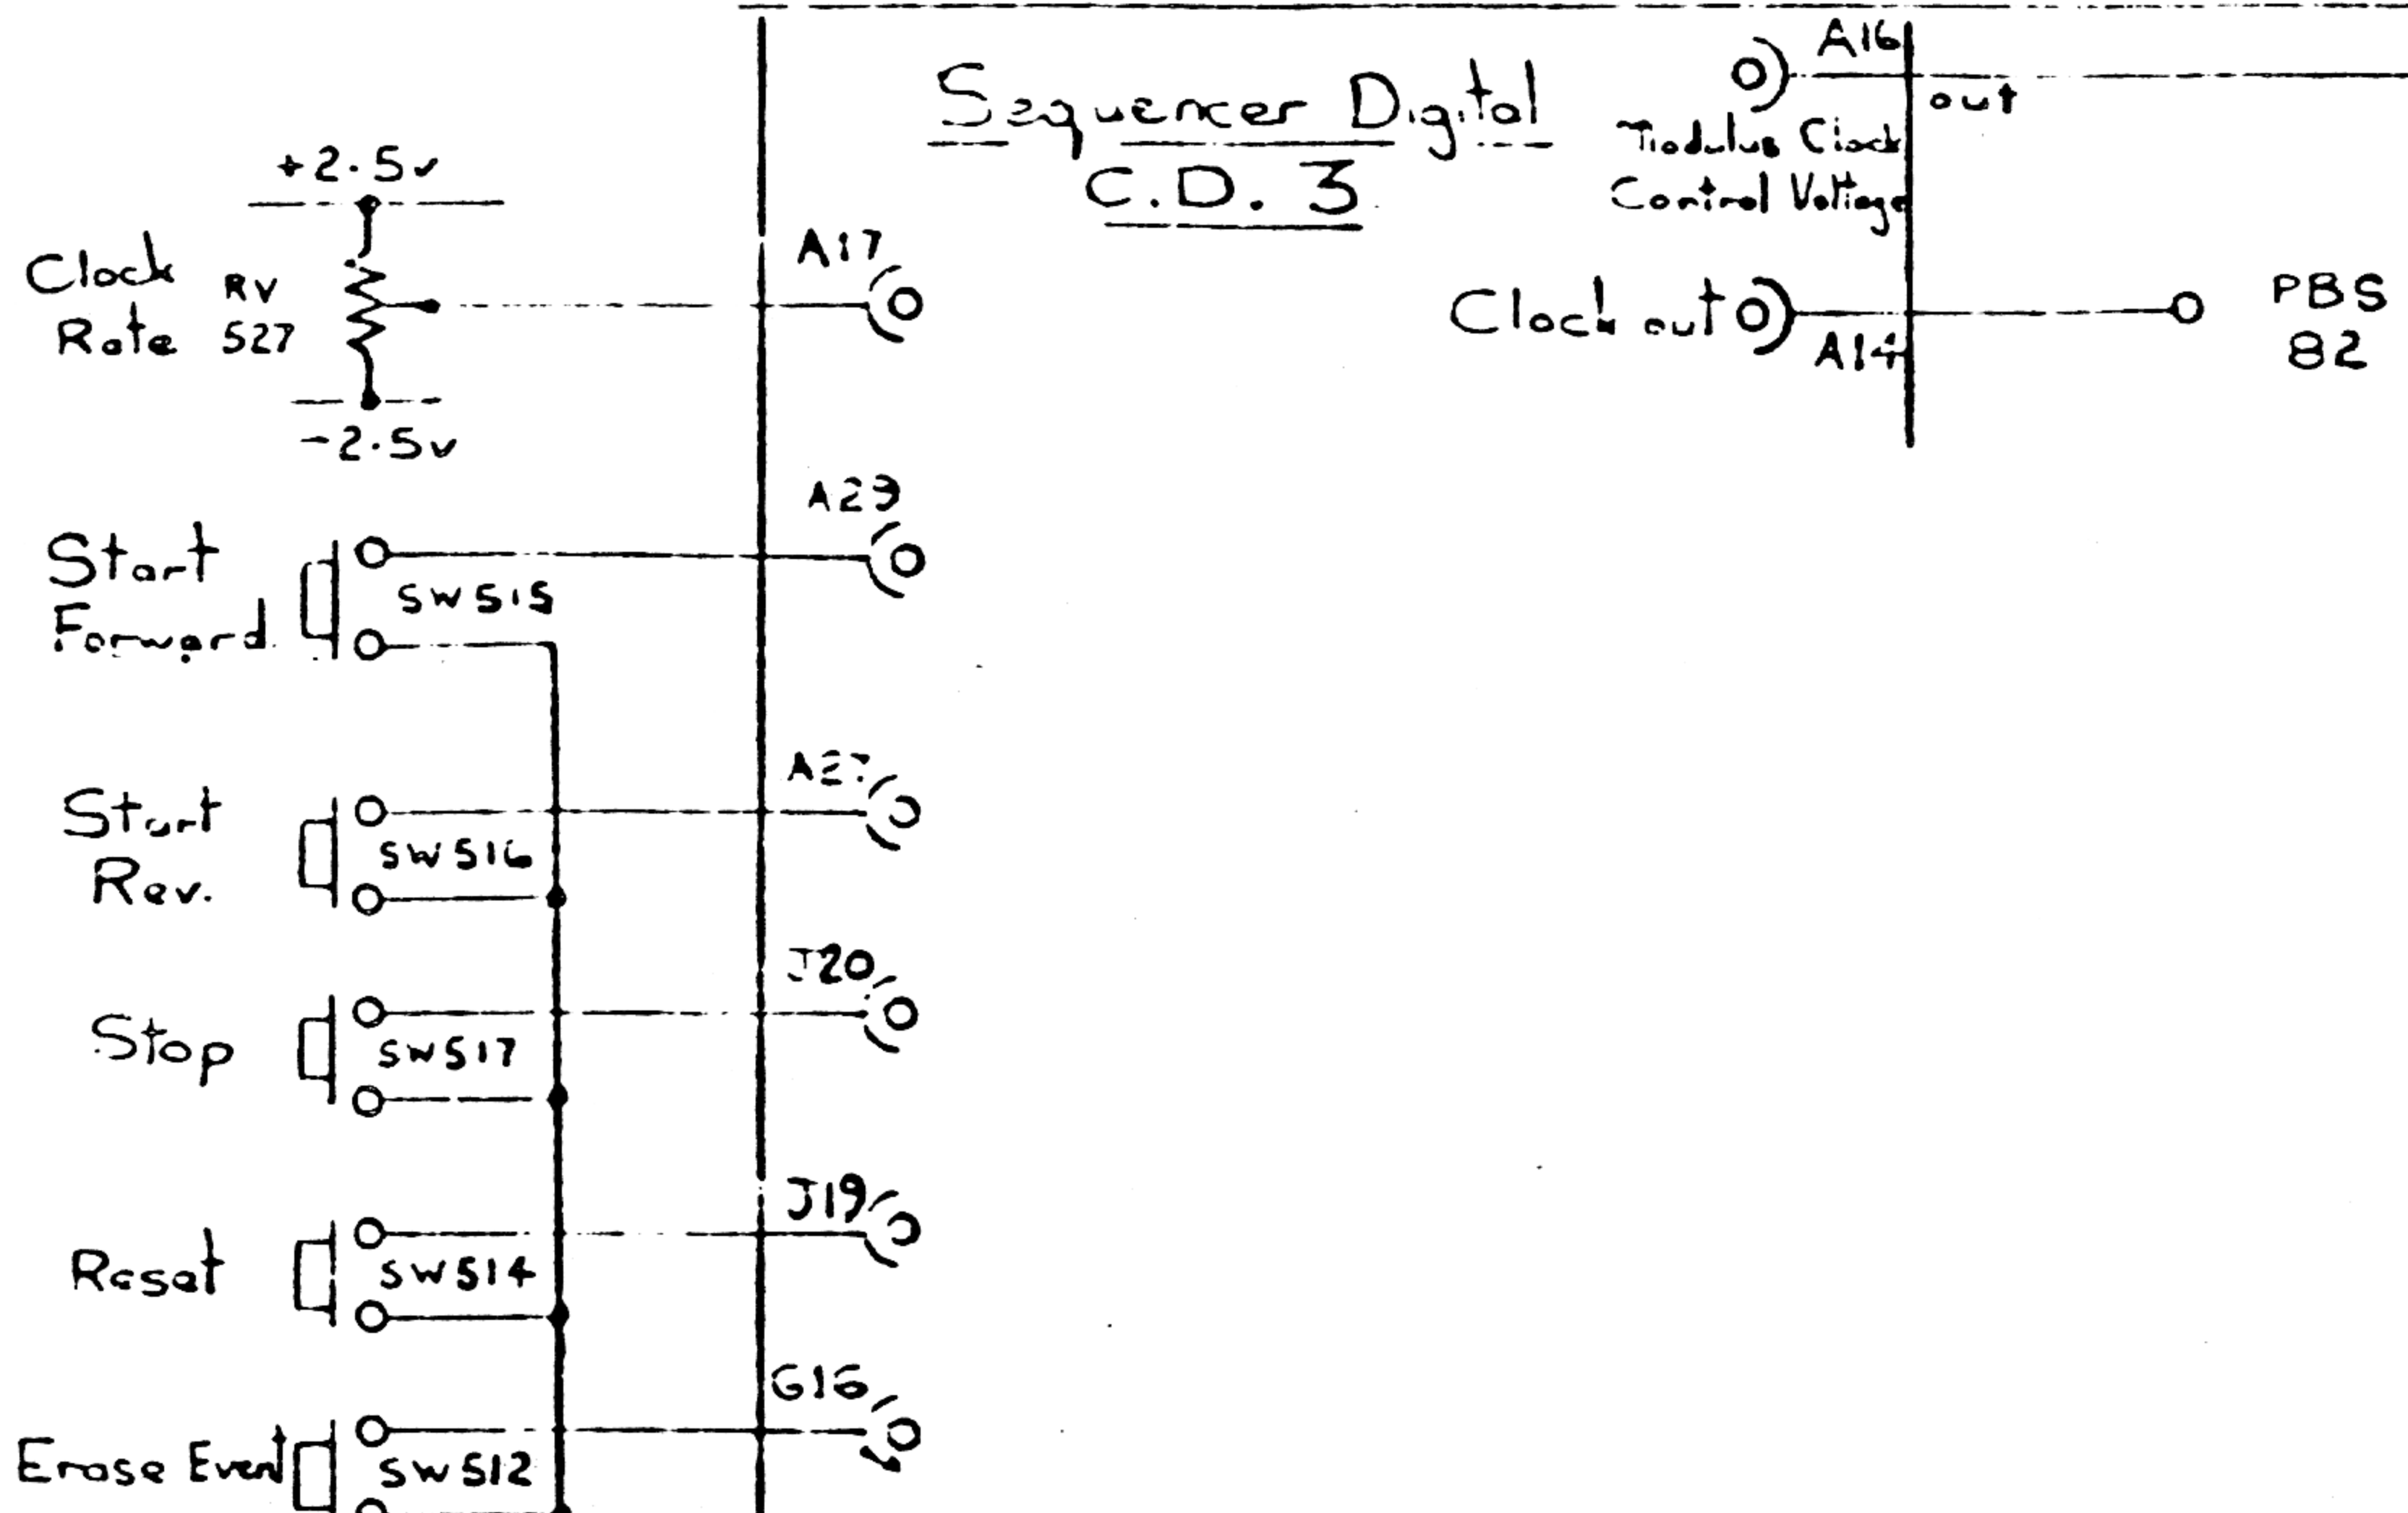


- PBC 56 ○ B15 ○ First parameter in (A,C,E)
- PBC 57 ○ B17 ○ Second parameter (B,D,F)
- PBC 58 ○ B13 ○ Key Voltage in.
- PBS 51 ○ J16 Clock in ○ J15-0v
- PBS 53 ○ J12 Remote Start ○ J11-0v
- PBS 54 ○ J14 Remote Stop ○ J13-0v
- PBS 52 ○ J18 Remote Reset ○ J17-0v

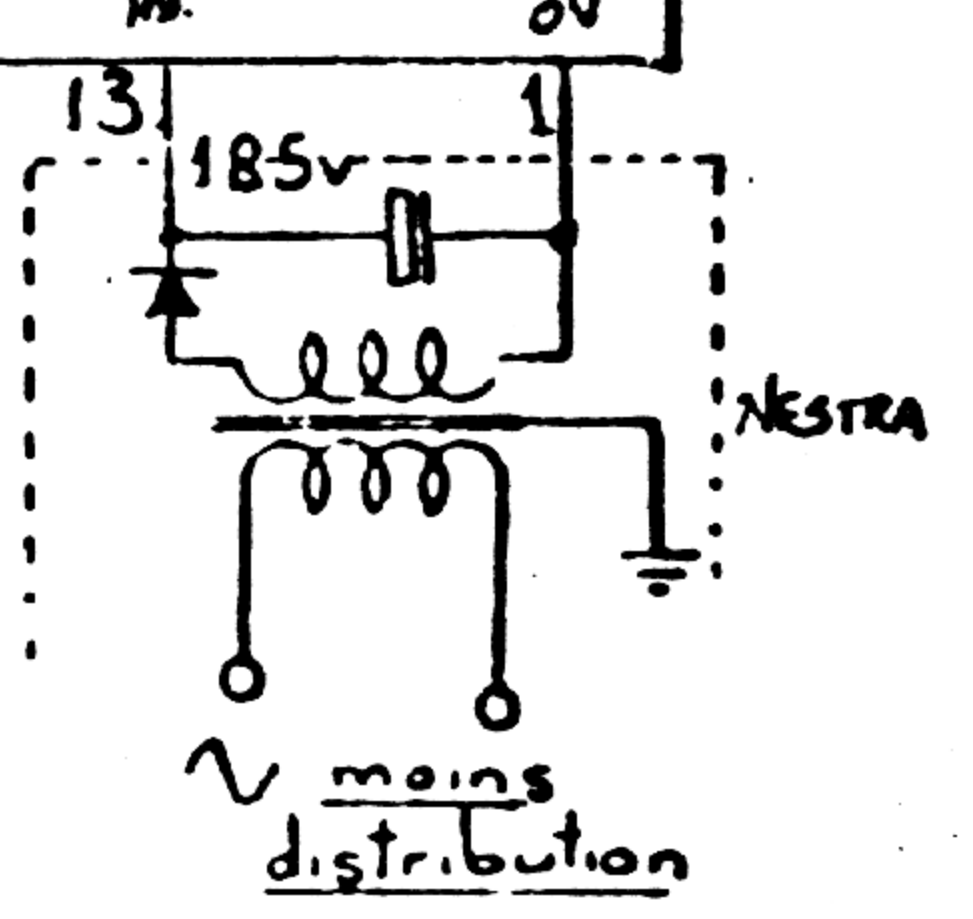

1.9.71
C1 added
B pin N° 34/19

ELECTRONIC MUSIC STUDIOS (Bournemouth) Ltd		issue A
YATL	TITLE MODULE WIRING SEQ.	Drq No
FINISH	USED ON SYNTHI 100	31/28
TC.	Angles	SCALE
DATE	DATE	DATE


B NOTE Added
 R113 - RY16-4-REV
 LPI-LP3 - 12V ADDN
 SW2 2-10-3W16-12V
 REV 130 27 29 REV.
 REV 129 22 24 REV.
 REV 138 17 17 REV.
 REV 136 12 14 REV.
 REV 144 7 9 REV.
 REV 143 2 3 REV.
 REV 145 1-16-11-16
 - REV. ON RY151
 C.M. 46 4/11/53

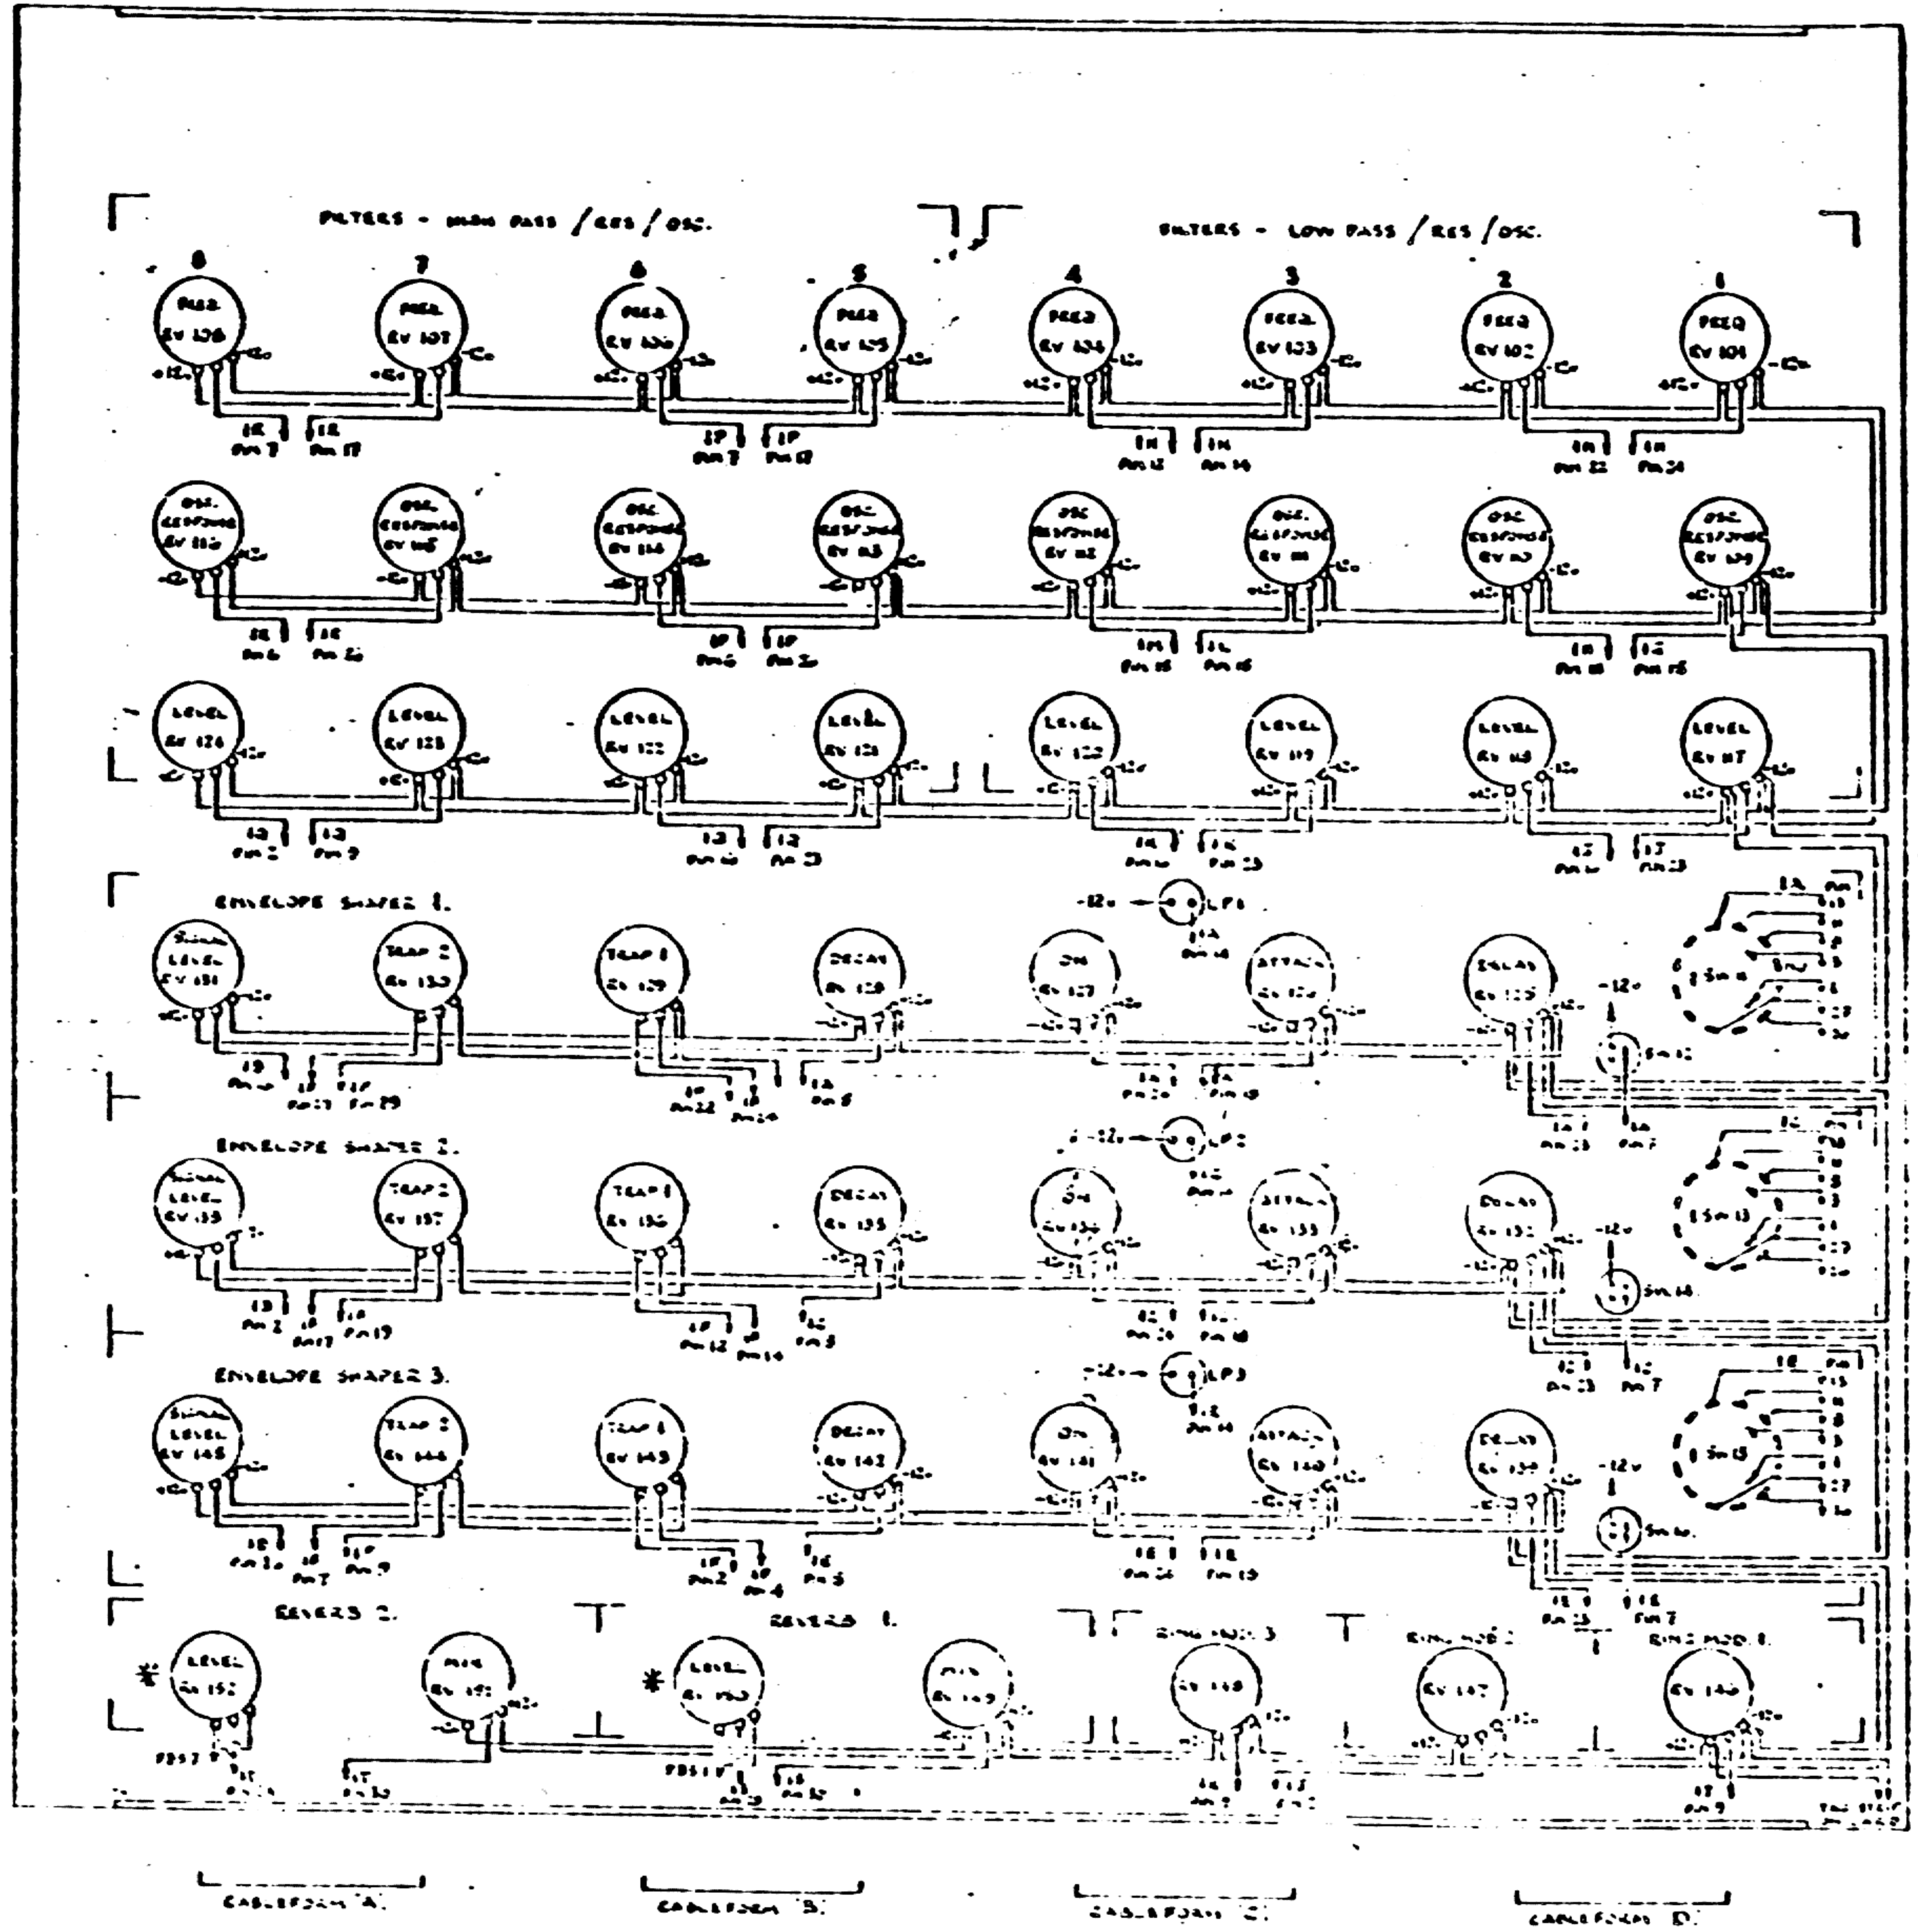

100
 200
 CABLES
 DASH WITH
 CABLEFOAM D.

ALL POTENTIOMETERS 10K LIN
 EXCEPT 2 POT WHICH ARE 5K LOG

B REEDED
 2V 527 pin 17 1.1 gts. p. 17
 2V 527 pin 25 - 4.7
 2V 523 pin 27 & 29 red.
 10 16 4 71
 C 527 pin 25 4.7
 2V 523 pin 27 & 29 red.


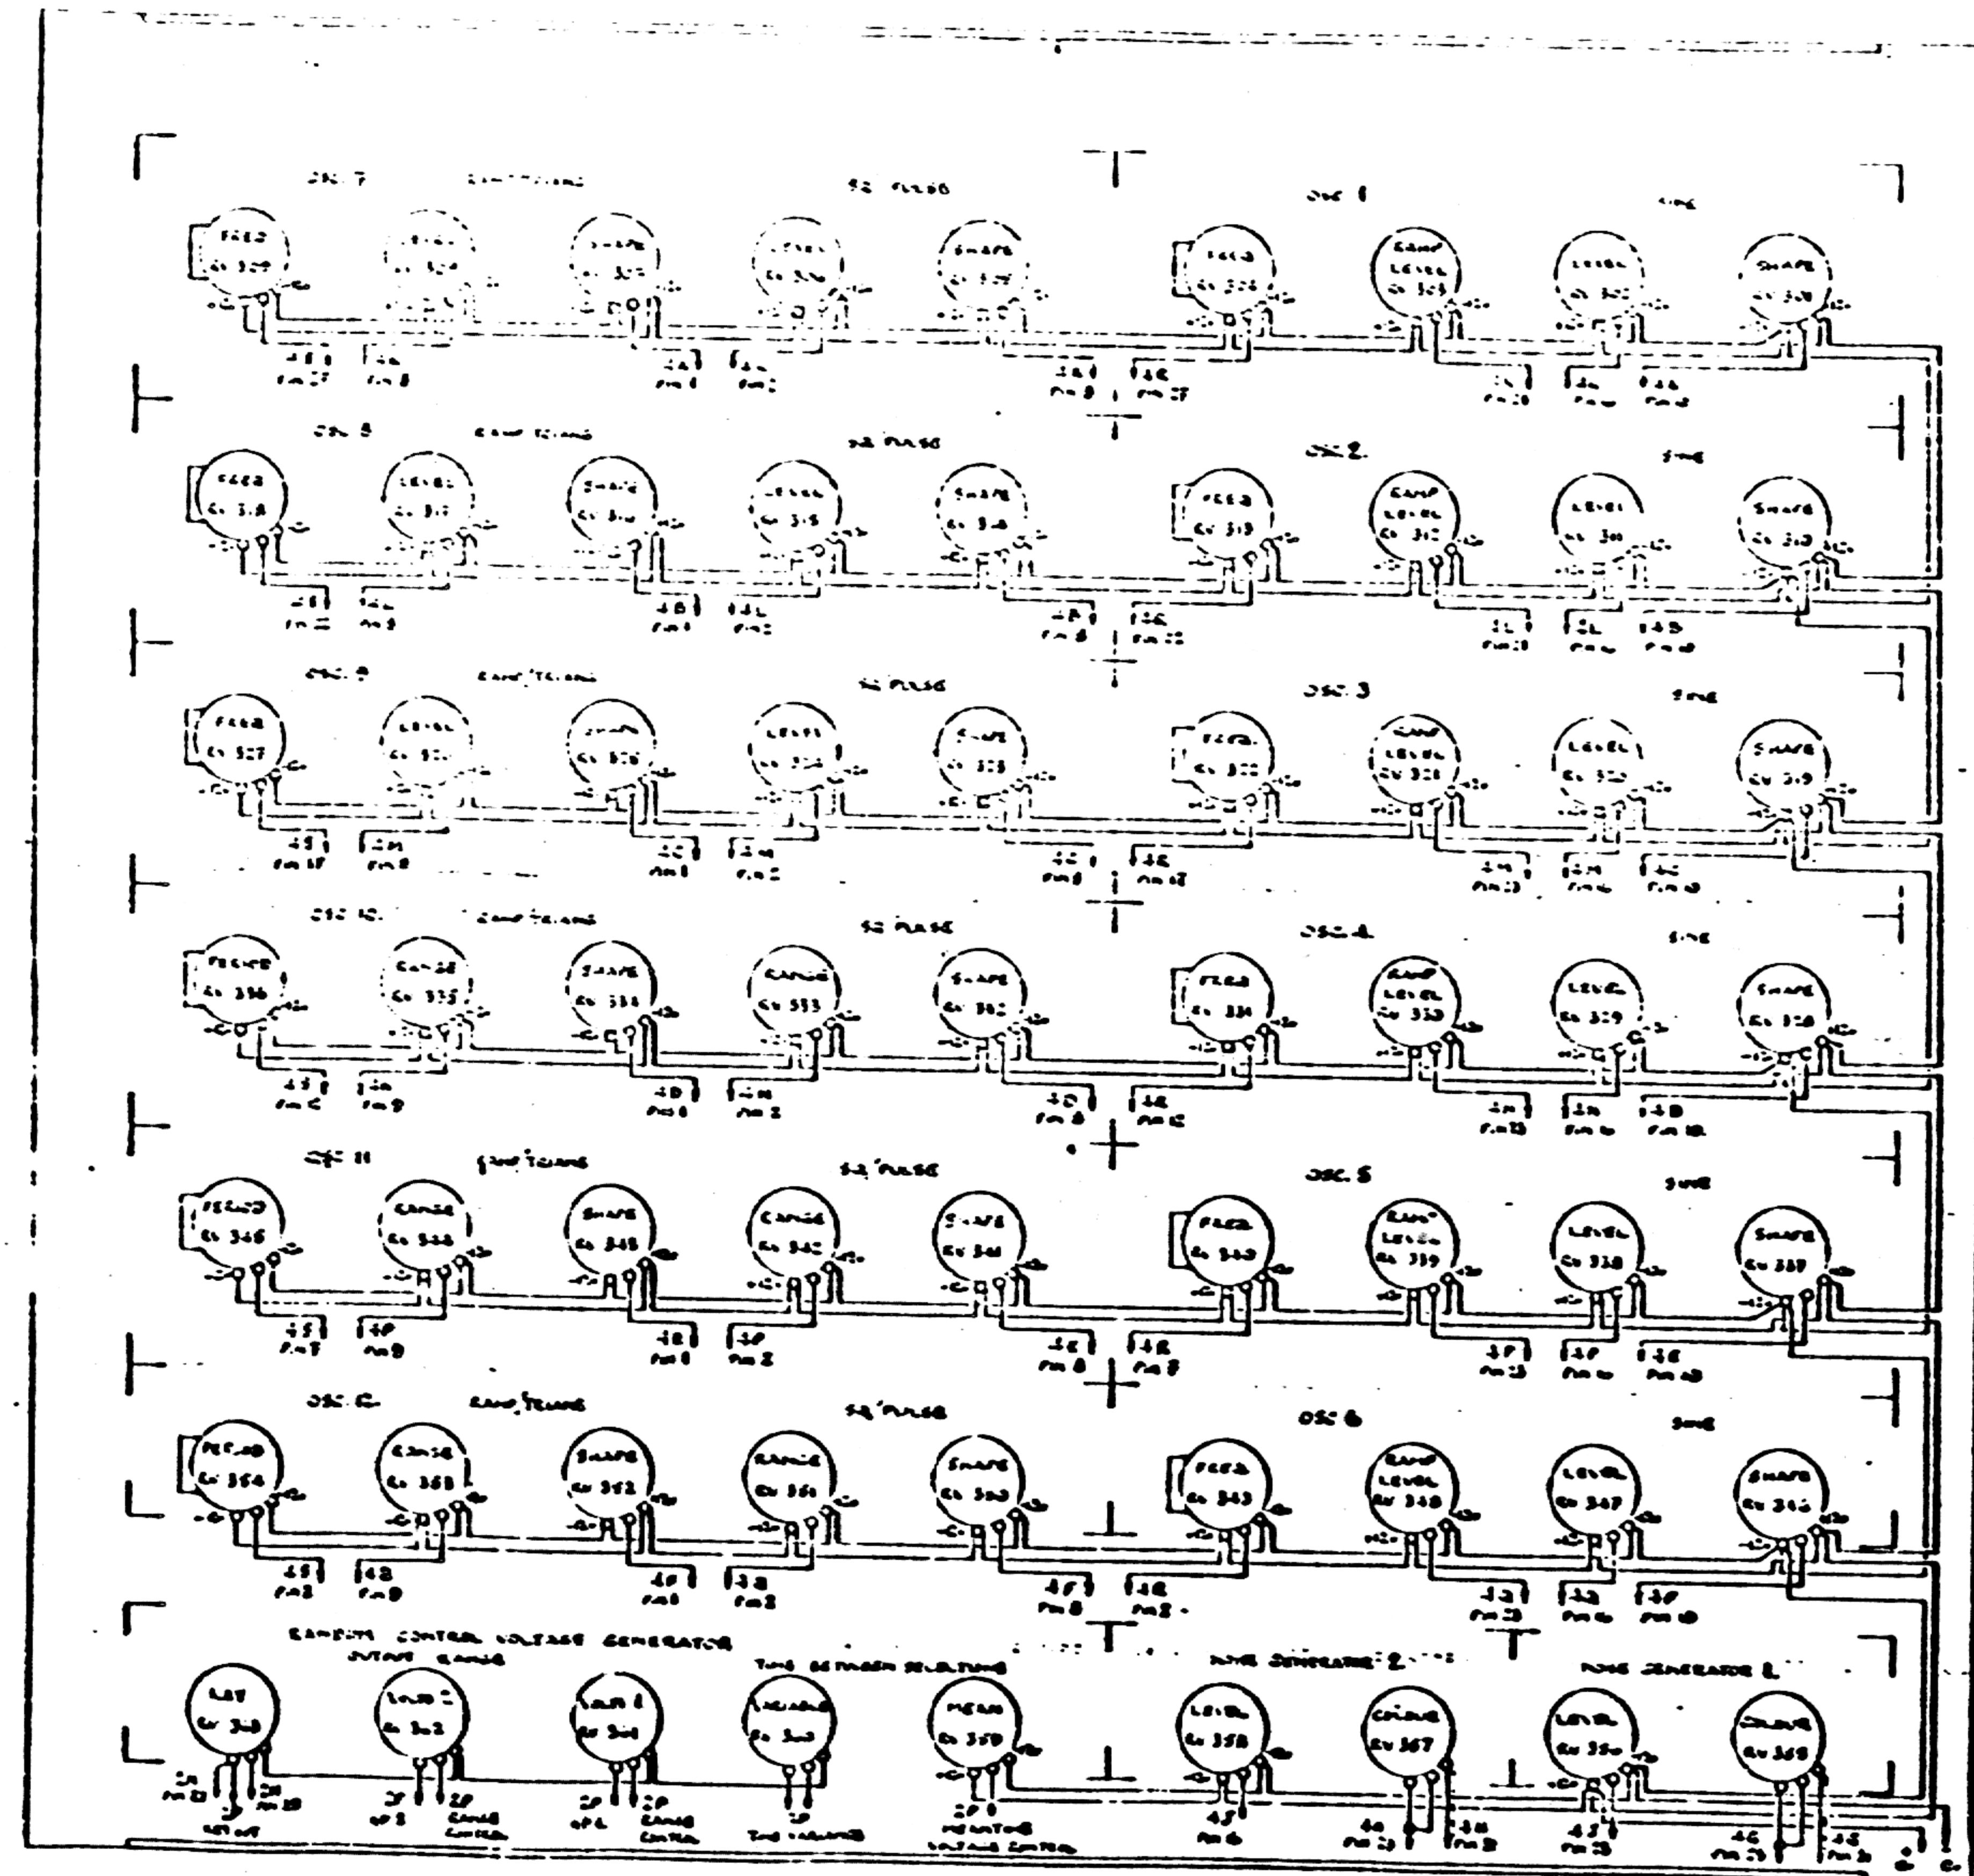


ALL POTENTIOMETERS 10K LI

THE STRAP MOUNTED ON CARD FRAME 4.


SCALE	1:1	PANEL THREE (C)
APP'D		REAR VIEW ASSEMBLY EMS 34.31.






E₁ additional No^s added
 M₁ 16.4.71
 C pot values rev to meters & switches
 made - M₁ 25.6.71.
 D SW401 to SW408 turned through
 90° 22.8.71
 E SW409, SW410 did not come
 M₁ 23.8.71
 F Pot No^s added M₁ 27.11

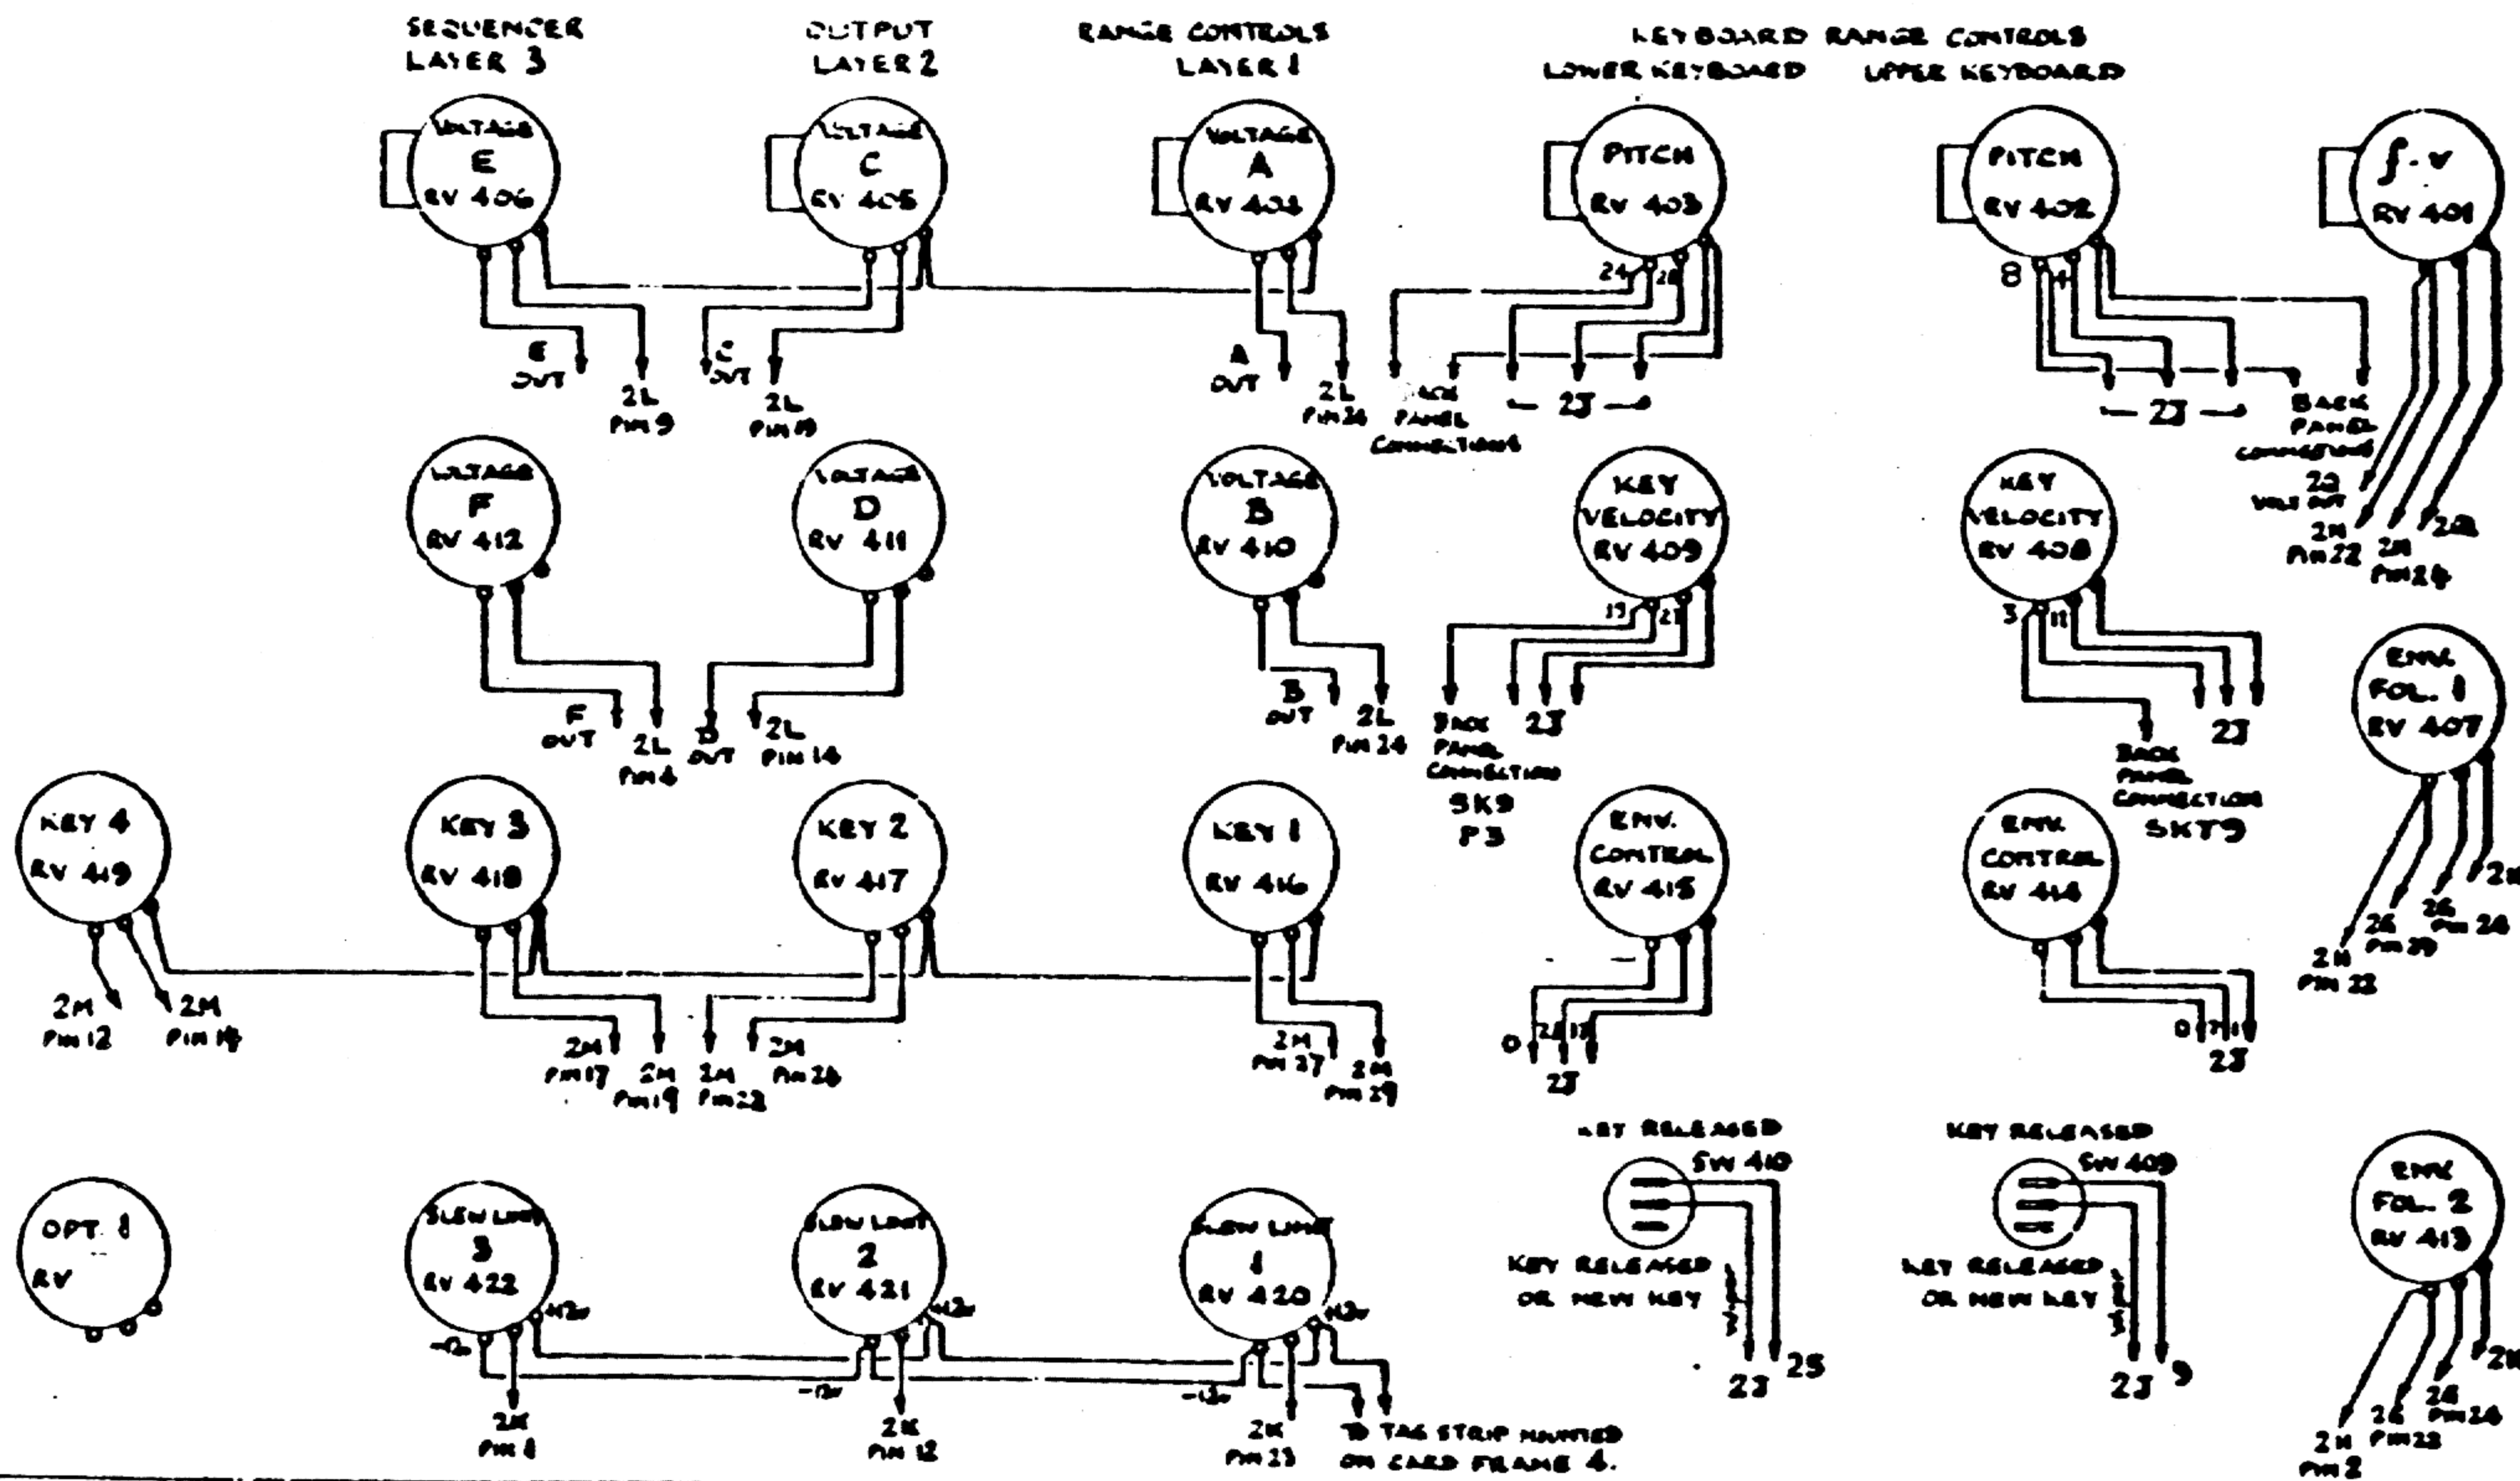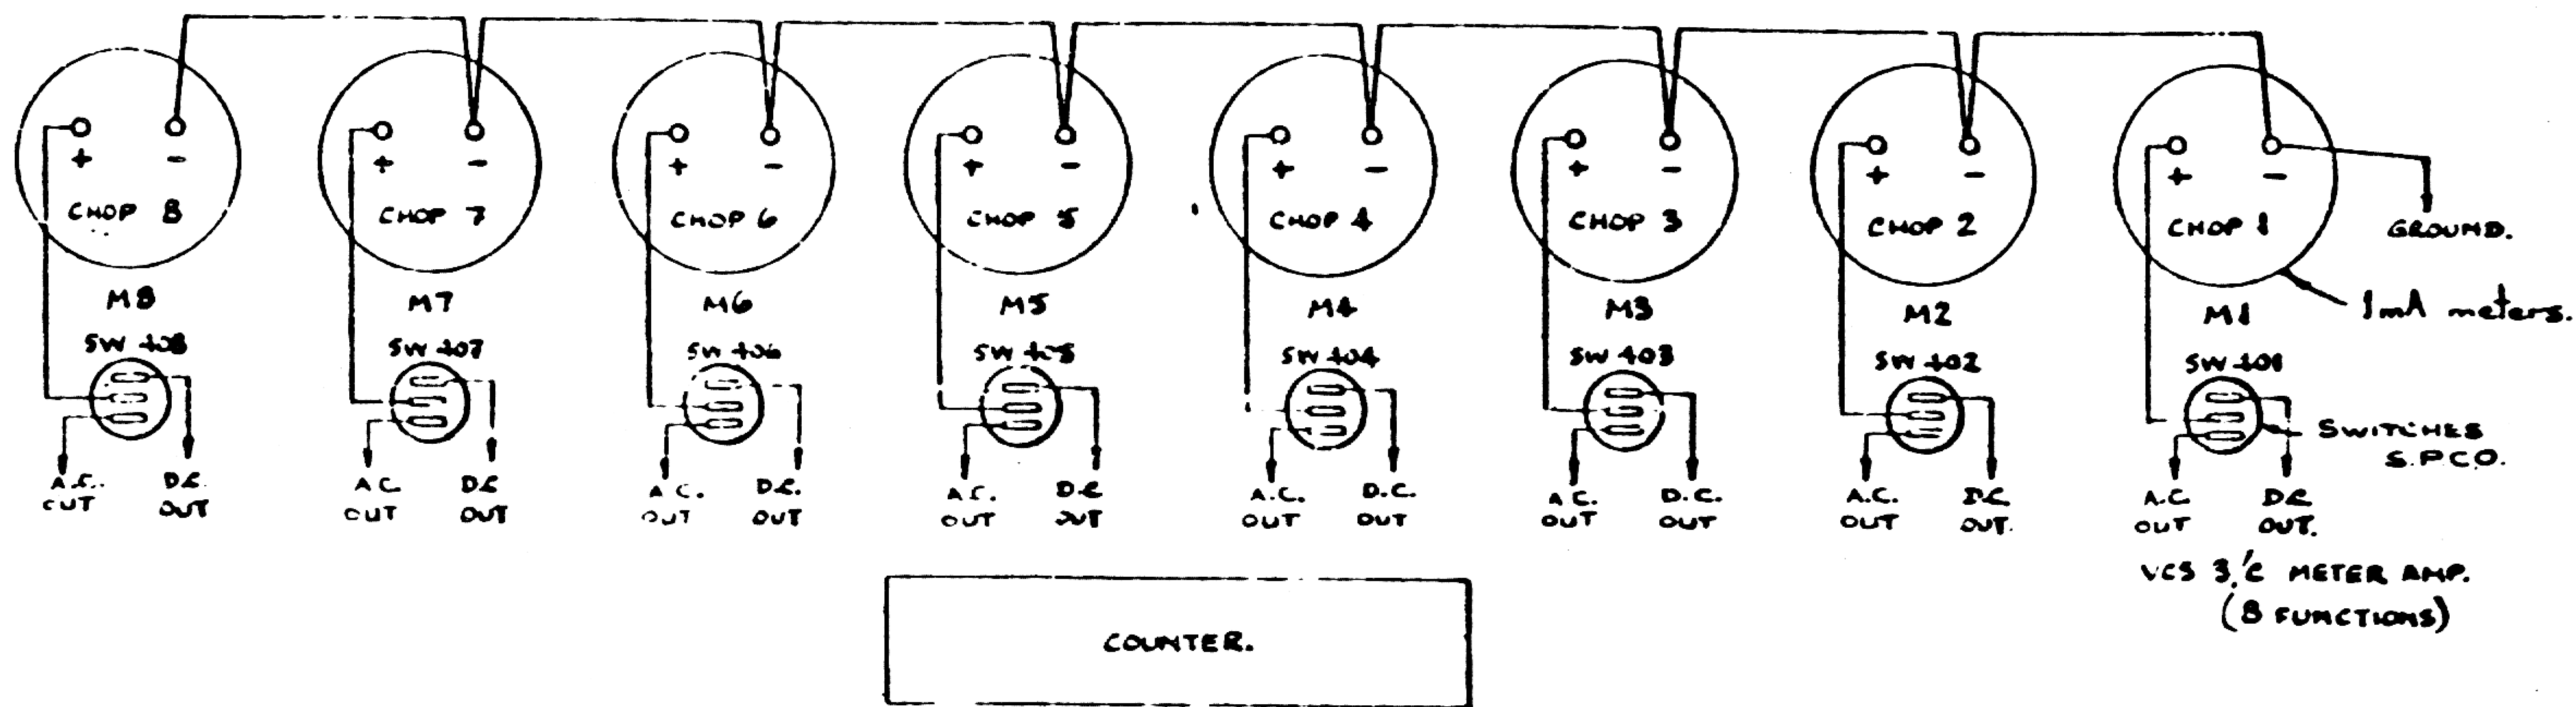

ALL POTENTIOMETERS 10K LIN.

B. Further Detail
 Added H1, 2 5.71
 C. + - to joystick
 was reversed
 not wiring corrected
 SW612 d. d. read SW613.
 D. H17, H19 rev. SW612
 H16, H18 rev.
 26. 7. 71
 E. Note on joystick added
 26. 7. 71
 F. SW627 Club Rule Knob
 p. 15 & p. 20 rev.
 26. 8. 71

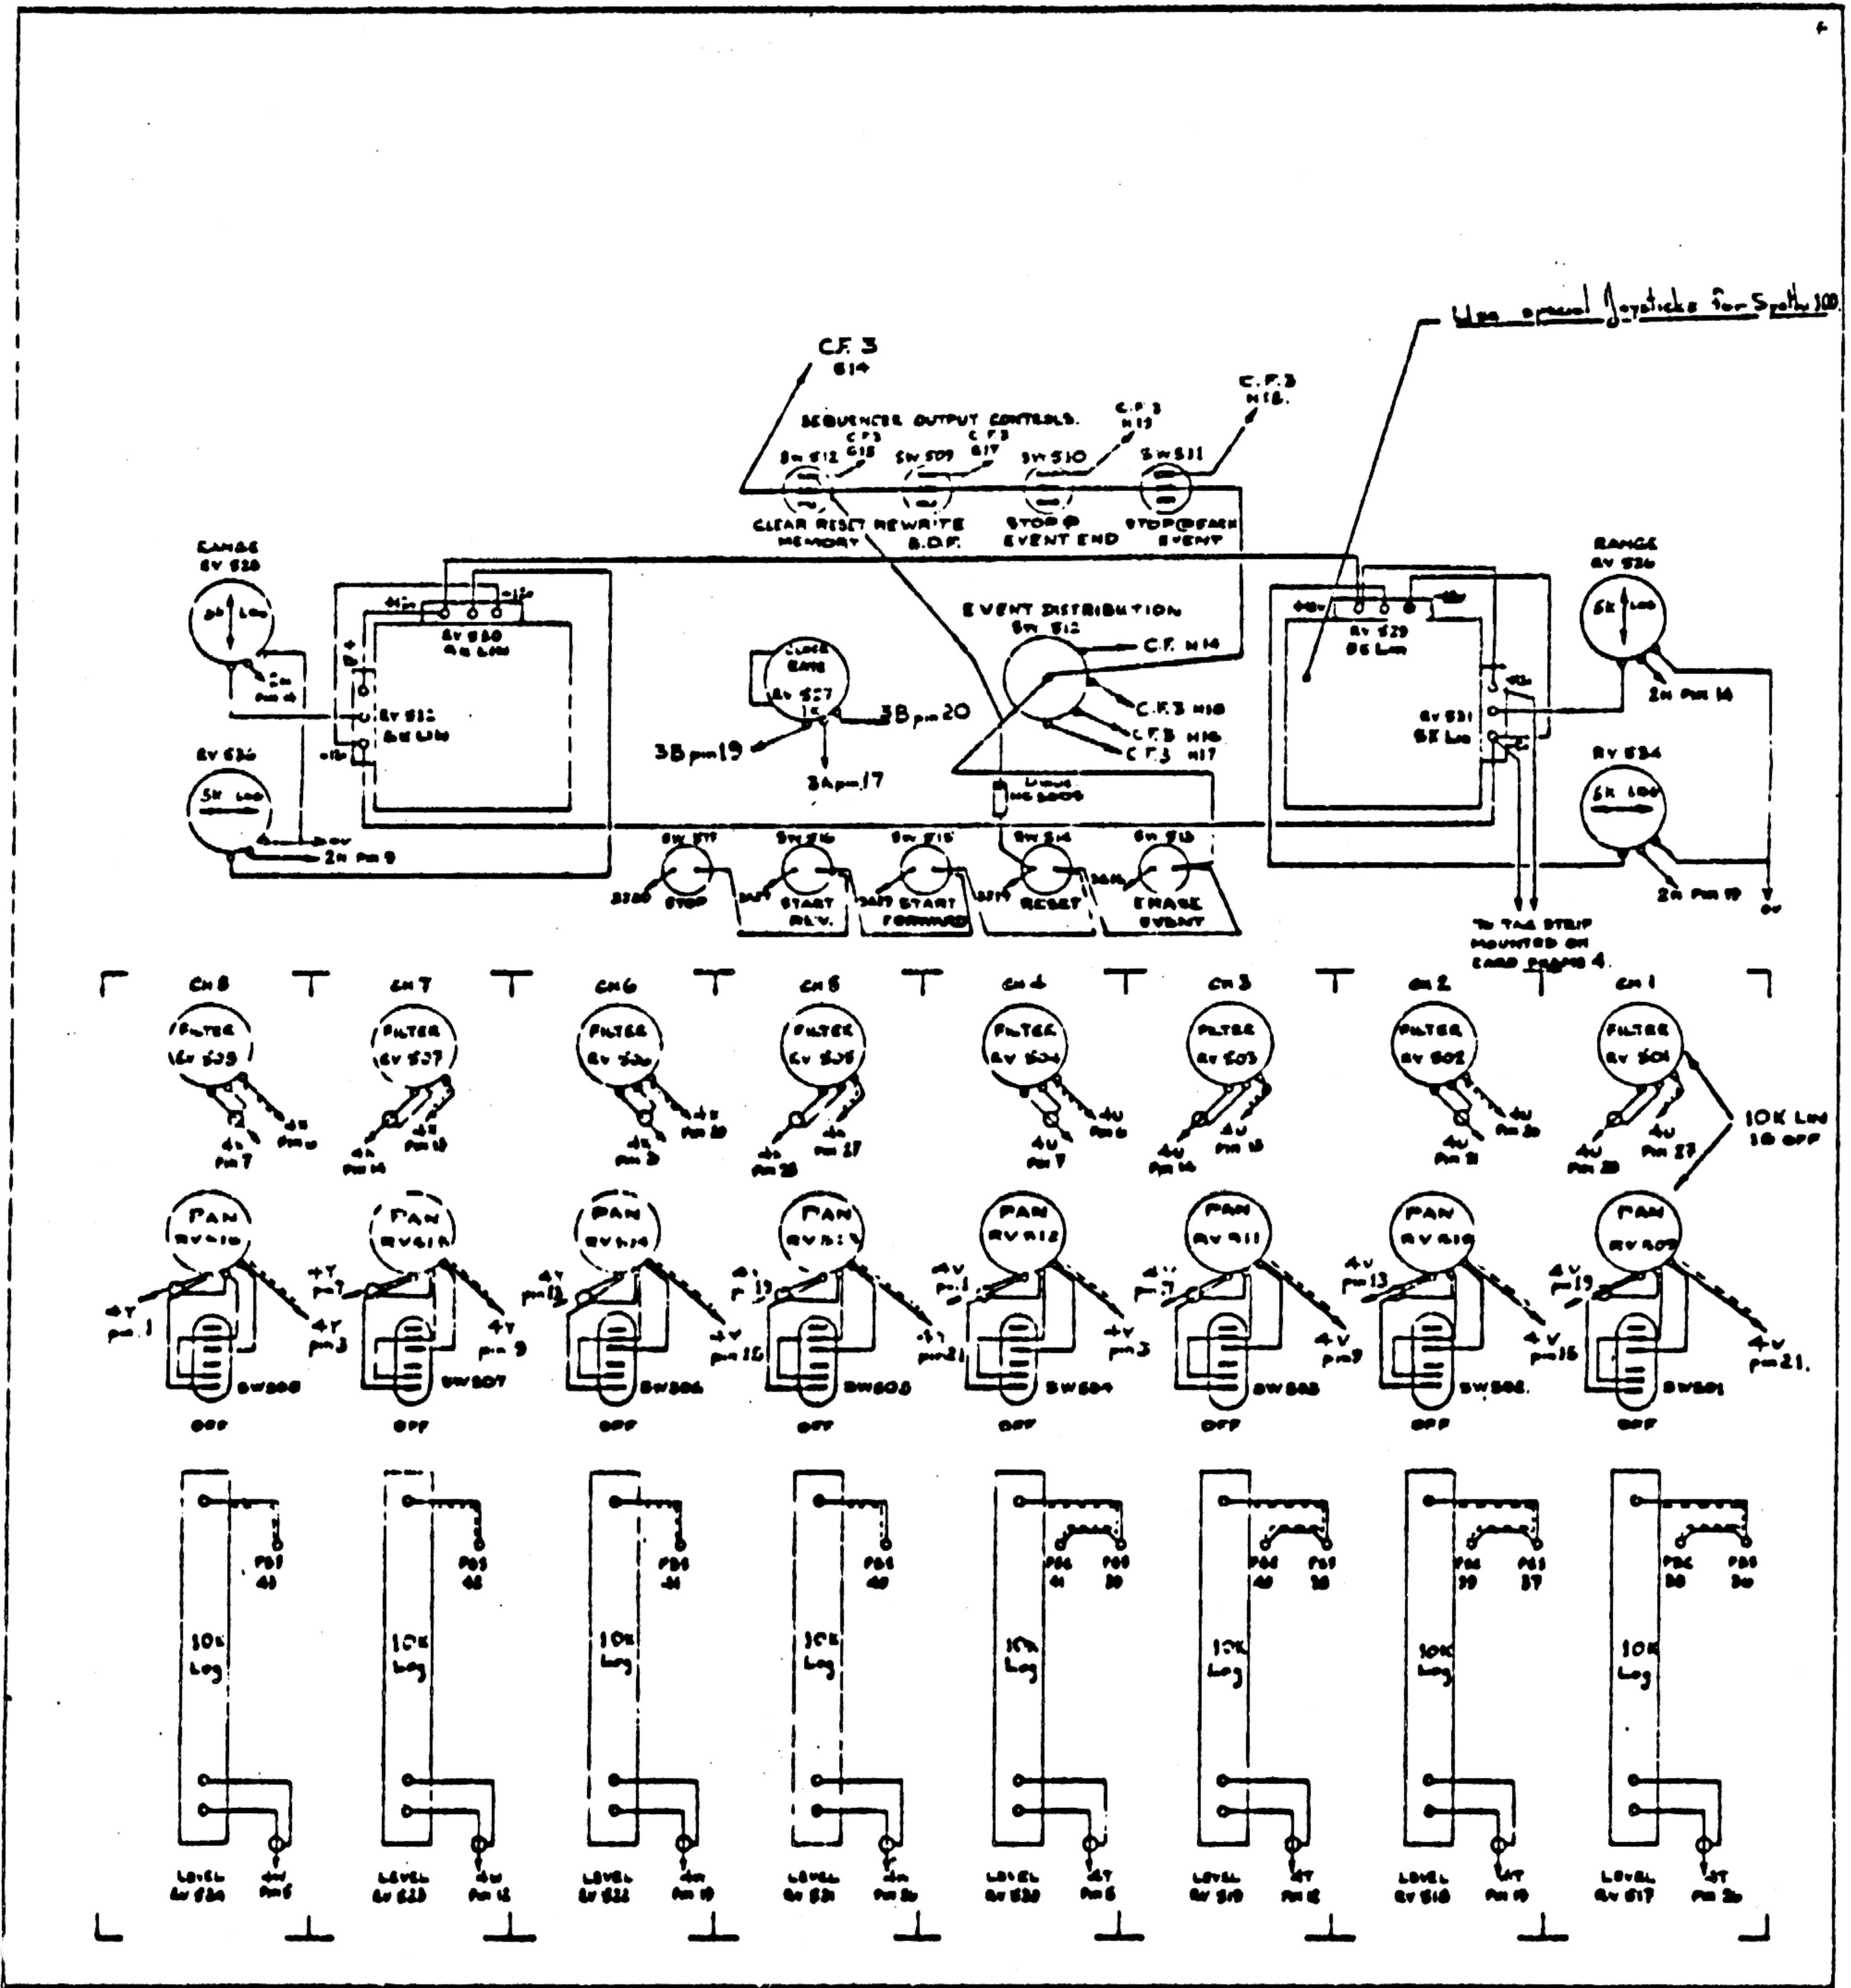

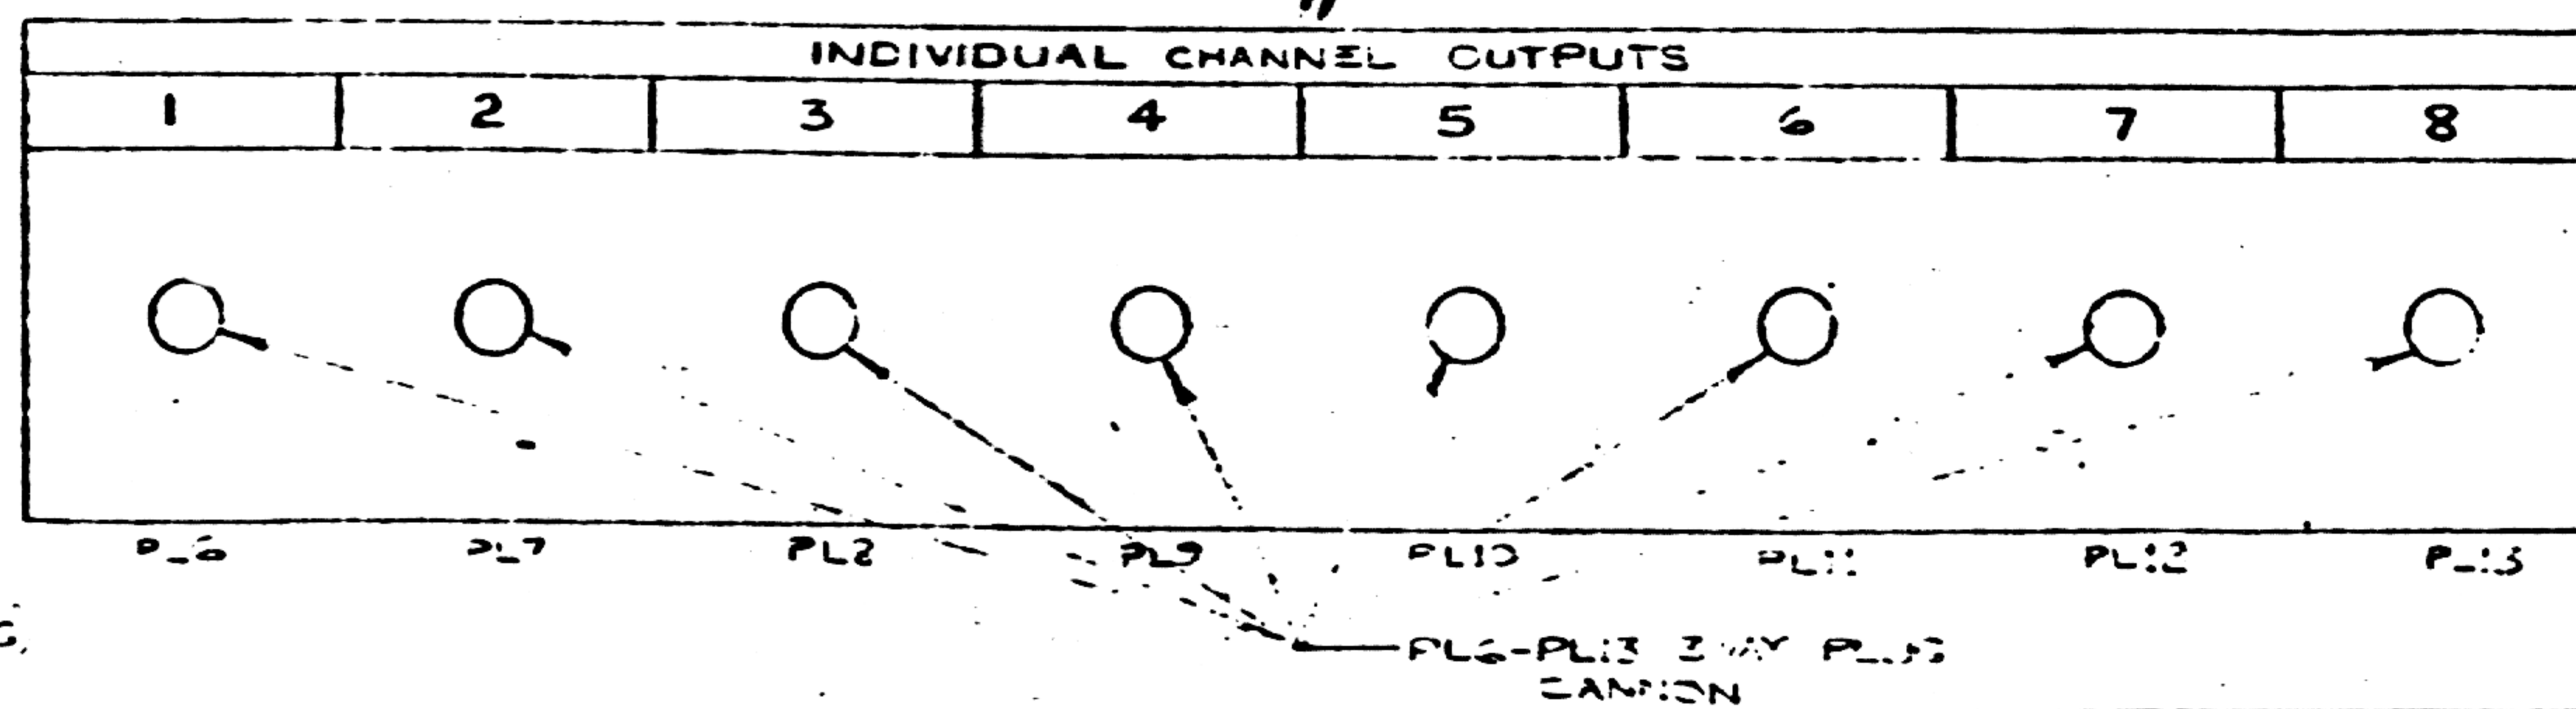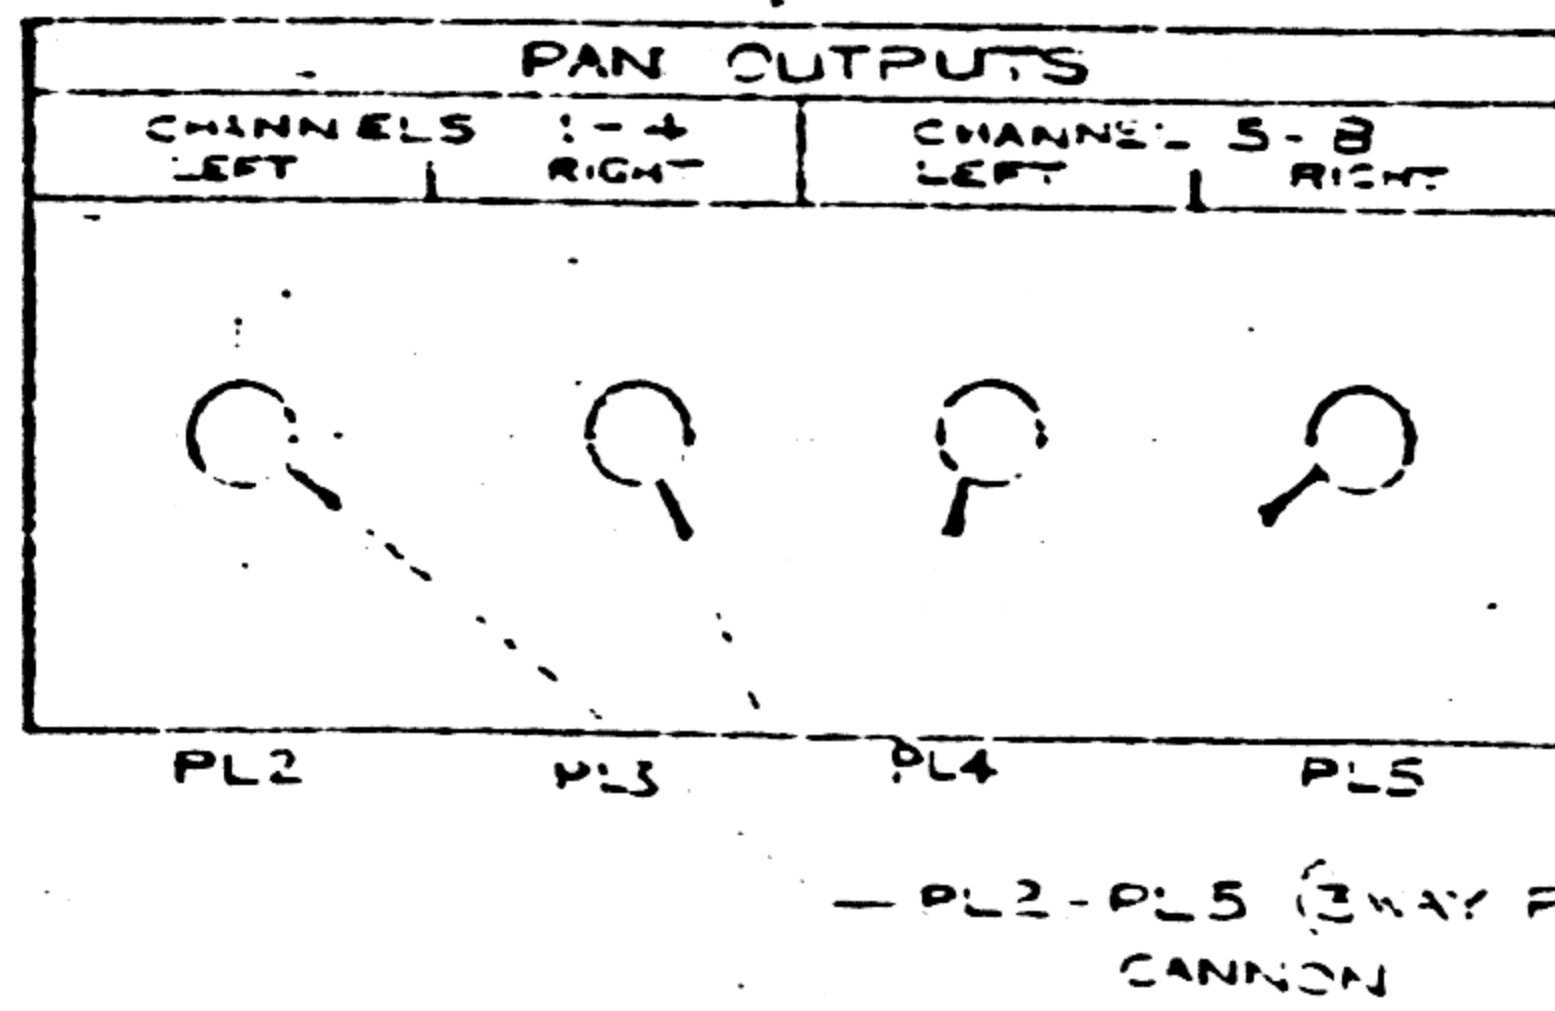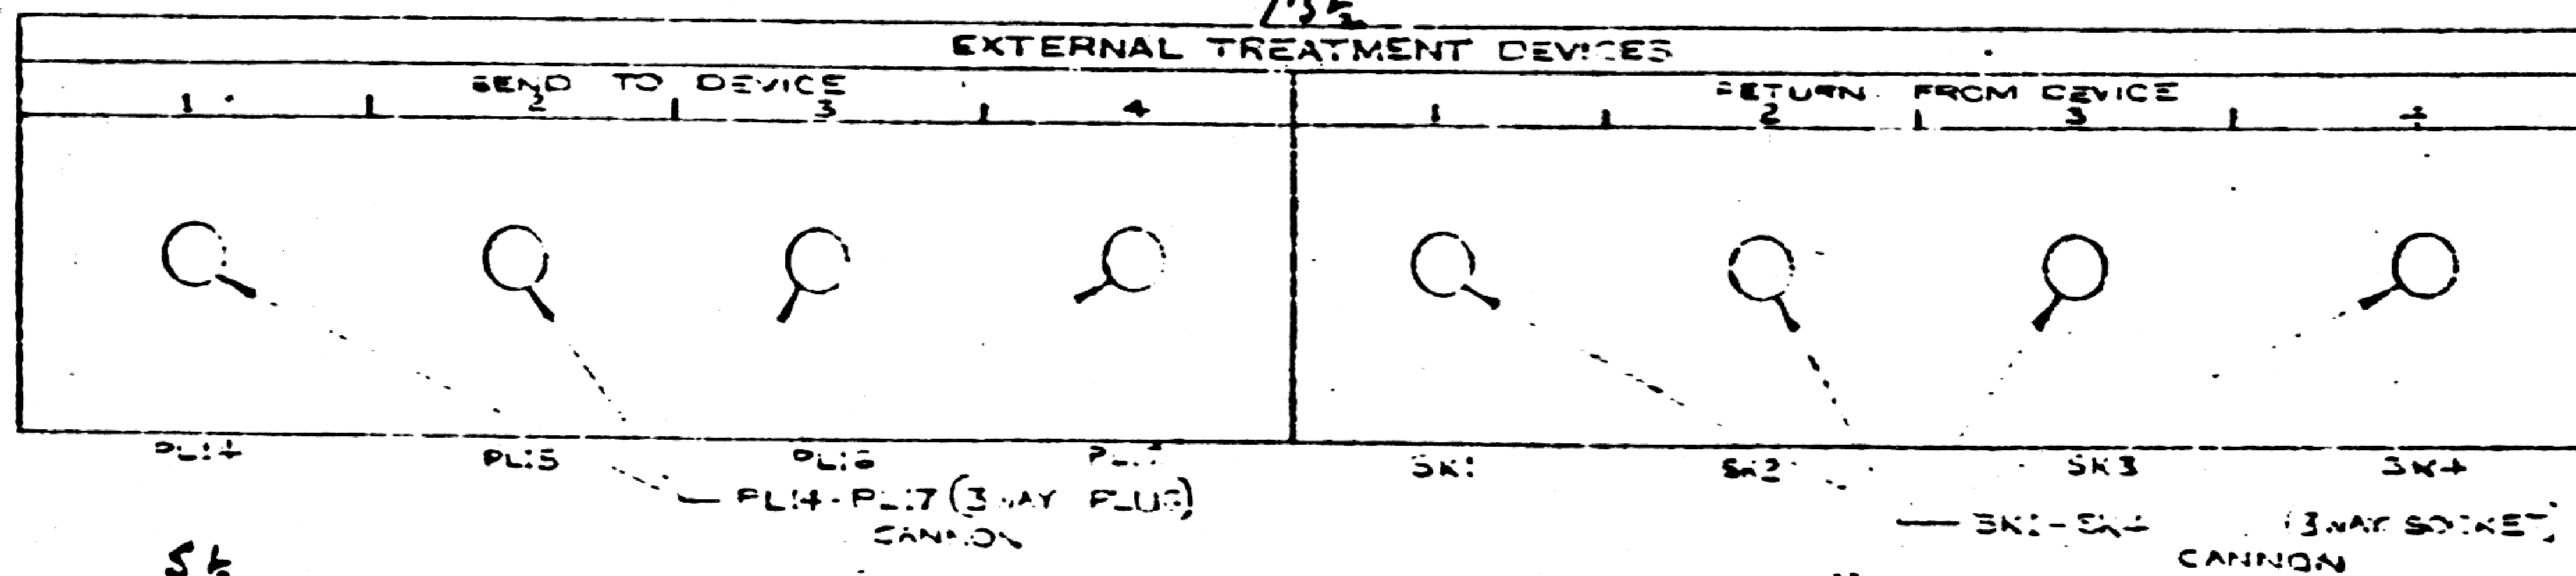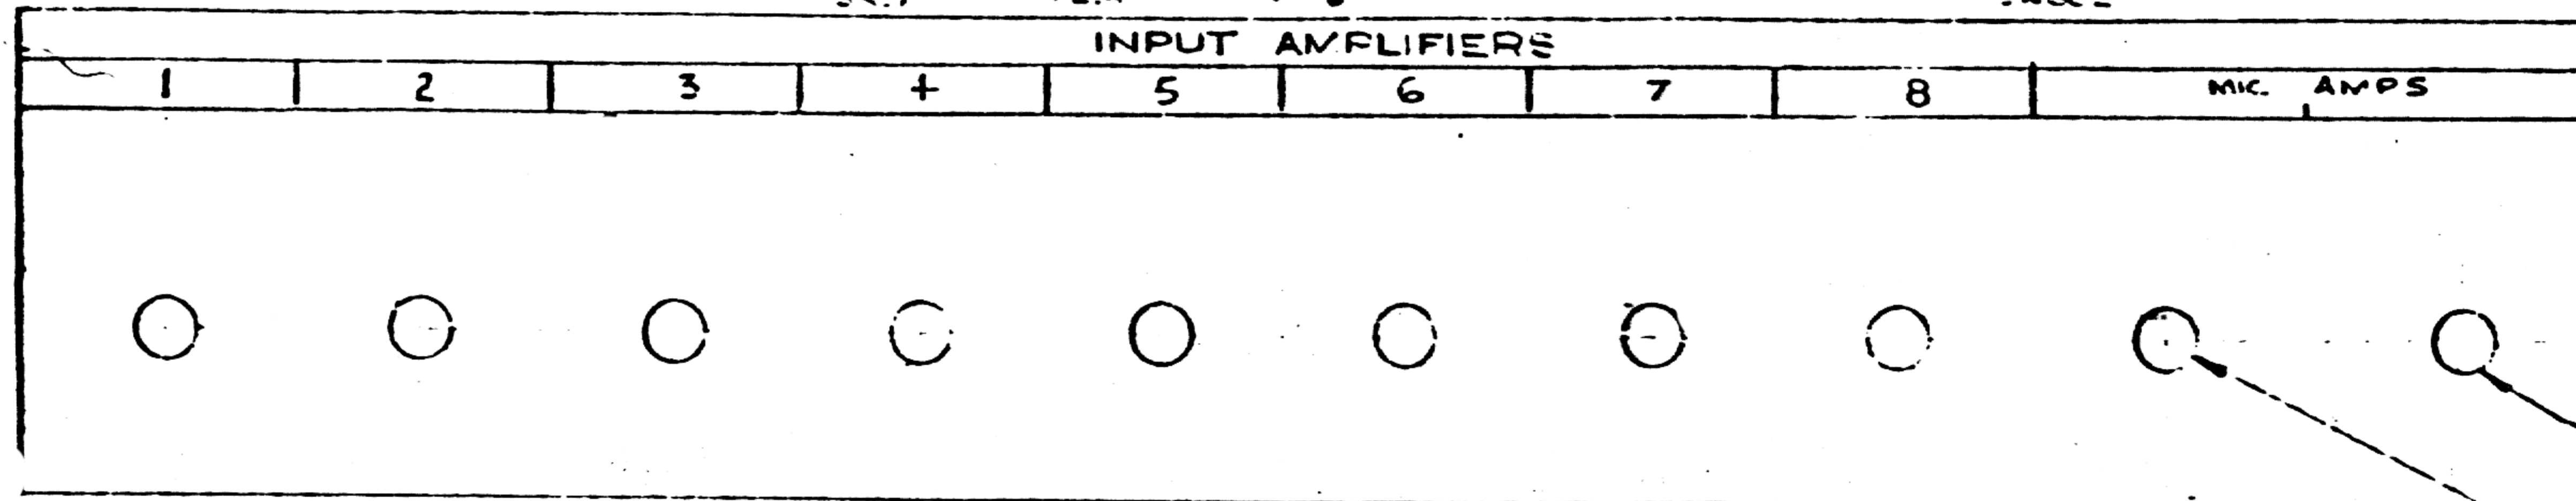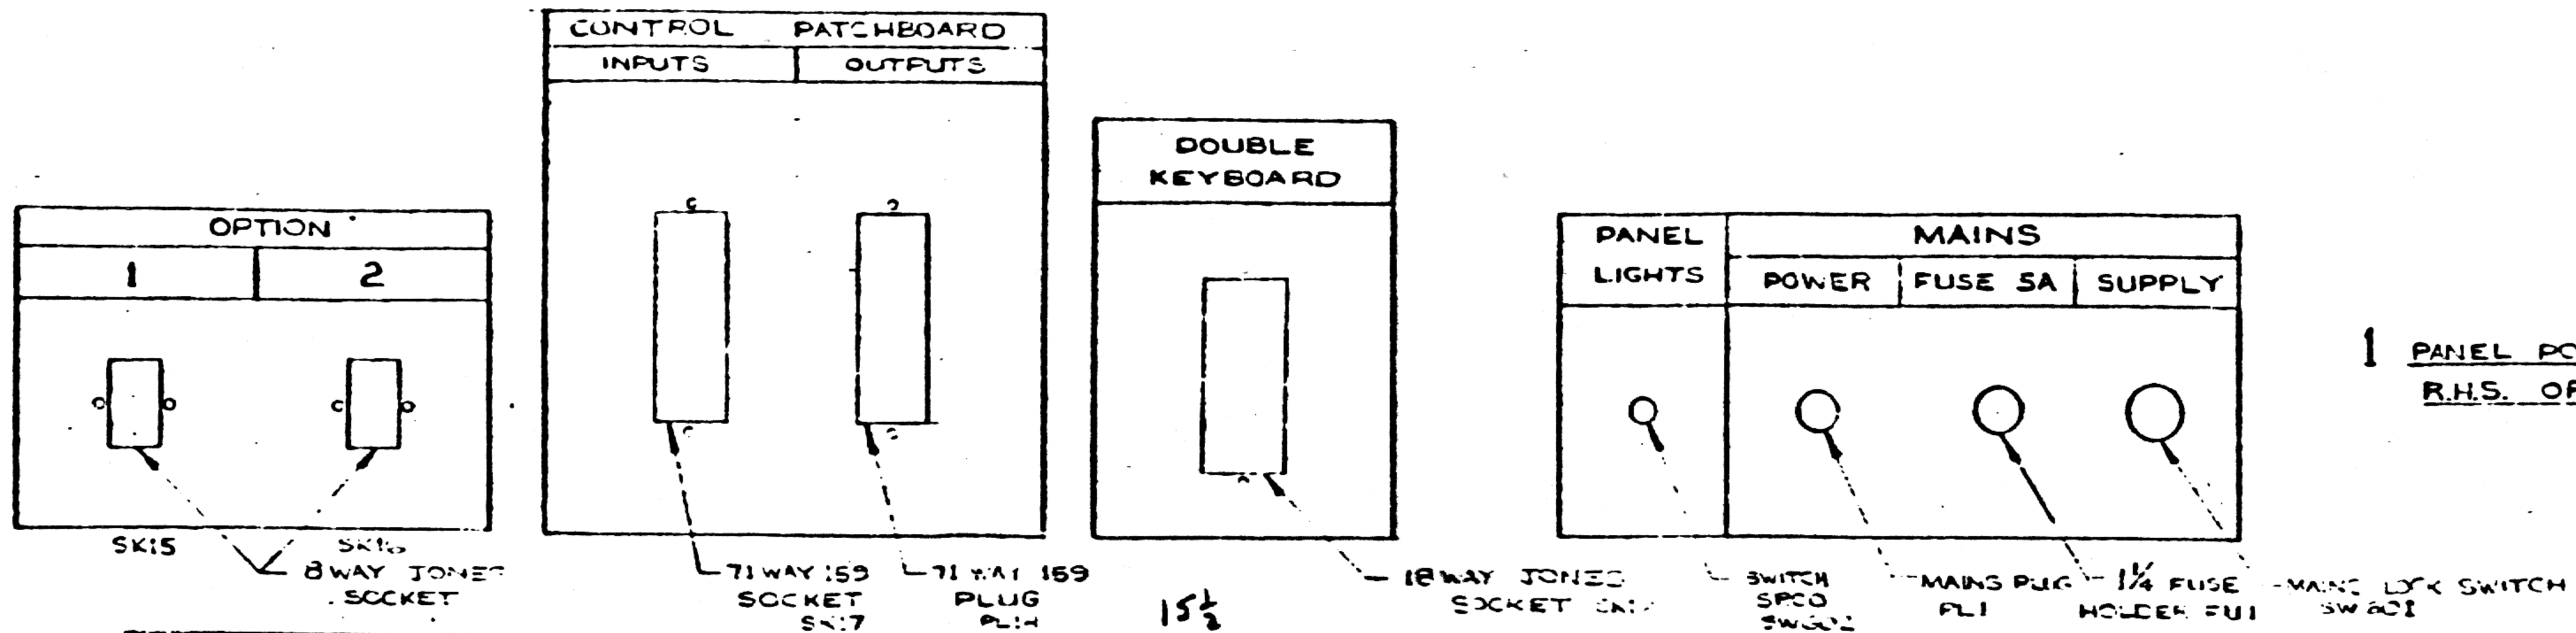

ELECTRONIC MUSIC STUDIOS (Bournemouth) Ltd				Issue				
MATL	/	TITLE INTERFACE PANEL		Drp No				
FINISH	/	USED ON SYNTHI 100		31/34				
TOL	FRG	DRG	ANJ	SCALE	CHRD	DATE	DRN	DATE

C. M. Comp. Ltd
 Add: J. P. 24/4
 B.P. 24/4
 20/72

